
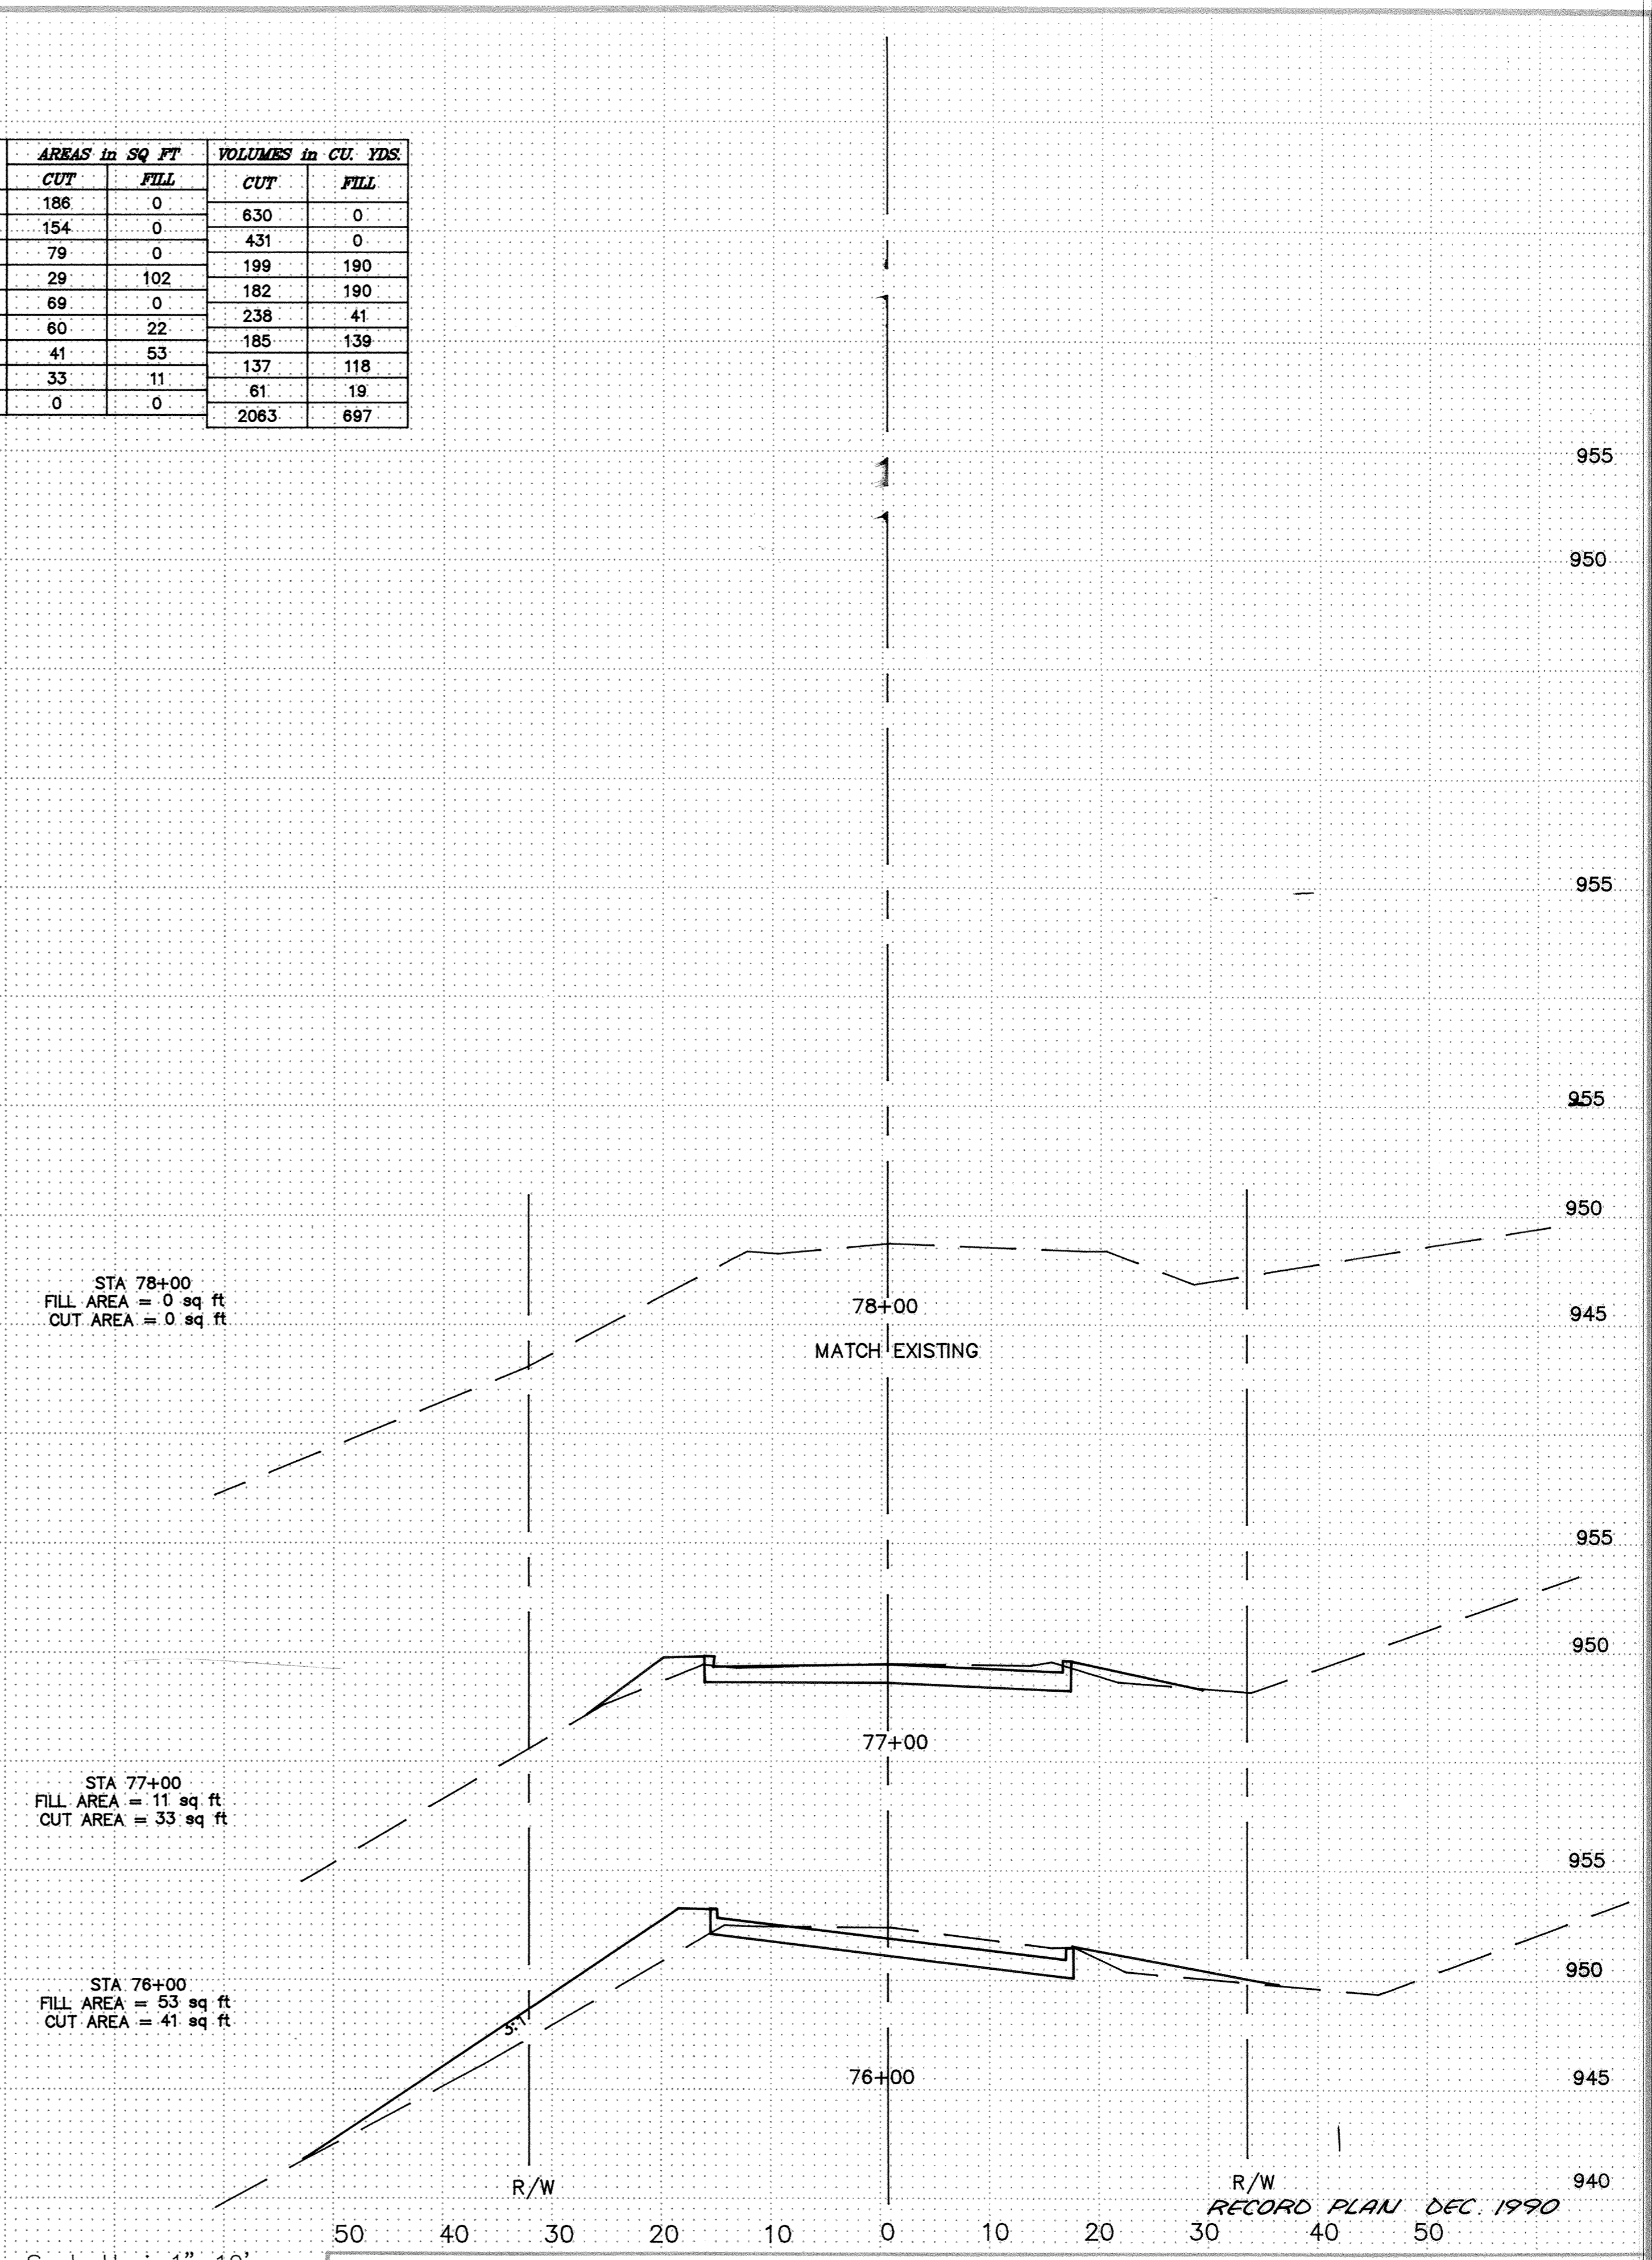


SAICO PRODUCTS • NEW HOPE, MINNESOTA
REORDER BY PART NUMBER 9592
SAICO PRODUCTS • NEW HOPE, MINNESOTA
REORDER BY PART NUMBER 9592
SAICO PRODUCTS • NEW HOPE, MINNESOTA
REORDER BY PART NUMBER 9592
SAICO PRODUCTS • NEW HOPE, MINNESOTA
REORDER BY PART NUMBER 9592

STATION	AREAS in SQ FT		VOLUMES in CU. YDS.	
	CUT	FILL	CUT	FILL
70+00	186	0	630	0
71+00	154	0	431	0
72+00	79	0	199	190
73+00	29	102	182	190
74+00	69	0	238	41
75+00	60	22	185	139
76+00	41	53	137	118
77+00	33	11	61	19
78+00	0	0	2063	697

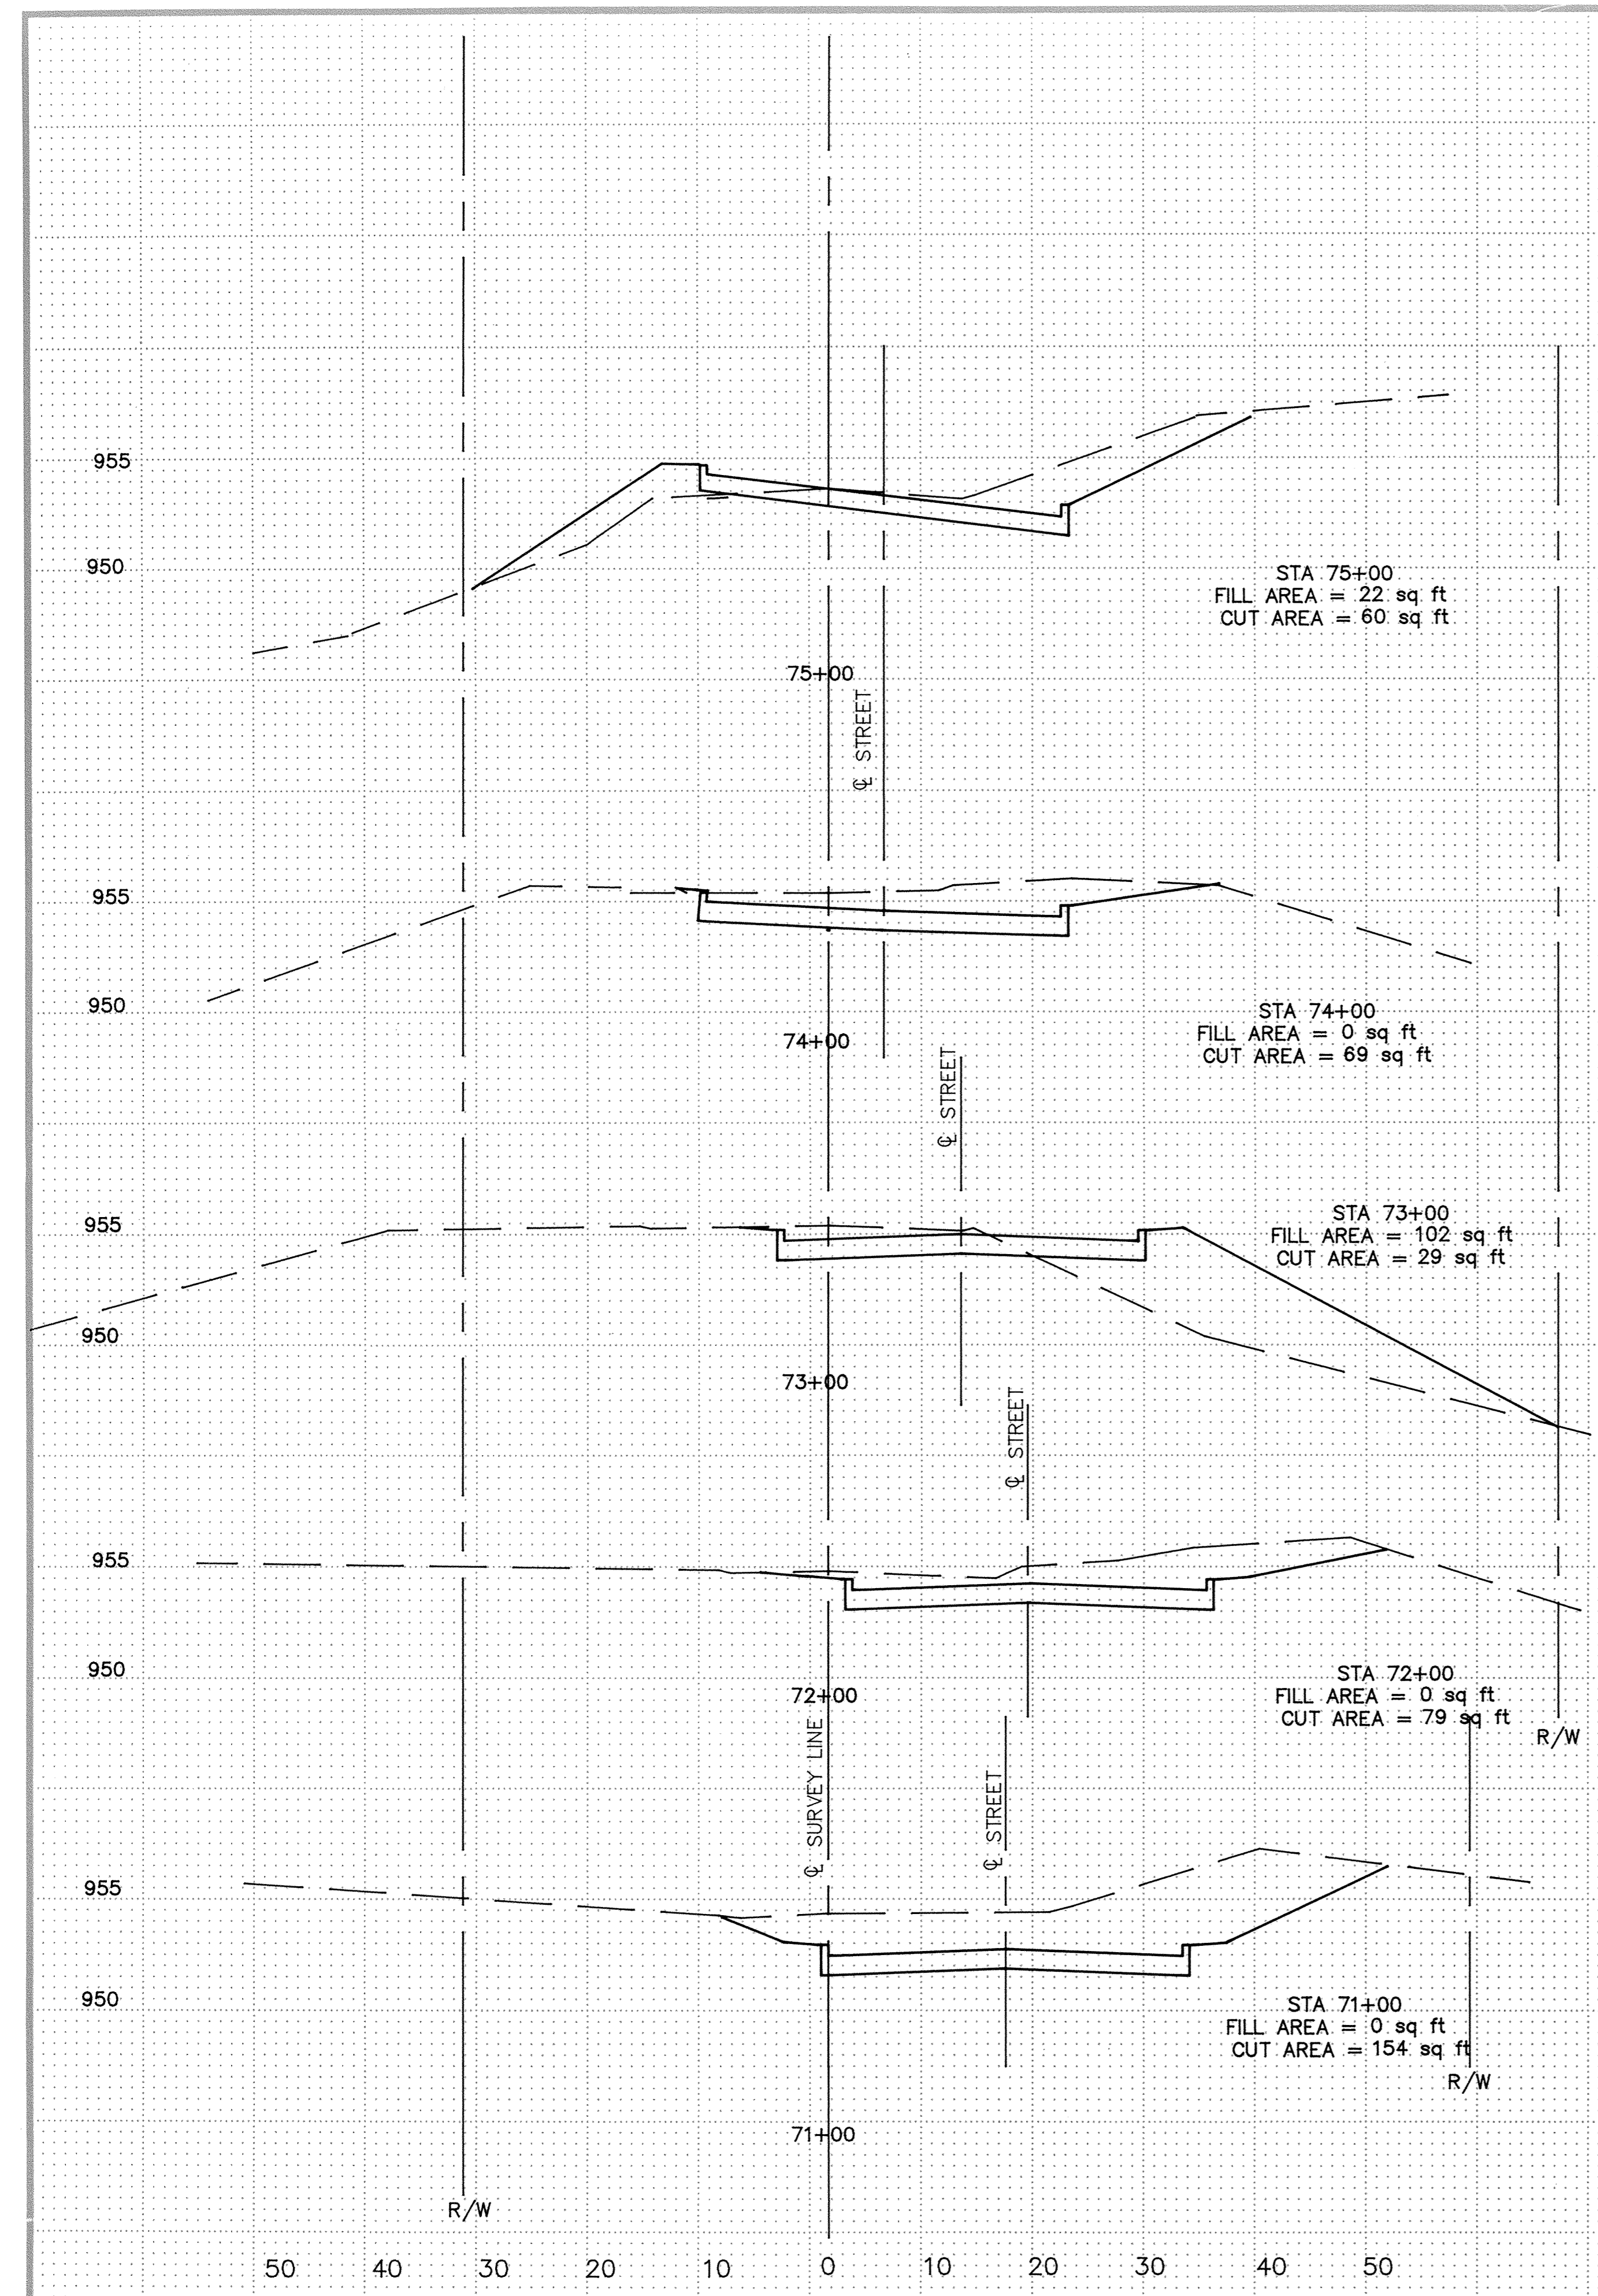

Scale: Horiz. 1"=10'
Vert. 1"=5'

State Proj. No. 204-114-01 Sheet No. 21 of 22 Sheets