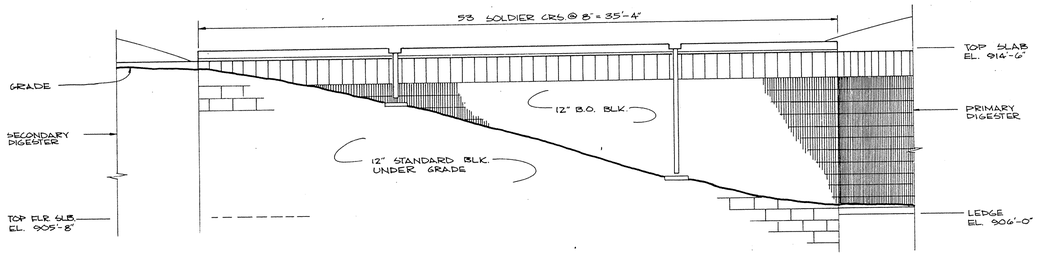

NORTH ELEVATION
SCALE: 1/4" = 1'-0"

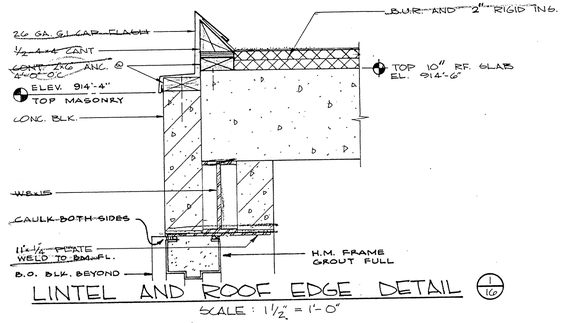

LINTEL AND ROOF EDGE DETAIL 1/16
SCALE: 1 1/2" = 1'-0"

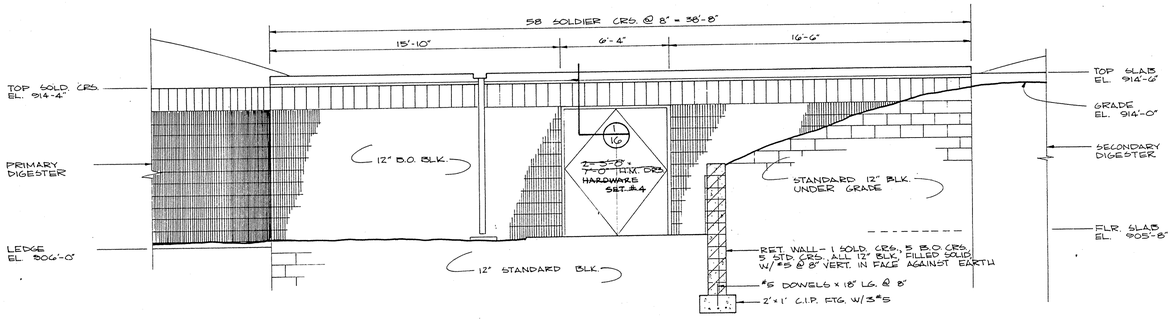

SOUTH ELEVATION
SCALE: 1/4" = 1'-0"

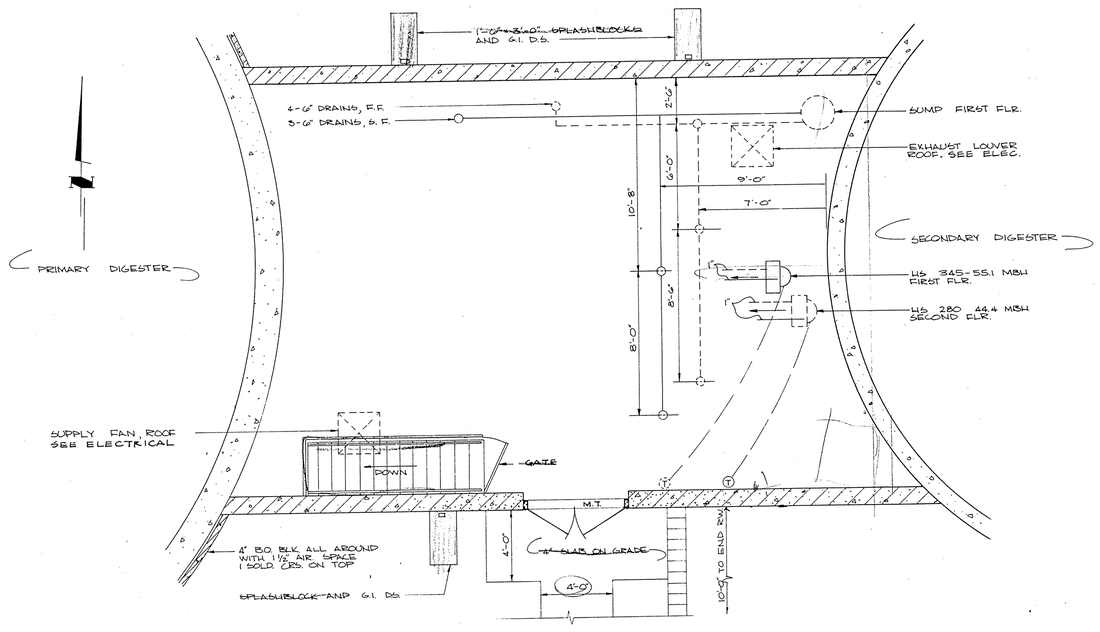

DIGESTER BUILDING PLAN
SCALE: 1/4" = 1'-0"

NO.	DATE	BY	REMARKS
			REVISIONS

DESIGNED K.L.V. | DRAWN S.W.J. | DATE 8/27/75 | CHECKED K.L.V. | APPROVED W.H.M. | COMM.

I HEREBY CERTIFY THAT THIS PLAN WAS PREPARED BY ME OR UNDER MY DIRECT SUPERVISION AND THAT I AM A DULY REGISTERED PROFESSIONAL ENGINEER UNDER THE LAWS OF THE STATE OF MINNESOTA.
Lawrence Van Gackern
DATE Aug 29, 1975 REG. NO. 10159

McCOMBS-KNUTSON ASSOCIATES, INC.
CONSULTING ENGINEERS ■ LAND SURVEYORS ■ SITE PLANNERS
MINNEAPOLIS, HUTCHINSON and MARSHALL, MINNESOTA

WASTE WATER TREATMENT FACILITIES
FOR
ELK RIVER, MINNESOTA

SCALE AS NOTED | BOOK | PAGE | FILE NO. 2603

ARCHITECTURAL
DIGESTER BUILDING

SHEET 16 | REV. | OF 31

DRAWING NUMBER

DRAWING NUMBER
WASTE.75
16