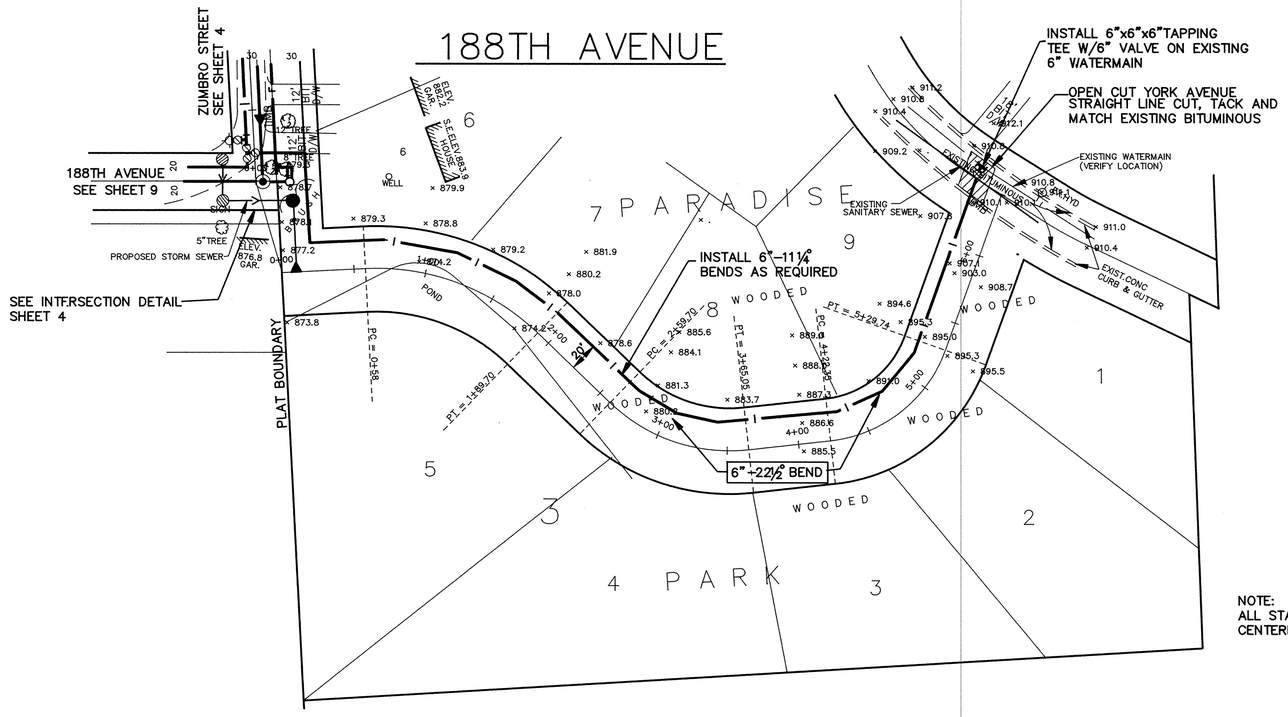

NOTE:
ALL STATION REFERS TO CENTERLINE OF R.O.W.

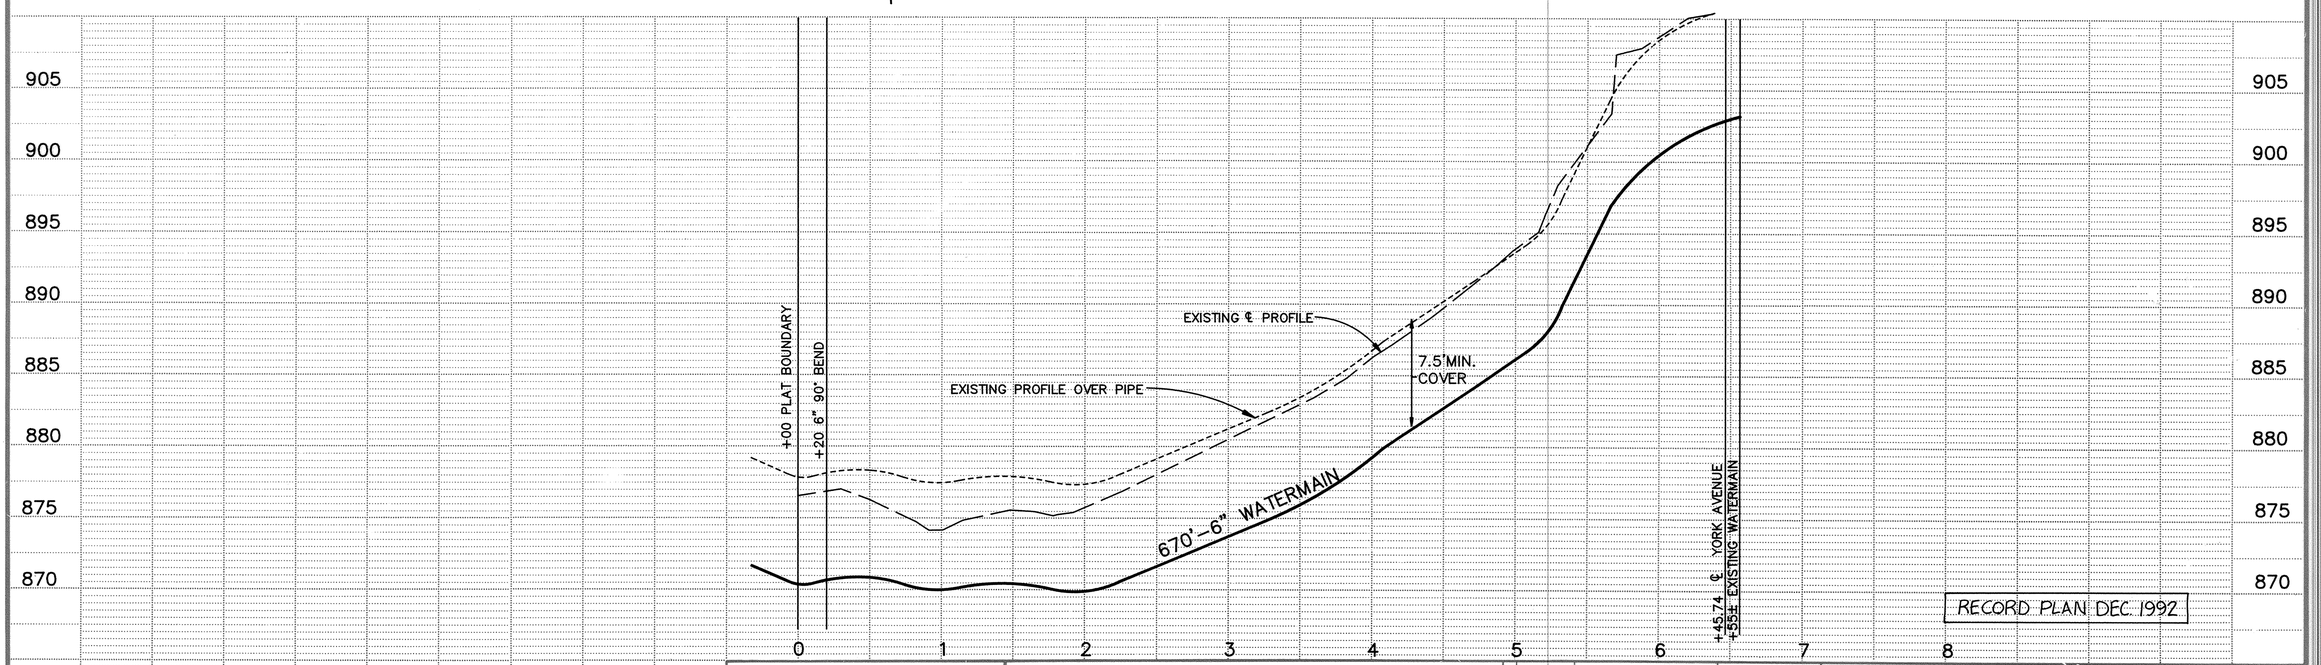

RECORD PLAN DEC. 1992

I HEREBY CERTIFY THAT THIS PLAN, SPECIFICATION, OR REPORT WAS PREPARED BY ME OR UNDER MY DIRECT SUPERVISION AND THAT I AM A DULY REGISTERED PROFESSIONAL ENGINEER UNDER THE LAWS OF THE STATE OF MINNESOTA.

Terry J. Maurer

DATE 2/6/92 REG. NO. 15316

CONSULTING ENGINEERS
Maier Stewart & Associates Inc.
9800 SHELARD PARKWAY (612) 546–0432 MINNEAPOLIS, MINNESOTA 55441
1959 SLOAN PLACE (612) 774–6021 ST. PAUL, MINNESOTA 55117

REVISIONS	DATE	DESCRIPTION

DESIGNED
CHECKED
DRAWN
GRAPHIC SCALE
HORIZ. 50
VERT. 5

CITY OF ELK RIVER
WATERMAIN CONSTRUCTION
188TH AVENUE

DATE JAN.,1992 | SHEET 11 OF 23 SHEETS | PROJECT NO. 230-~~176~~

ER116–9

DRAWING NUMBER
WESTW.92
11

461