COUNTY ADMINISTRATION BUILDING EASEMENT

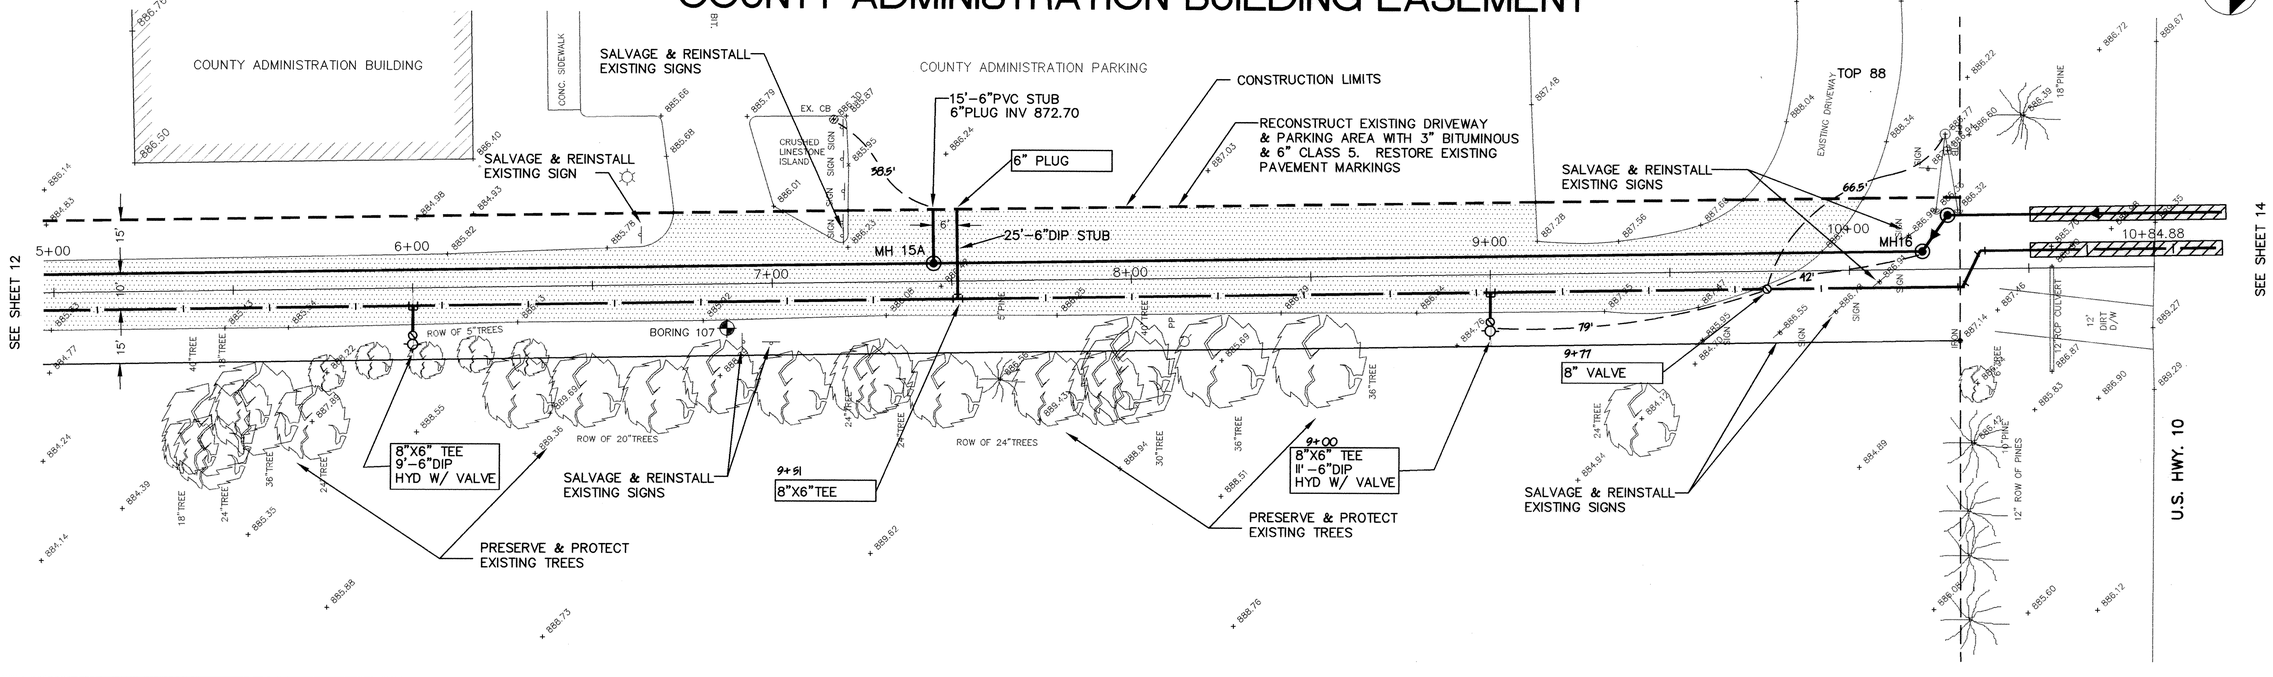

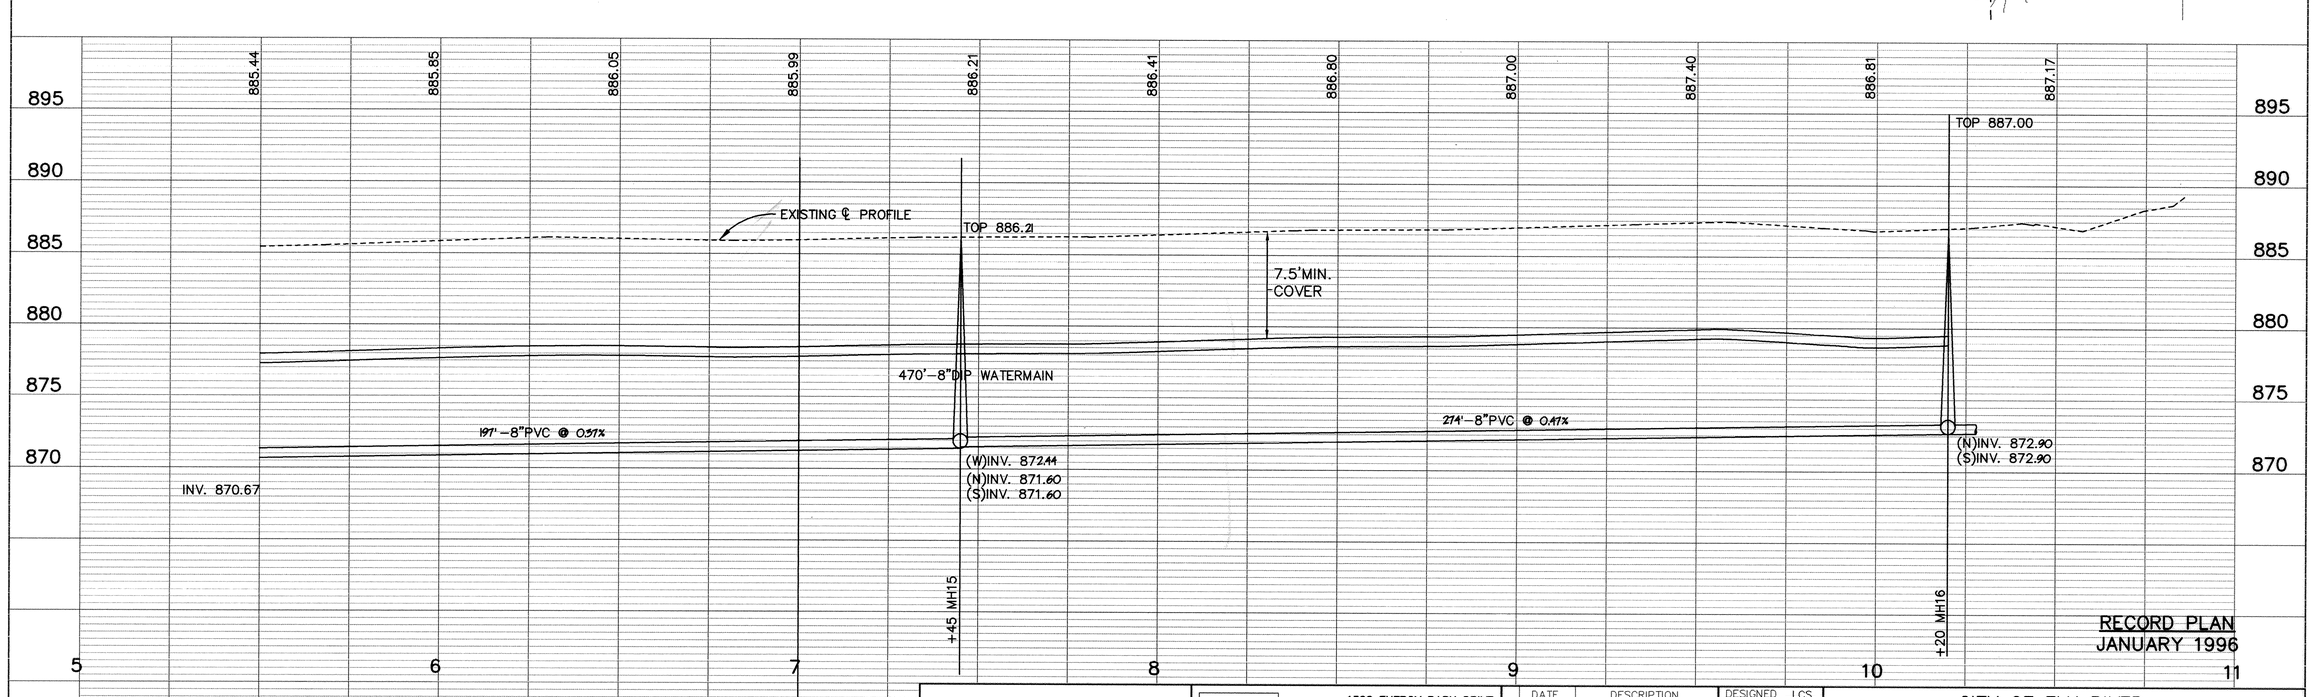

I HEREBY CERTIFY THAT THIS PLAN, SPECIFICATION, OR REPORT WAS PREPARED BY ME OR UNDER MY DIRECT SUPERVISION AND THAT I AM A DULY REGISTERED PROFESSIONAL ENGINEER UNDER THE LAWS OF THE STATE OF MINNESOTA.
Mark V. Graham
DATE 9/21/94 REG.NO. 19130

MSA CONSULTING ENGINEERS

1326 ENERGY PARK DRIVE
ST. PAUL, MINNESOTA 55108
(612) 644-4389

9800 SHELARD PARKWAY
MINNEAPOLIS, MINNESOTA 55441
(612) 546-0432

REVISIONS	DATE	DESCRIPTION

DESIGNED LCS.
CHECKED
DRAWN LCS
GRAPHIC SCALE 0 20 / 0 VERT. 5

CITY OF ELK RIVER
SANITARY SEWER AND WATERMAIN
COUNTY ADMINISTRATION BUILDING EASEMENT
5+50 TO 10+20

DATE AUG. 1994 | SHEET 13 OF 63 SHEETS | PROJECT NO. 230-223

ER223C-4

997

DRAWING NUMBER


WEST2.94
13

SIKICO PRODUCTS • NEW HOPE, MINNESOTA
REORDER BY PART NUMBER 65502