T.H. 10 JACK-BORING AT COUNTY ADMINISTRATION BUILDING

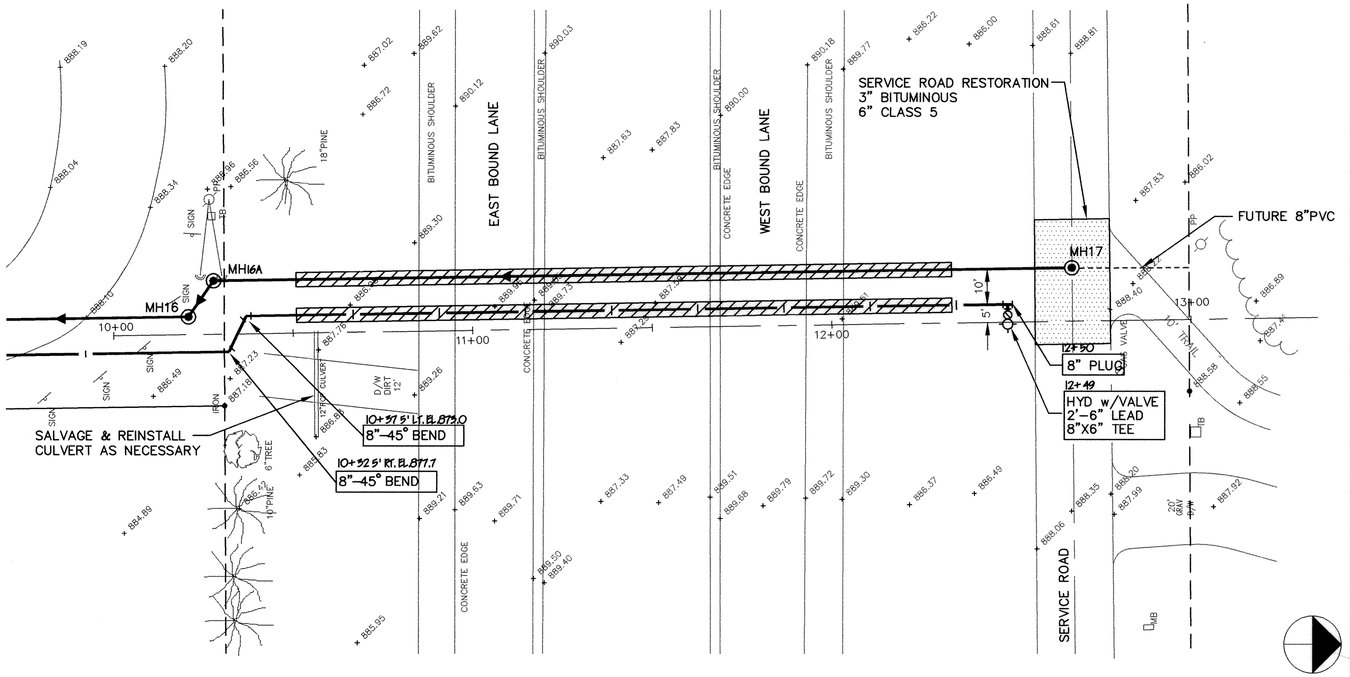

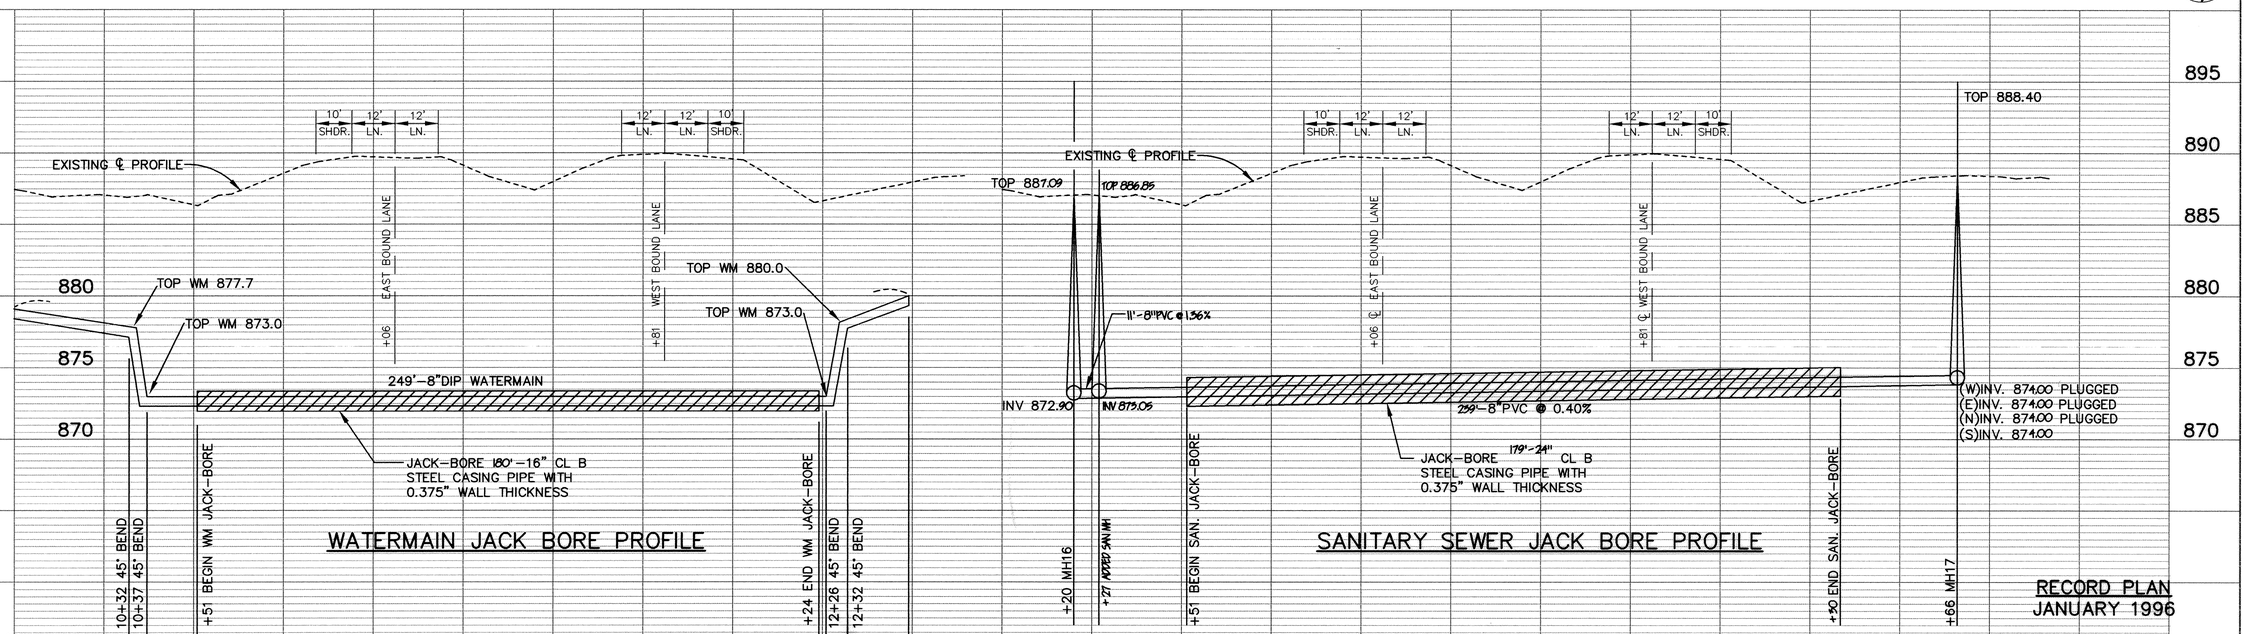

I HEREBY CERTIFY THAT THIS PLAN, SPECIFICATION, OR REPORT WAS PREPARED BY ME OR UNDER MY DIRECT SUPERVISION AND THAT I AM A DULY REGISTERED PROFESSIONAL ENGINEER UNDER THE LAWS OF THE STATE OF MINNESOTA.
Mark V. Graham
DATE 9/21/94 REG.NO. 19130

MSA CONSULTING ENGINEERS
1326 ENERGY PARK DRIVE
ST. PAUL, MINNESOTA 55108
(612) 644-4389
9800 SHELARD PARKWAY
MINNEAPOLIS, MINNESOTA 55441
(612) 546-0432

REVISIONS	DATE	DESCRIPTION

DESIGNED LCS
CHECKED
DRAWN LCS
GRAPHIC SCALE 0 20 / 0 VERT. 5

CITY OF ELK RIVER
SANITARY SEWER AND WATERMAIN JACKING
T.H. 10 JACK-BORING AT COUNTY ADMINISTRATION BUILDING
10+20 TO 13+00

DATE AUG. 1994 | SHEET 14 OF 63 SHEETS | PROJECT NO. 230-223

ER223C-5

996

DRAWING NUMBER

DRAWING NUMBER
WESTE2.94-
14