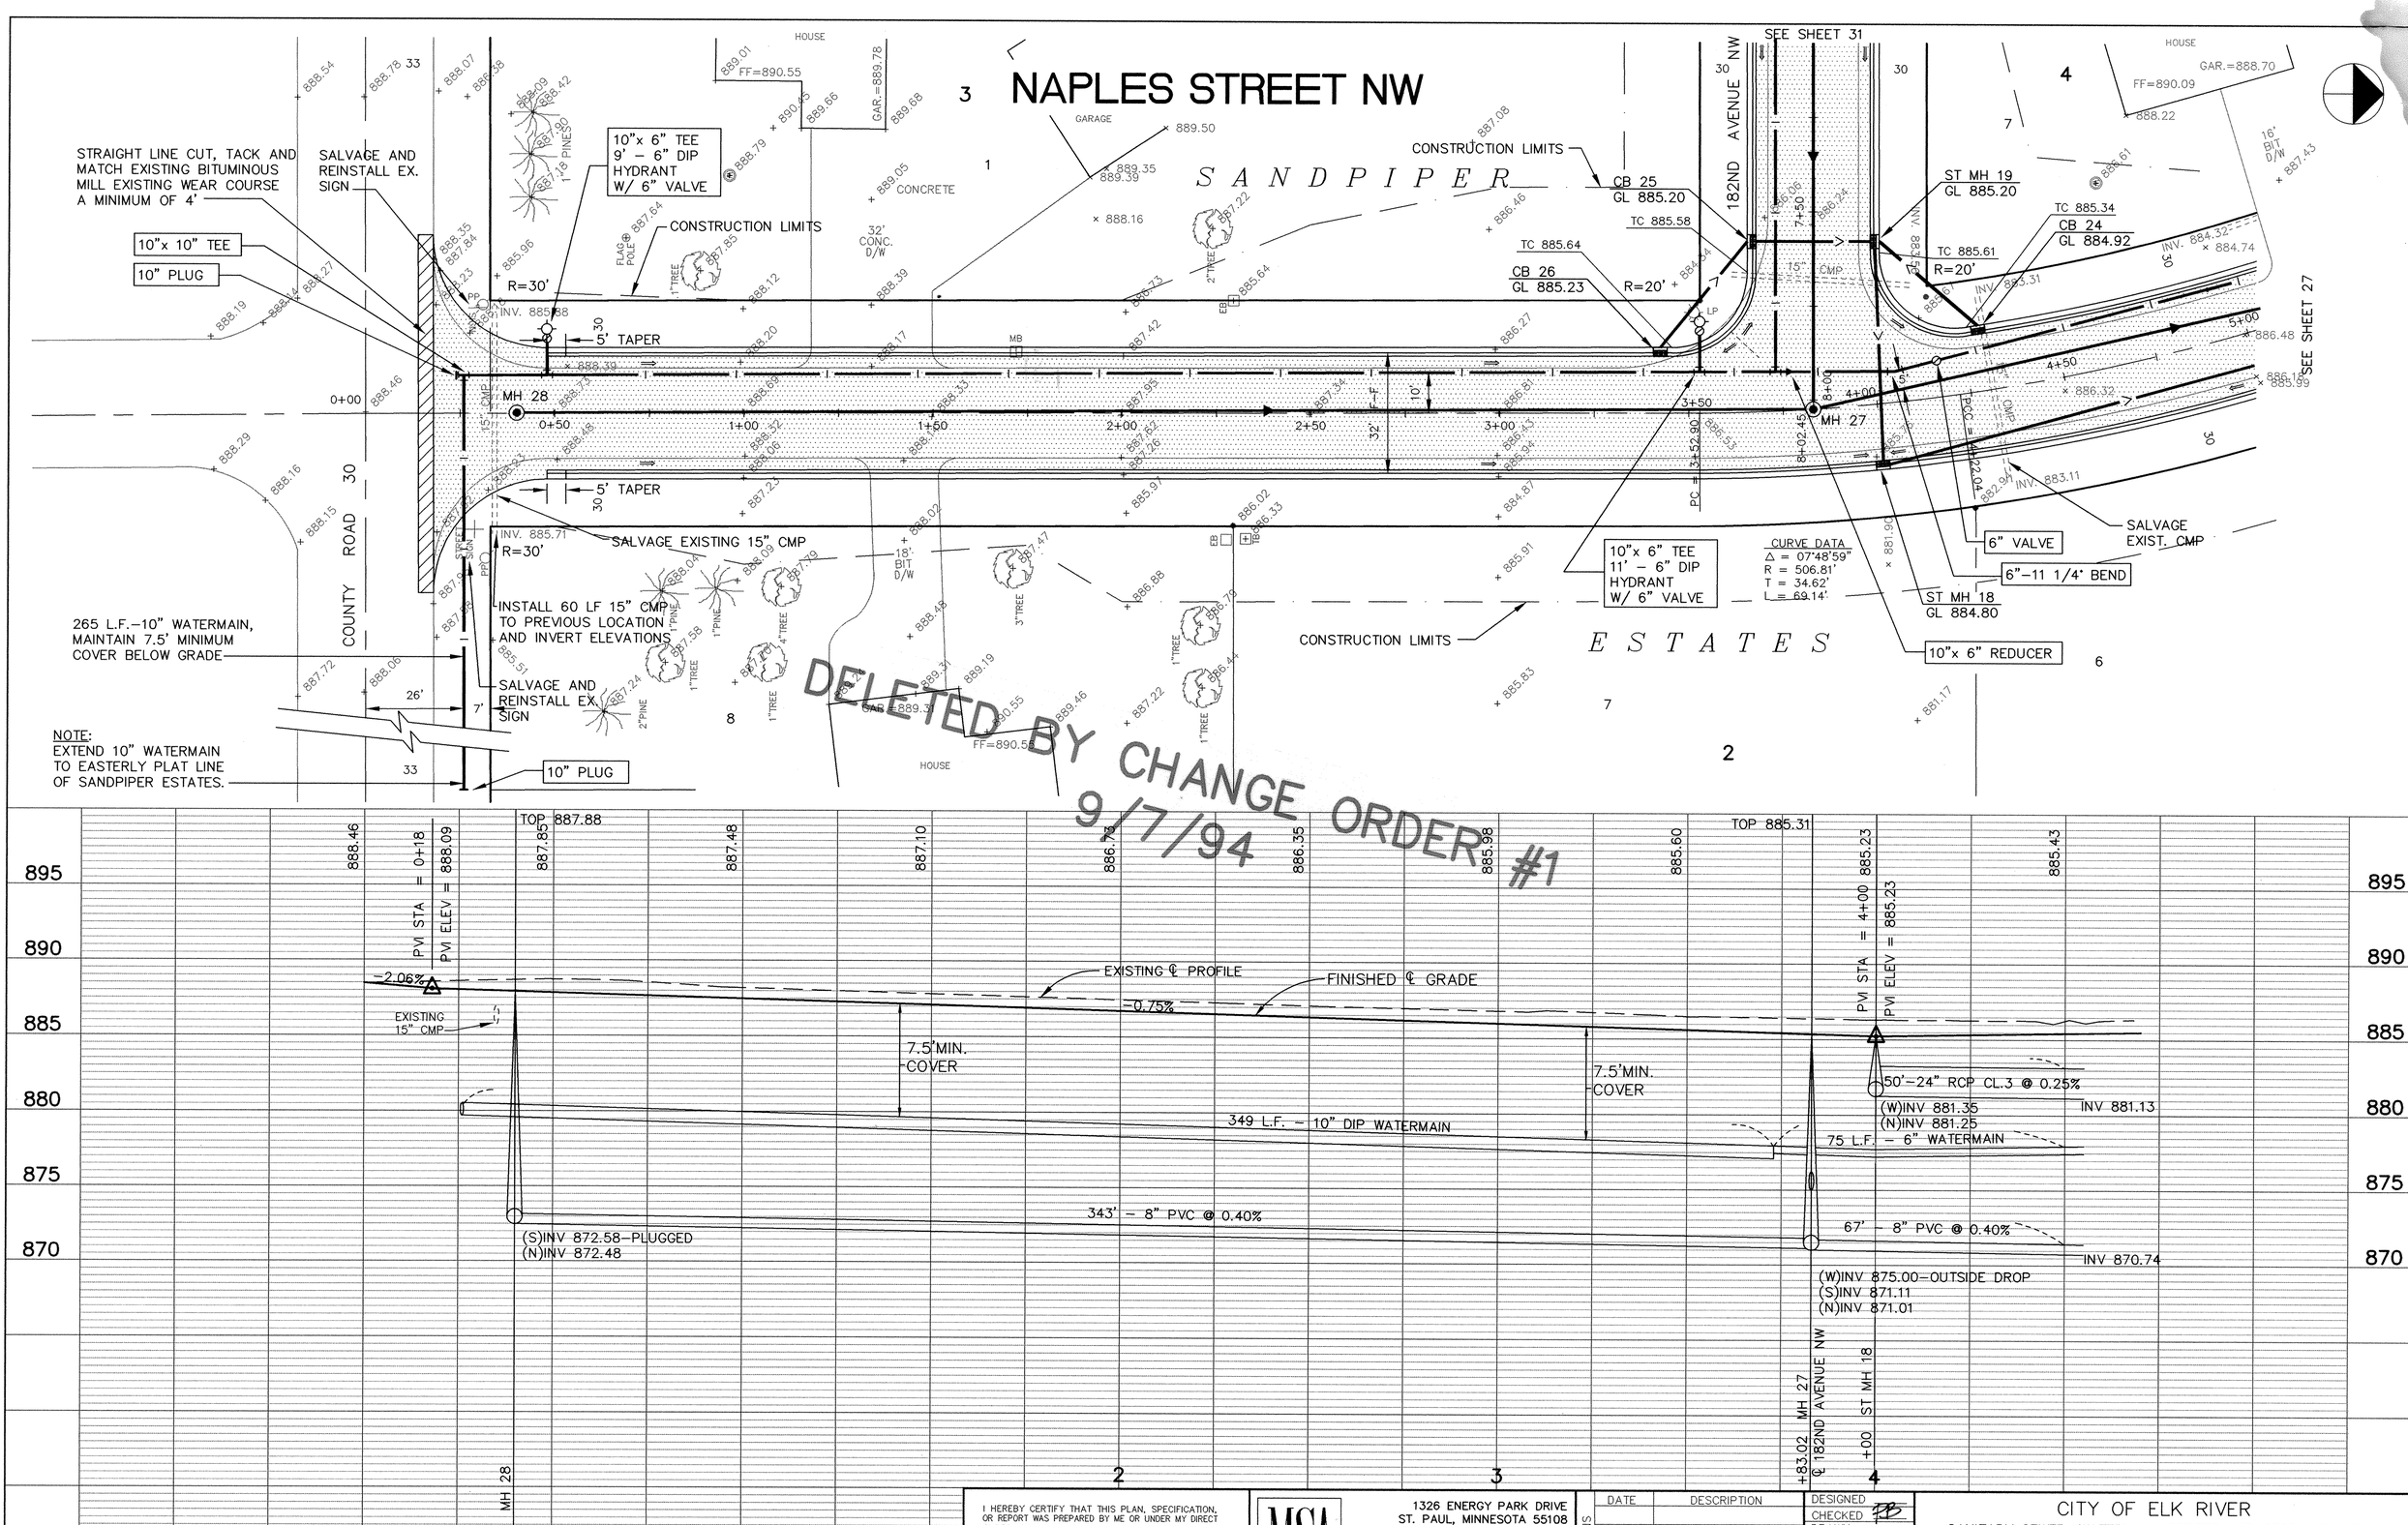

I HEREBY CERTIFY THAT THIS PLAN, SPECIFICATION, OR REPORT WAS PREPARED BY ME OR UNDER MY DIRECT SUPERVISION AND THAT I AM A DULY REGISTERED PROFESSIONAL ENGINEER UNDER THE LAWS OF THE STATE OF MINNESOTA.

Mark V. Graham

DATE 8/15/94 REG.NO. 19130

MSA CONSULTING ENGINEERS

1326 ENERGY PARK DRIVE
ST. PAUL, MINNESOTA 55108
(612) 644-4389

9800 SHELARD PARKWAY
MINNEAPOLIS, MINNESOTA 55441
(612) 546-0432

REVISIONS

DATE	DESCRIPTION

DESIGNED
CHECKED
DRAWN
GRAPHIC SCALE 0 20
0 VERT. 5

CITY OF ELK RIVER
SANITARY SEWER, WATERMAIN, STREET AND STORM SEWER
NAPLES STREET NW

0+00 TO 4+50

DATE AUGUST 1994 | SHEET 26 OF 63 SHEETS | PROJECT NO. 230-223

ER223S-6

984