



STATION	AREAS Square Feet		VOLUMES Cubic Yards		CUMULATIVE VOLUMES Cubic Yards	
	CUT	FILL	CUT	FILL	CUT	FILL
0+00	163.43	0.00	191.66	87.47	191.66	87.47
0+50	43.57	94.47	70.87	192.40	262.53	279.87
1+00	32.97	113.32	51.44	165.32	313.97	445.19
1+50	22.59	65.23	36.44	113.57	350.41	558.76
2+00	16.83	55.27	24.83	139.93	375.23	698.70
2+50	10.01	95.81	19.01	194.28	394.24	892.97
3+00	10.54	116.49	20.33	198.17	414.57	1091.15
3+50	11.44	100.09	26.26	134.42	440.83	1225.56
4+00	17.01	44.97	39.14	119.03	479.97	1344.60
4+50	25.34	81.97	53.06	138.72	533.03	1483.32
5+00	31.96	67.85	62.55	115.82	595.58	1599.14
5+50	35.58	57.24	69.12	91.18	664.69	1690.32
6+00	39.06	41.24	69.87	101.26	734.56	1791.58
6+50	36.39	68.11	67.02	118.74	801.58	1910.32
7+00	35.98	60.12	71.60	131.12	873.18	2041.43
7+50	41.34	81.48	176.92	75.44	1050.09	2116.88
8+00	149.73	0.00	13.75	0.00	1063.84	2116.88
8+02.45	153.52	0.00	0.00	0.00	1063.84	2116.88

DELETED BY CHANGE ORDER #1
9/7/94

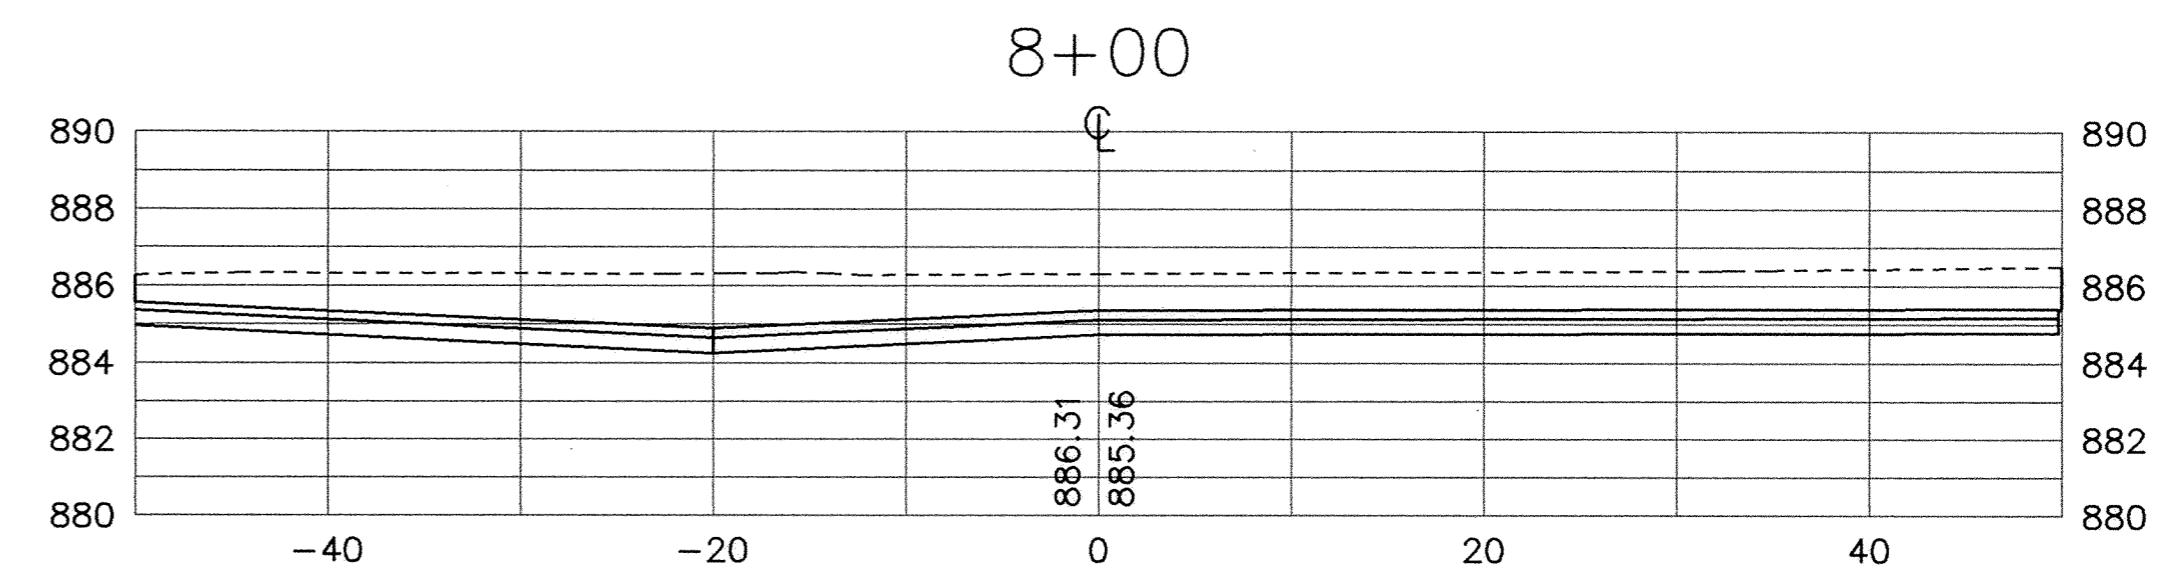

I HEREBY CERTIFY THAT THIS PLAN, SPECIFICATION, OR REPORT WAS PREPARED BY ME OR UNDER MY DIRECT SUPERVISION AND THAT I AM A DULY REGISTERED PROFESSIONAL ENGINEER UNDER THE LAWS OF THE STATE OF MINNESOTA.
Mark J. Graham
DATE 8/15/94 REG. NO. 19130

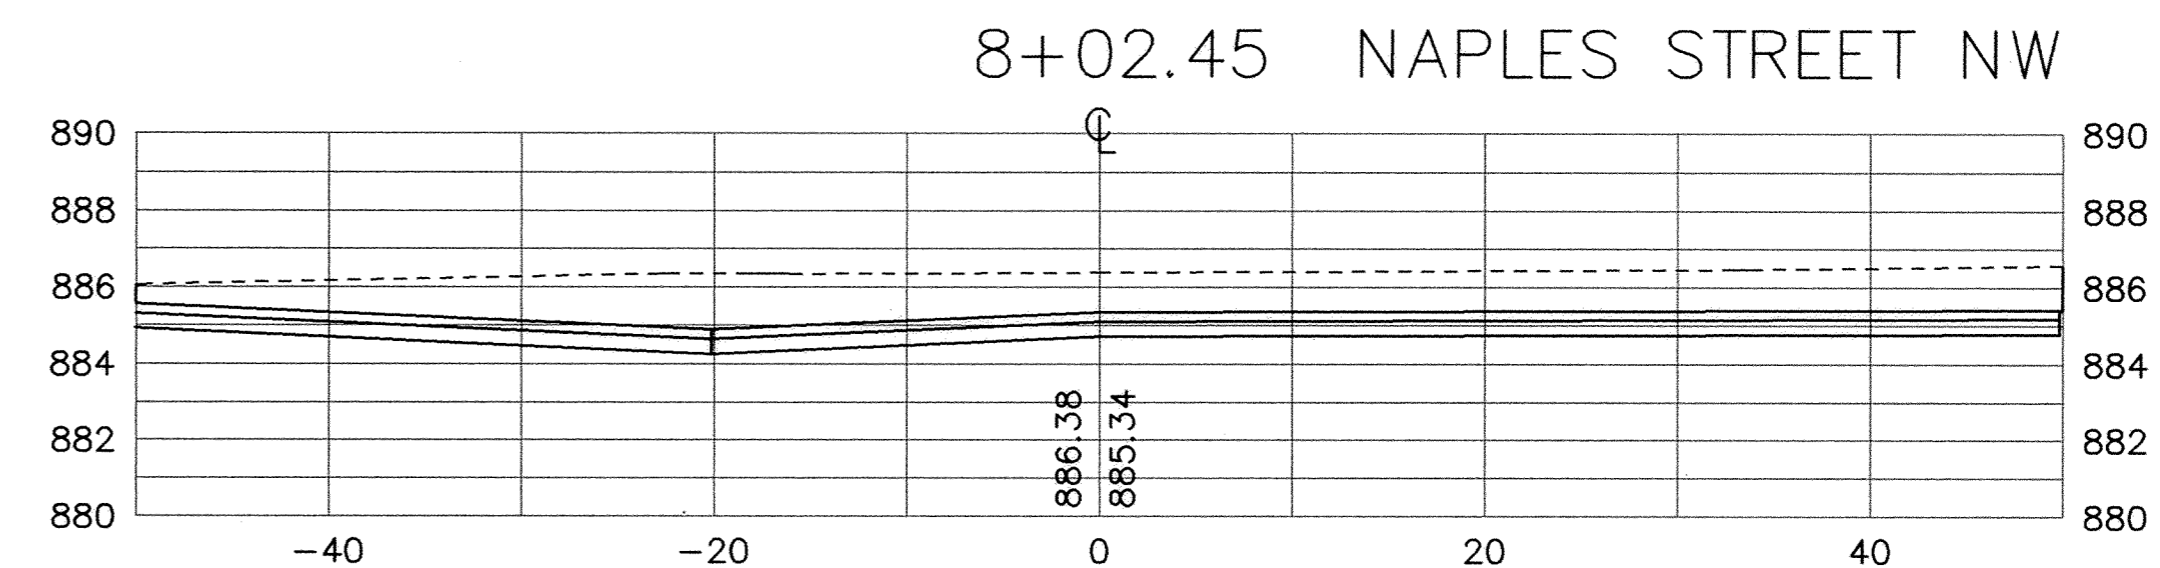

1326 ENERGY PARK DRIVE
ST. PAUL, MINNESOTA 55108
(612) 644-4389

9800 SHELARD PARKWAY
MINNEAPOLIS, MINNESOTA 55441
(612) 546-0432

DATE	DESCRIPTION	DESIGNED	CHECKED	DRAWN
			715	

GRAPHIC SCALE
0 10
0 5
VERT.

CITY OF ELK RIVER
182ND AVENUE NW
CROSS SECTIONS
5+00 TO 802.45
DATE AUG 1994 SHEET 55 OF 63 SHEETS PROJECT NO. 230-223