EASEMENT WEST OF SANDPIPER

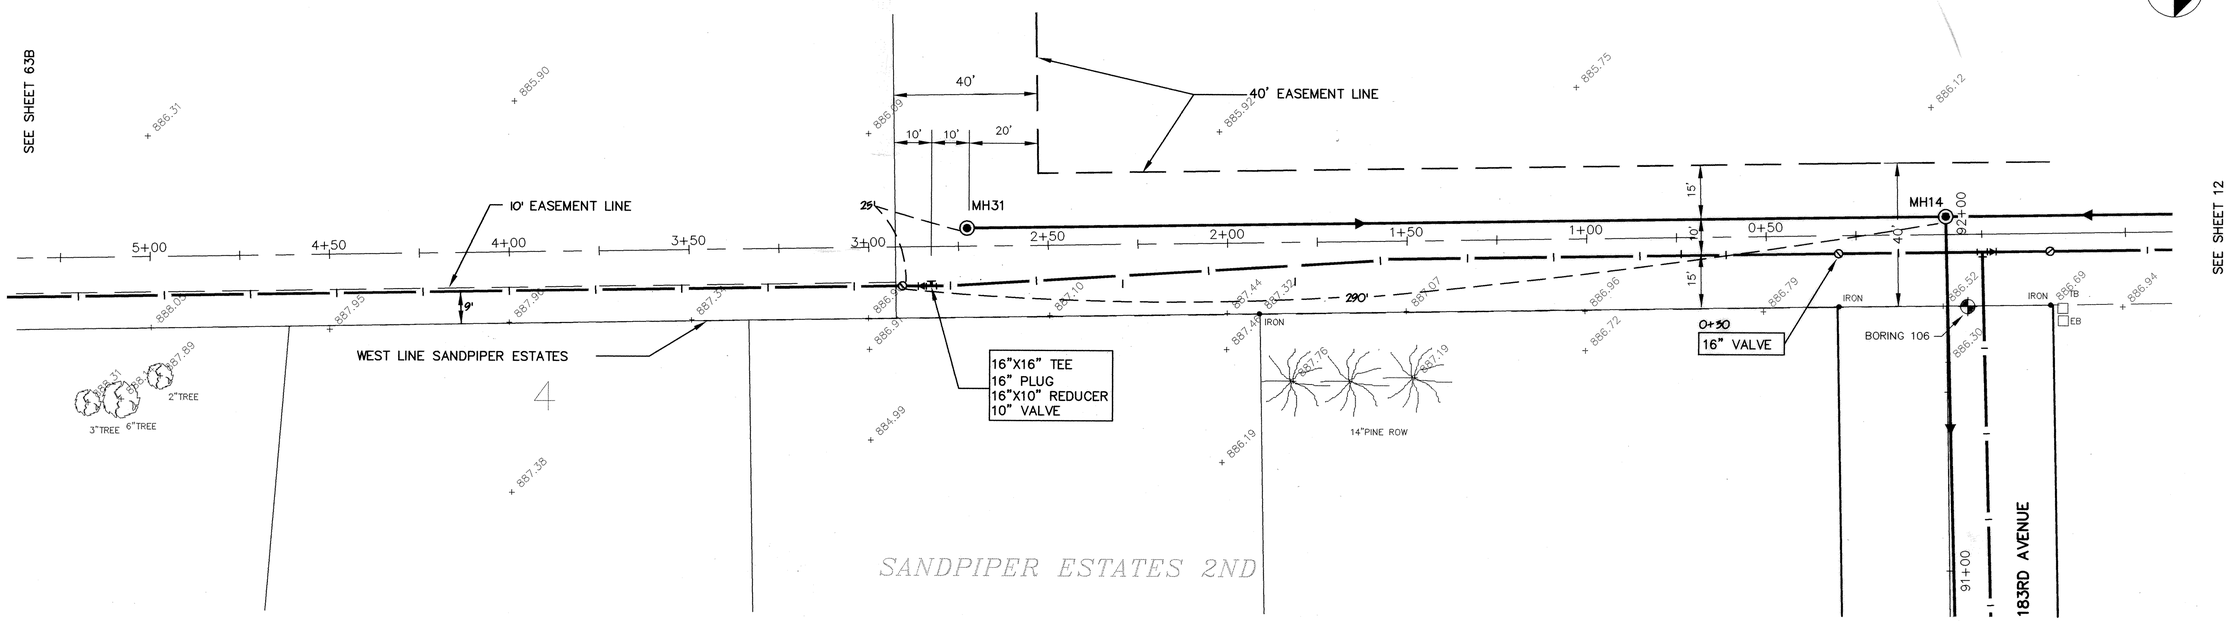

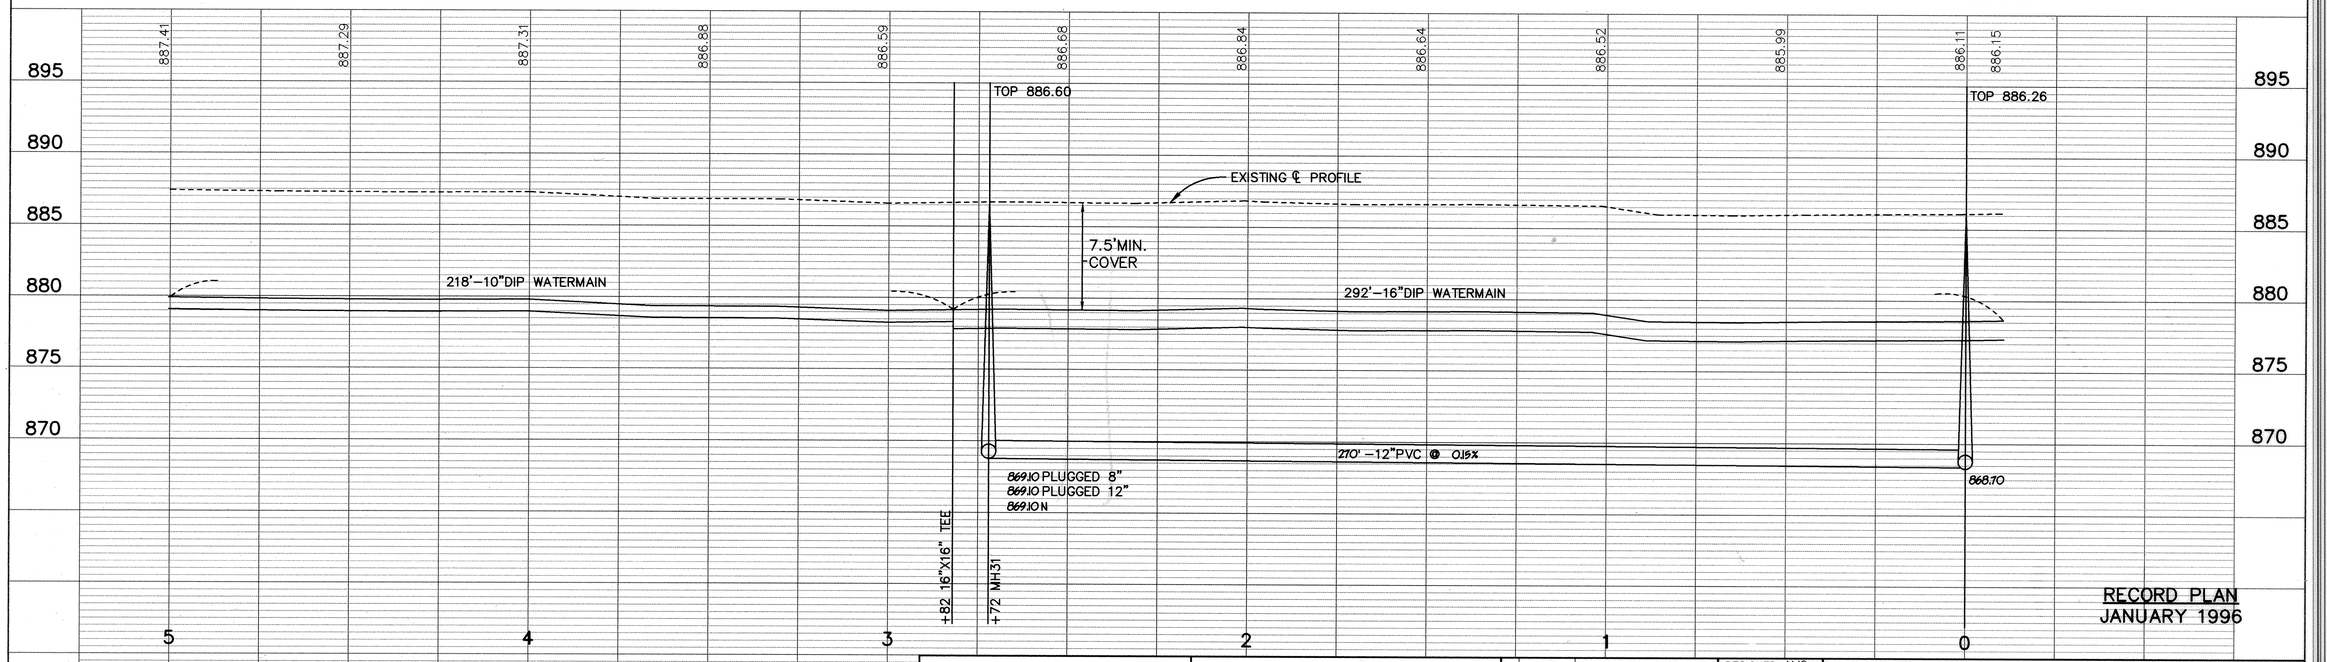

RECORD PLAN
JANUARY 1996

I HEREBY CERTIFY THAT THIS PLAN, SPECIFICATION, OR REPORT WAS PREPARED BY ME OR UNDER MY DIRECT SUPERVISION AND THAT I AM A DULY REGISTERED PROFESSIONAL ENGINEER UNDER THE LAWS OF THE STATE OF MINNESOTA.
Mark V. Graham
DATE 9/21/94 REG.NO. 19130

MSA CONSULTING ENGINEERS
1326 ENERGY PARK DRIVE
ST. PAUL, MINNESOTA 55108
(612) 644-4389
9800 SHELARD PARKWAY
MINNEAPOLIS, MINNESOTA 55441
(612) 546-0432

REVISIONS	DATE	DESCRIPTION
	9-15-94	CHANGE ORDER NO. 1

DESIGNED MJG
CHECKED
DRAWN LCS
GRAPHIC SCALES
0 HOR. 20
0 VERT. 5

CITY OF ELK RIVER
SANITARY SEWER AND WATERMAIN
EASEMENT WEST OF SANDPIPER
-0+10 TO 5+00

DATE SEPT. 1994 | SHEET 63A OF 63 SHEETS | PROJECT NO. 230-223

ER223W-1

942

DRAWING NUMBER
WESTE2.94
63A

DRAWING NUMBER
SYSCO PRODUCTS • NEW HOPE, MINNESOTA
REORDER BY PART NUMBER 6582
DRAWING NUMBER
SYSCO PRODUCTS • NEW HOPE, MINNESOTA
REORDER BY PART NUMBER 6582
DRAWING NUMBER
SYSCO PRODUCTS • NEW HOPE, MINNESOTA
REORDER BY PART NUMBER 6582