
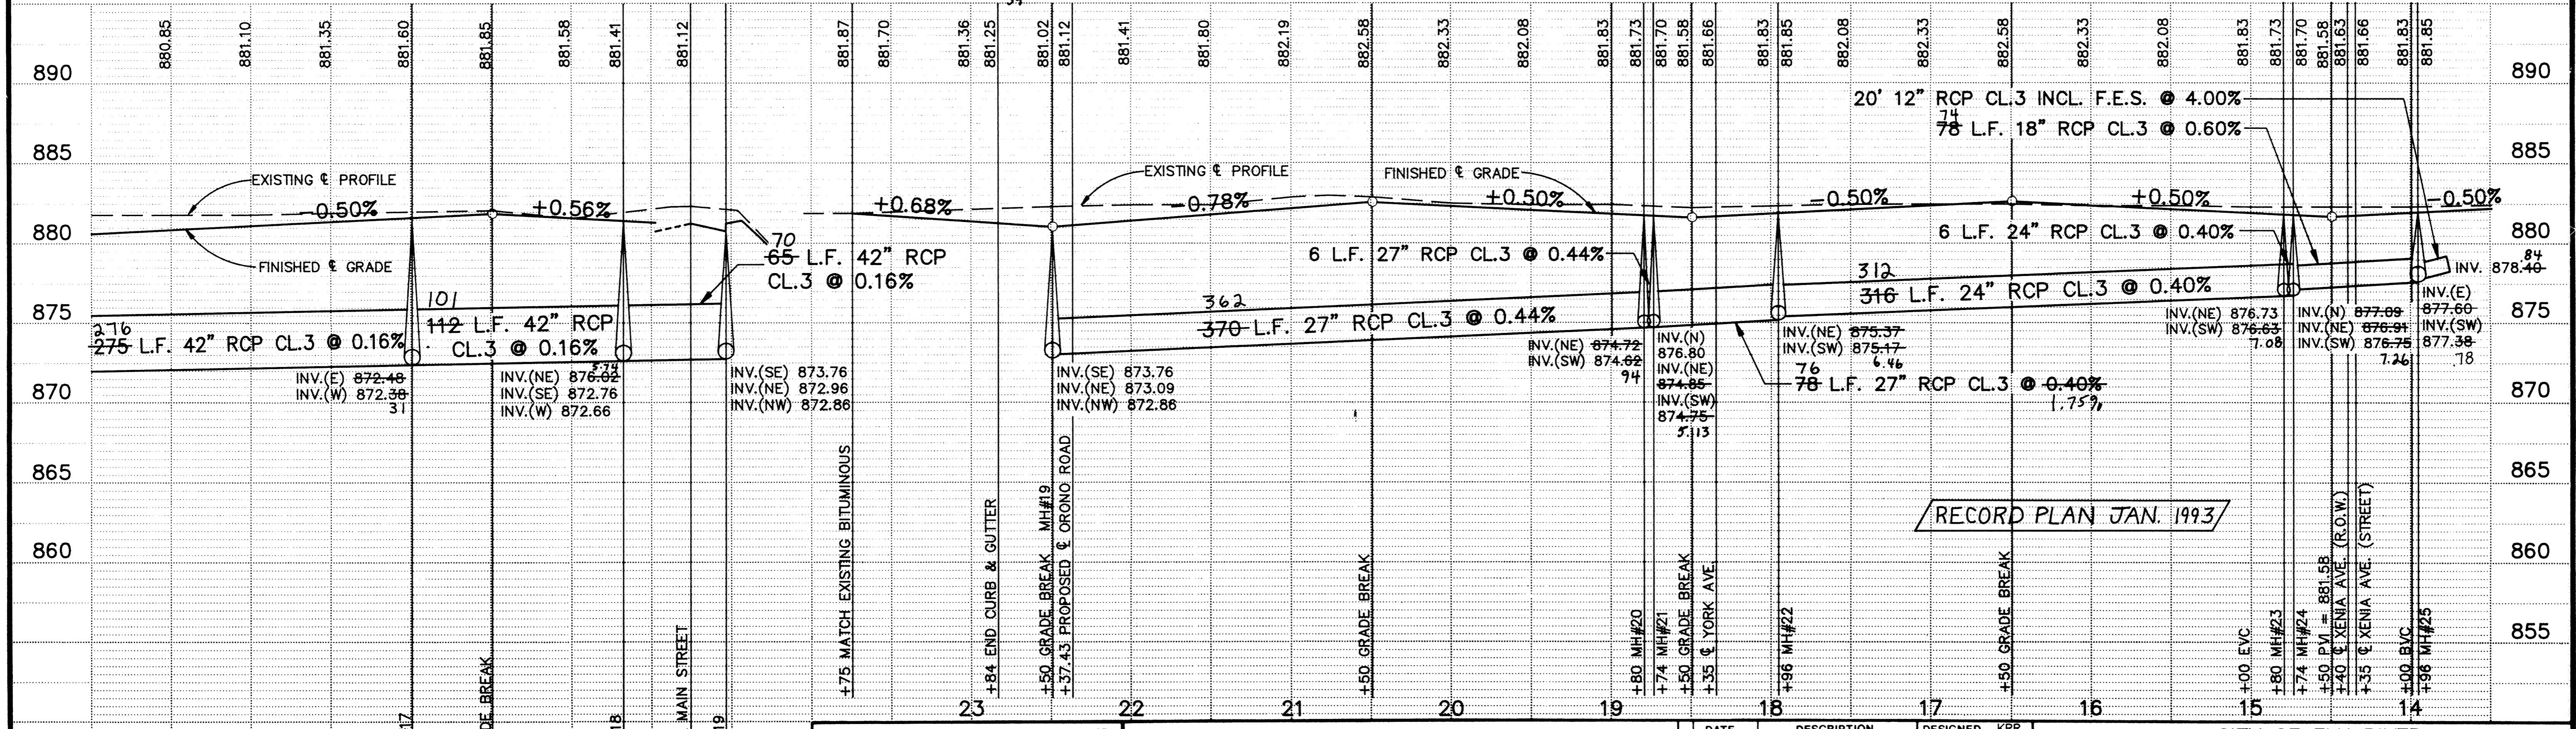


ORONO ROAD

MAIN STREET

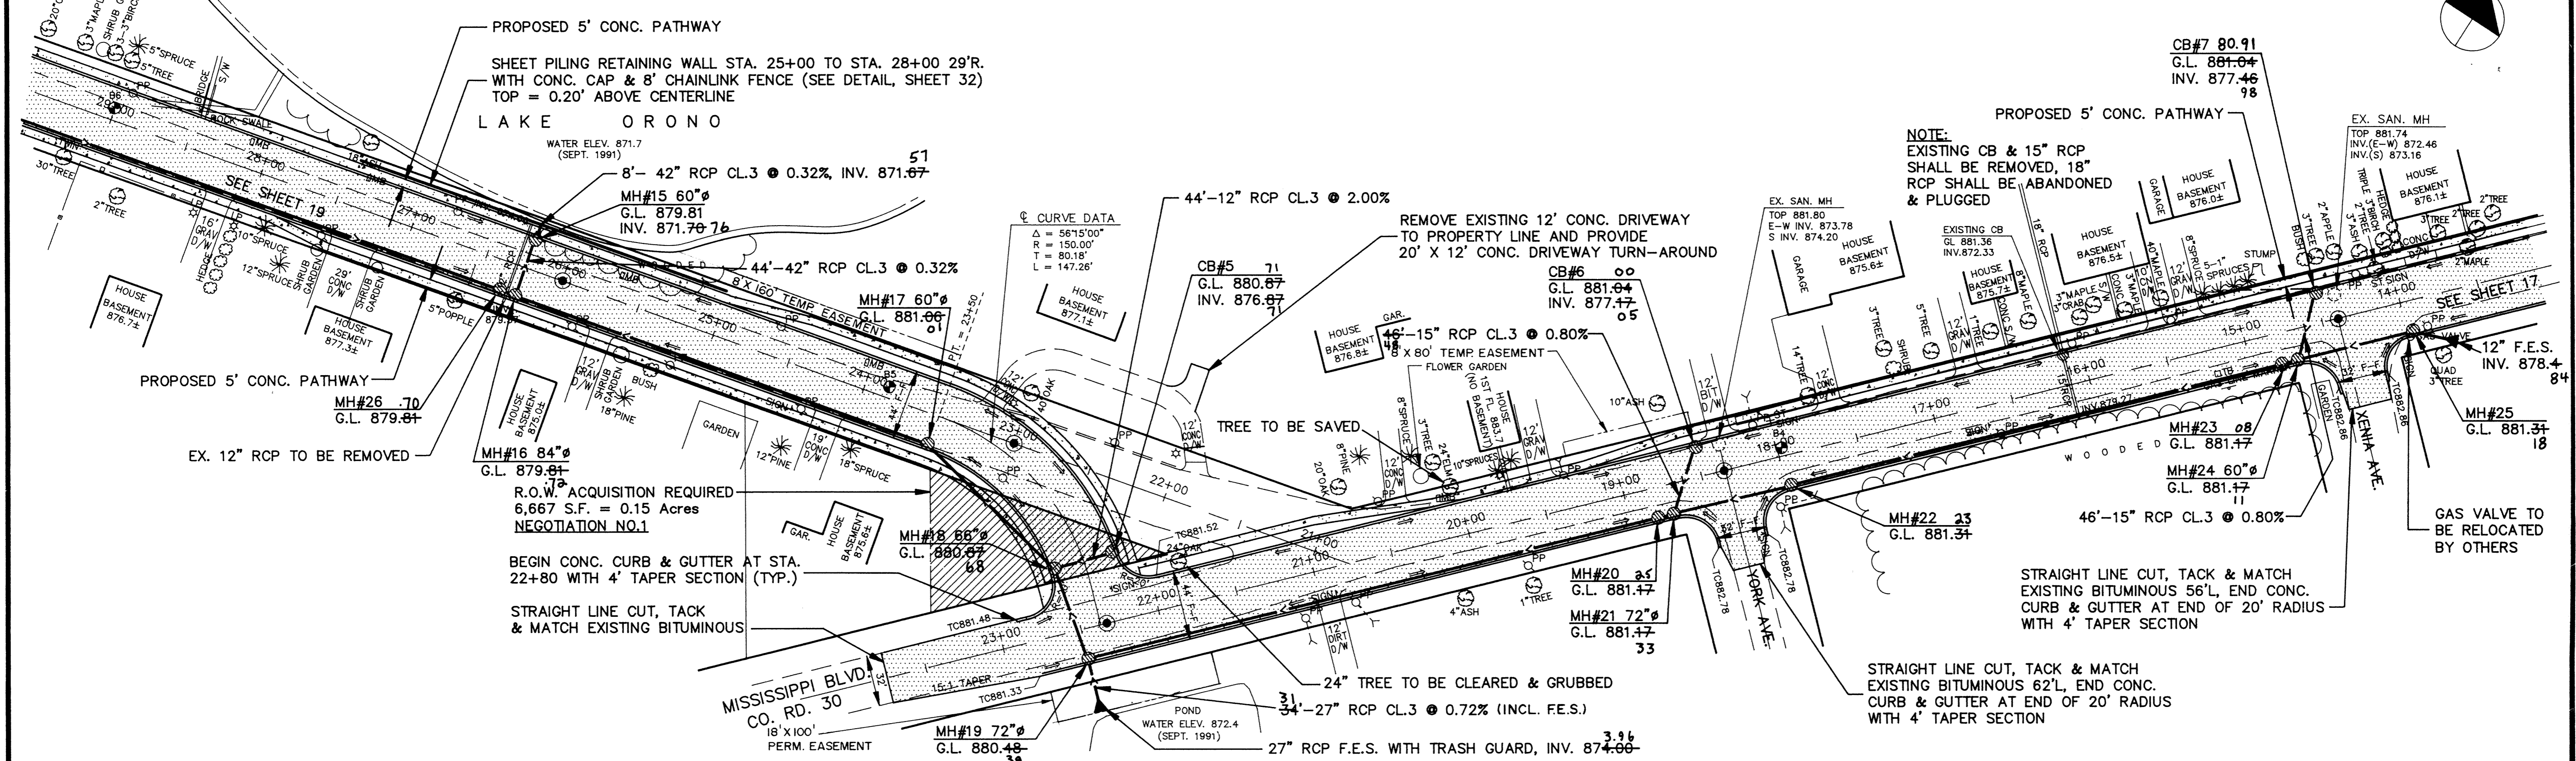

I HEREBY CERTIFY THAT THIS PLAN, SPECIFICATION, OR REPORT WAS PREPARED BY ME OR UNDER MY DIRECT SUPERVISION AND THAT I AM A DULY REGISTERED PROFESSIONAL ENGINEER UNDER THE LAWS OF THE STATE OF MINNESOTA.

KR Renslow

DATE 3/19/92 REG. NO. 20389

Maier Stewart & Associates Inc.
 CONSULTING ENGINEERS
 9800 SHELDARD PARKWAY (612) 546-0432 MINNEAPOLIS, MINNESOTA 55441
 1959 SLOAN PLACE (612) 774-6021 ST. PAUL, MINNESOTA 55117

DATE	DESCRIPTION	DESIGNED	CHECKED
		KRR	PER
			GG
		GRAPHIC SCALE	
		0 HORIZ. 50'	
		0 VERT. 5'	

CITY OF ELK RIVER
 S.A.P. 204-113-06
STREET & STORM SEWER CONSTRUCTION
ORONO ROAD / MAIN STREET

DATE NOV. 1991 SHEET 18 OF 36 SHEETS PROJECT NO. 230-131

DRAWING NUMBER

DRAWING NUMBER

DRAWING NUMBER

DRAWING NUMBER WESTE 92