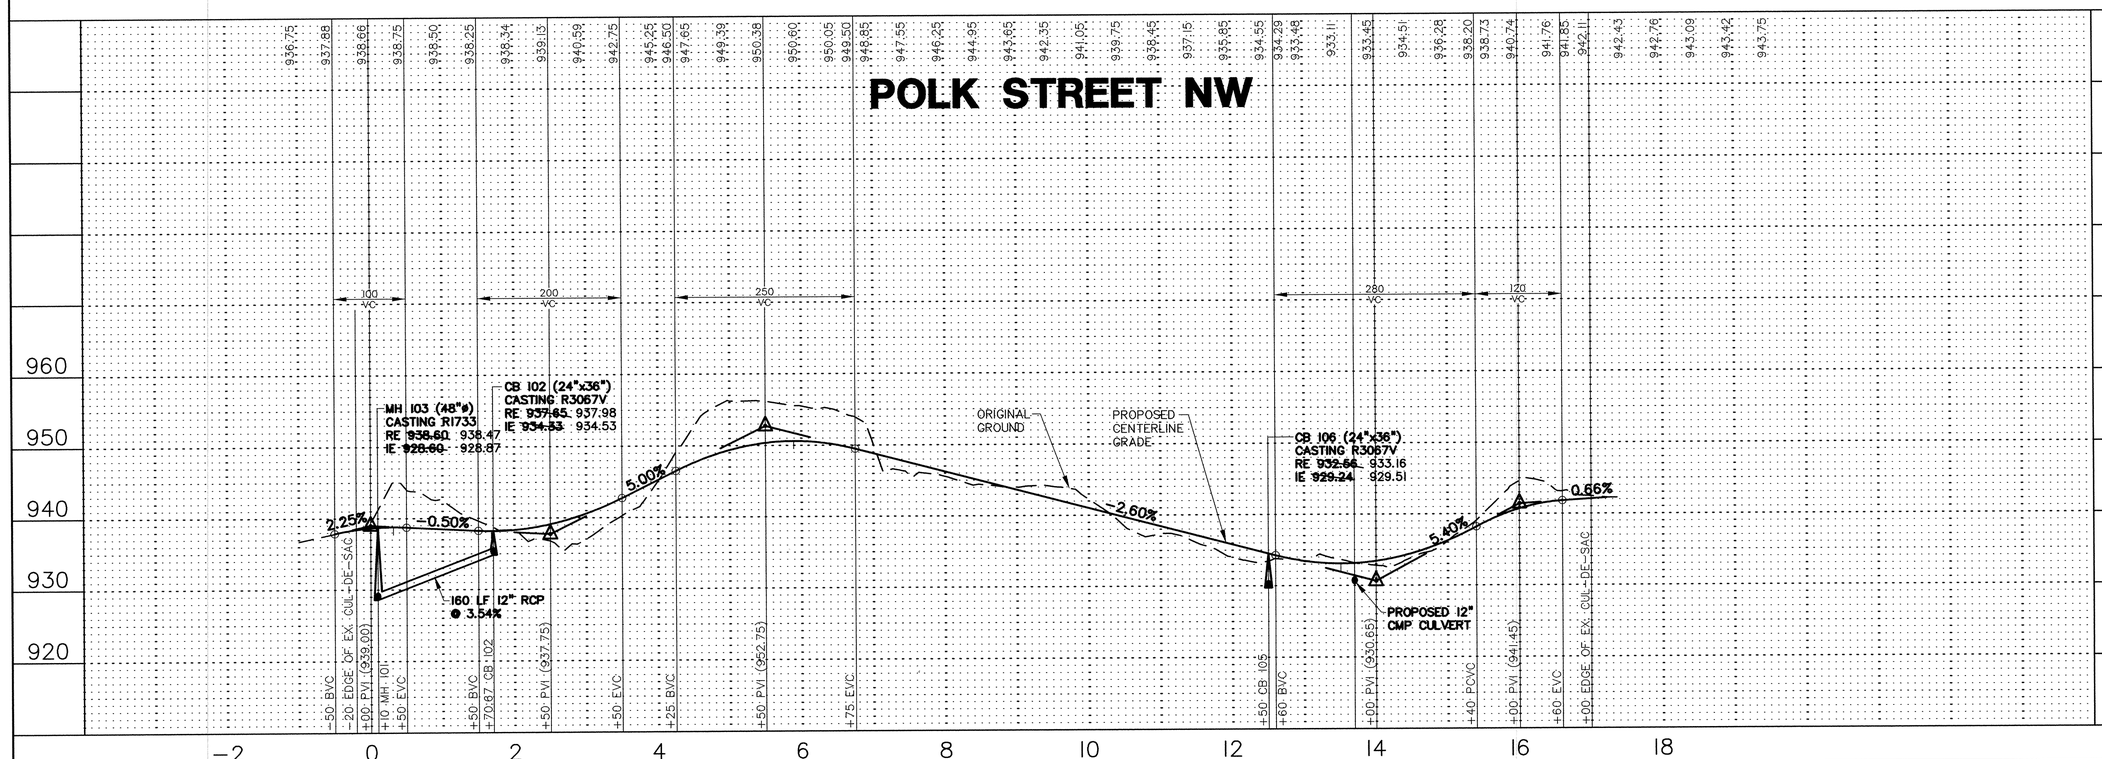

REV NO.	DATE	DESCRIPTION
1	6/14/00	ADDED CULVERT
2	1/31/02	AS-BUILTS

DATE: 4/28/00
DESIGN BY: EFM
DRAWN BY: TGL
CHECKED BY: EFM
DWG FILE: PROJ.DWG
TEXT FILE: NONE
FILE NO.: 7825-10-03

I, hereby certify that this plan, specification, or report was prepared by me or under my direct supervision and that I am a Licensed Professional Engineer under the laws of the State of Minnesota.

Signed:

Date: 5/1/00 Reg. No. 26968

John Oliver & Associates, Inc.
Civil Engineering, Land Surveying, Land Planning
580 Dodge Avenue
Elk River, Minnesota 55330
(612)441-2072 (FAX)441-5665
201 W. Travelers Trail, Suite 200
Burnsville, MN 55337
(612)894-3045 (FAX)894-3049

WHITETAIL RIDGE
ELK RIVER, MN
FOR
DENNIS PECK

FINAL ROAD GRADES

SHEET NO. 2 OF 2

DRAWING NUMBER
WHITE.00
2

SAFCO PRODUCTS • NEW HOPE, MINNESOTA
REORDER BY PART NUMBER 6592