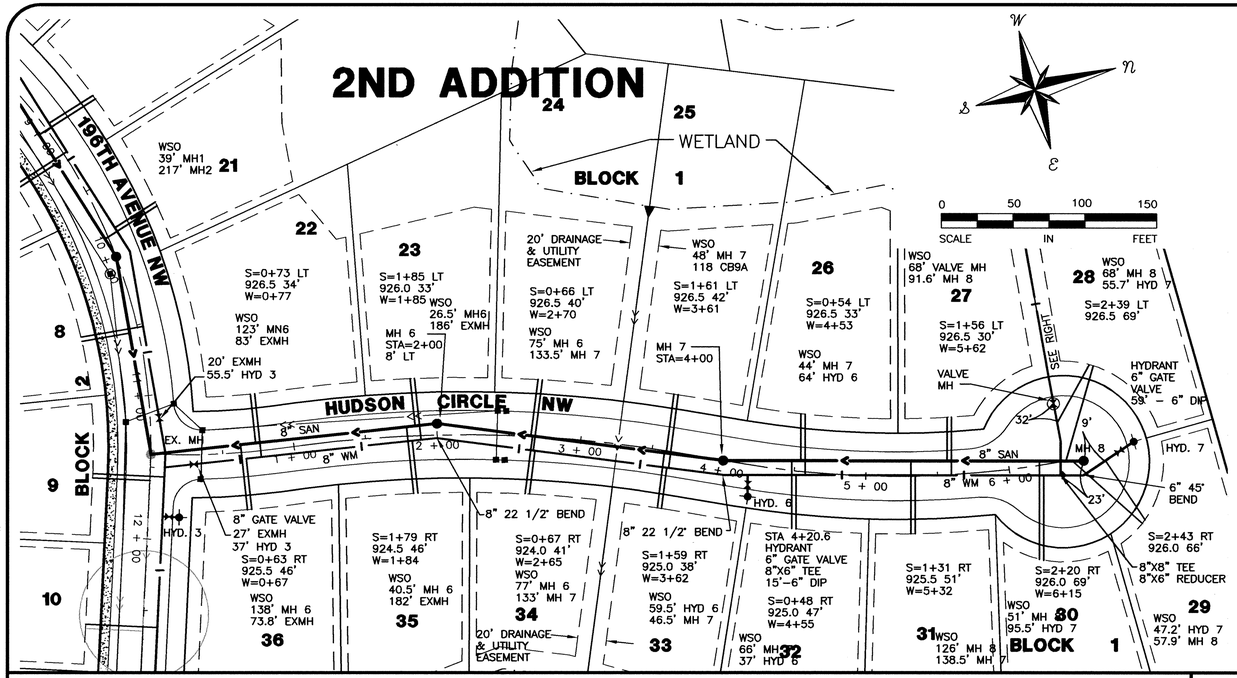

NOTE

1. STATIONING SHOW FOR MANHOLES ON THIS PLAN IS CENTERLINE STREET STATION.
2. SERVICE WYE STATIONING IS FROM DOWNSTREAM MANHOLE.
3. EXTEND SANITARY SEWER AND WATERMAIN SERVICES 10' BEYOND THE PROPERTY LINE. SEE CITY OF ELK RIVER STANDARD PLATE.
4. STATIONING FOR CURB STOPS IS CENTERLINE STREET STATIONING.
5. TOP OF CURB STOPS SHALL BE SET 0.3' ABOVE CENTERLINE AND PLACED ON ROW LINE WITH 10' TAIL UNLESS OTHERWISE DIRECTED BY THE ENGINEER IN THE FIELD.
6. REFER TO PROJECT MANUAL FOR WATERMAIN TESTING REQUIREMENTS.

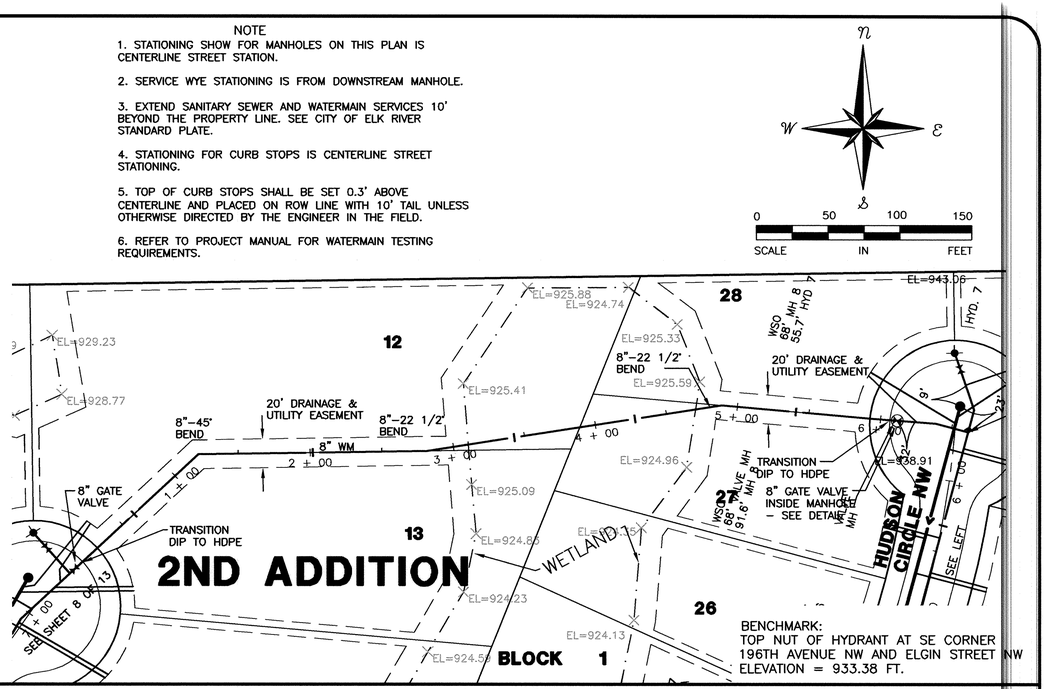

BENCHMARK:
TOP NUT OF HYDRANT AT SE CORNER 196TH AVENUE NW AND ELGIN STREET NW
ELEVATION = 933.38 FT.

SCALES:
1"=50': HOR
1"=5' VER

HUDSON CIRCLE NW

WSO= WATER SHUTT OFF VALVE (CURB STOP)

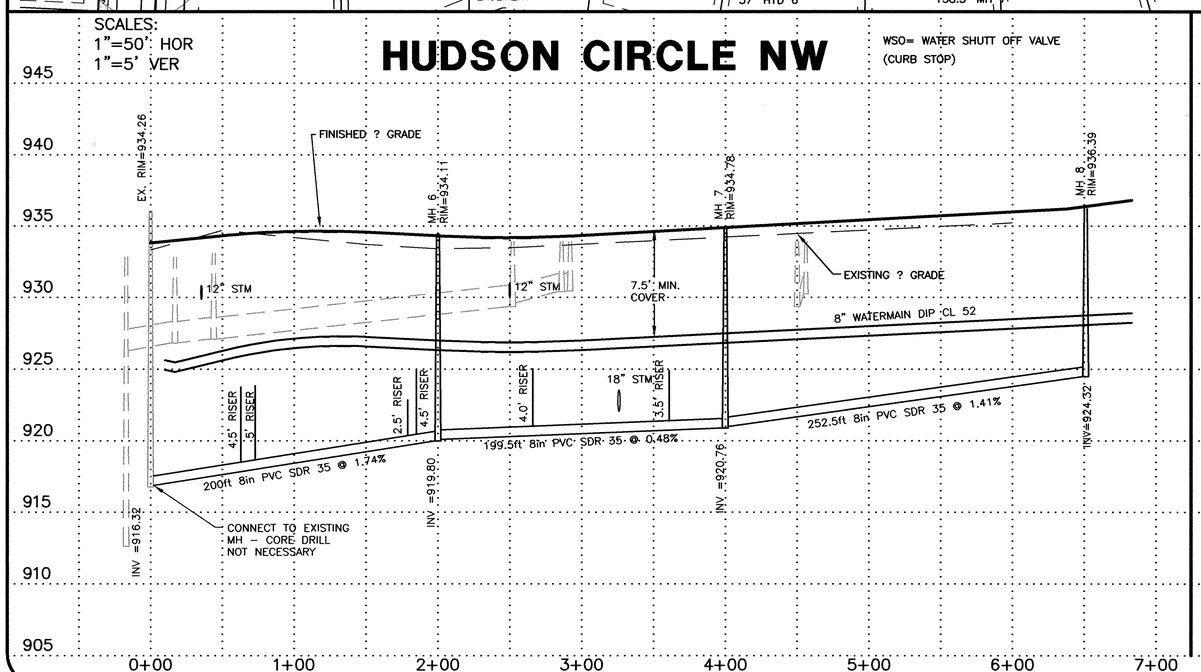

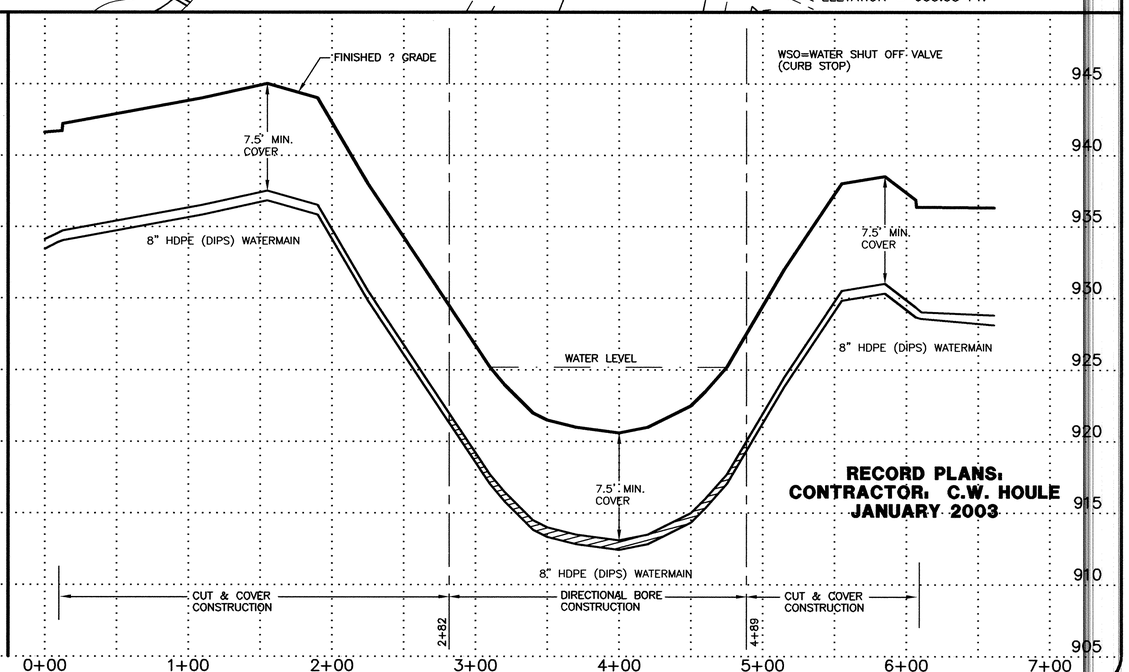

RECORD PLANS:
CONTRACTOR: C.W. HOULE
JANUARY 2003

REVISIONS			
DATE	BY	REVISION
4/25/02	DRL	CITY COMMENTS
5/06/02	DRL	CITY COMMENTS
1-2003	KEJ	RECORD DRAWING
2-2003	CT	RECORD DRAWING CITY REVISIONS

BOOK 567 PAGE 1 (92/36)

I HEREBY CERTIFY THAT THIS PLAN, SPECIFICATION, OR REPORT WAS PREPARED BY ME OR UNDER MY DIRECT SUPERVISION AND THAT I AM A DULY LICENSED PROFESSIONAL ENGINEER UNDER THE LAWS OF THE STATE OF MINNESOTA.
KENNETH ADOLF
DATE: 03-25-02 REG. NO. 12048
REVIEWED BY: _____ DATE _____

F:\ENG\61846\056\1600\SAN01003.DWG, 03/07/03 10:22:32 AM, SherryM, 1:1

SCHOELL & MADSON, INC.
ENGINEERS * SURVEYORS * PLANNING
SOIL TESTING * ENVIRONMENTAL SERVICES
10580 WAYZATA BOULEVARD, SUITE 1
MINNETONKA, MN 55305
(952) 546-7601 FAX: (952) 546-9065
www.schoellmadson.com

OWNER/DEVELOPER
WINDSOR DEVELOPMENT
9145 EDINBURGH LANE
WOODBURY, MN 55125
DATE: MARCH, 2002

PROJECT NAME/SHEET TITLE
WINDSOR OAK HILL 2ND ADDITION
ELK RIVER, MN
SANITARY SEWER & WATERMAIN PLAN

S.M.I. PROJECT NO. 61846-056 SHEET 7 OF 13 SHEETS

DRAWING NUMBER
WINDS2.02
7

DRAWING NUMBER
SAFCO PRODUCTS • NEW HOPE, MINNESOTA
REORDER BY PART NUMBER 63052
DRAWING NUMBER
SAFCO PRODUCTS • NEW HOPE, MINNESOTA
REORDER BY PART NUMBER 63052
DRAWING NUMBER
SAFCO PRODUCTS • NEW HOPE, MINNESOTA
REORDER BY PART NUMBER 63052