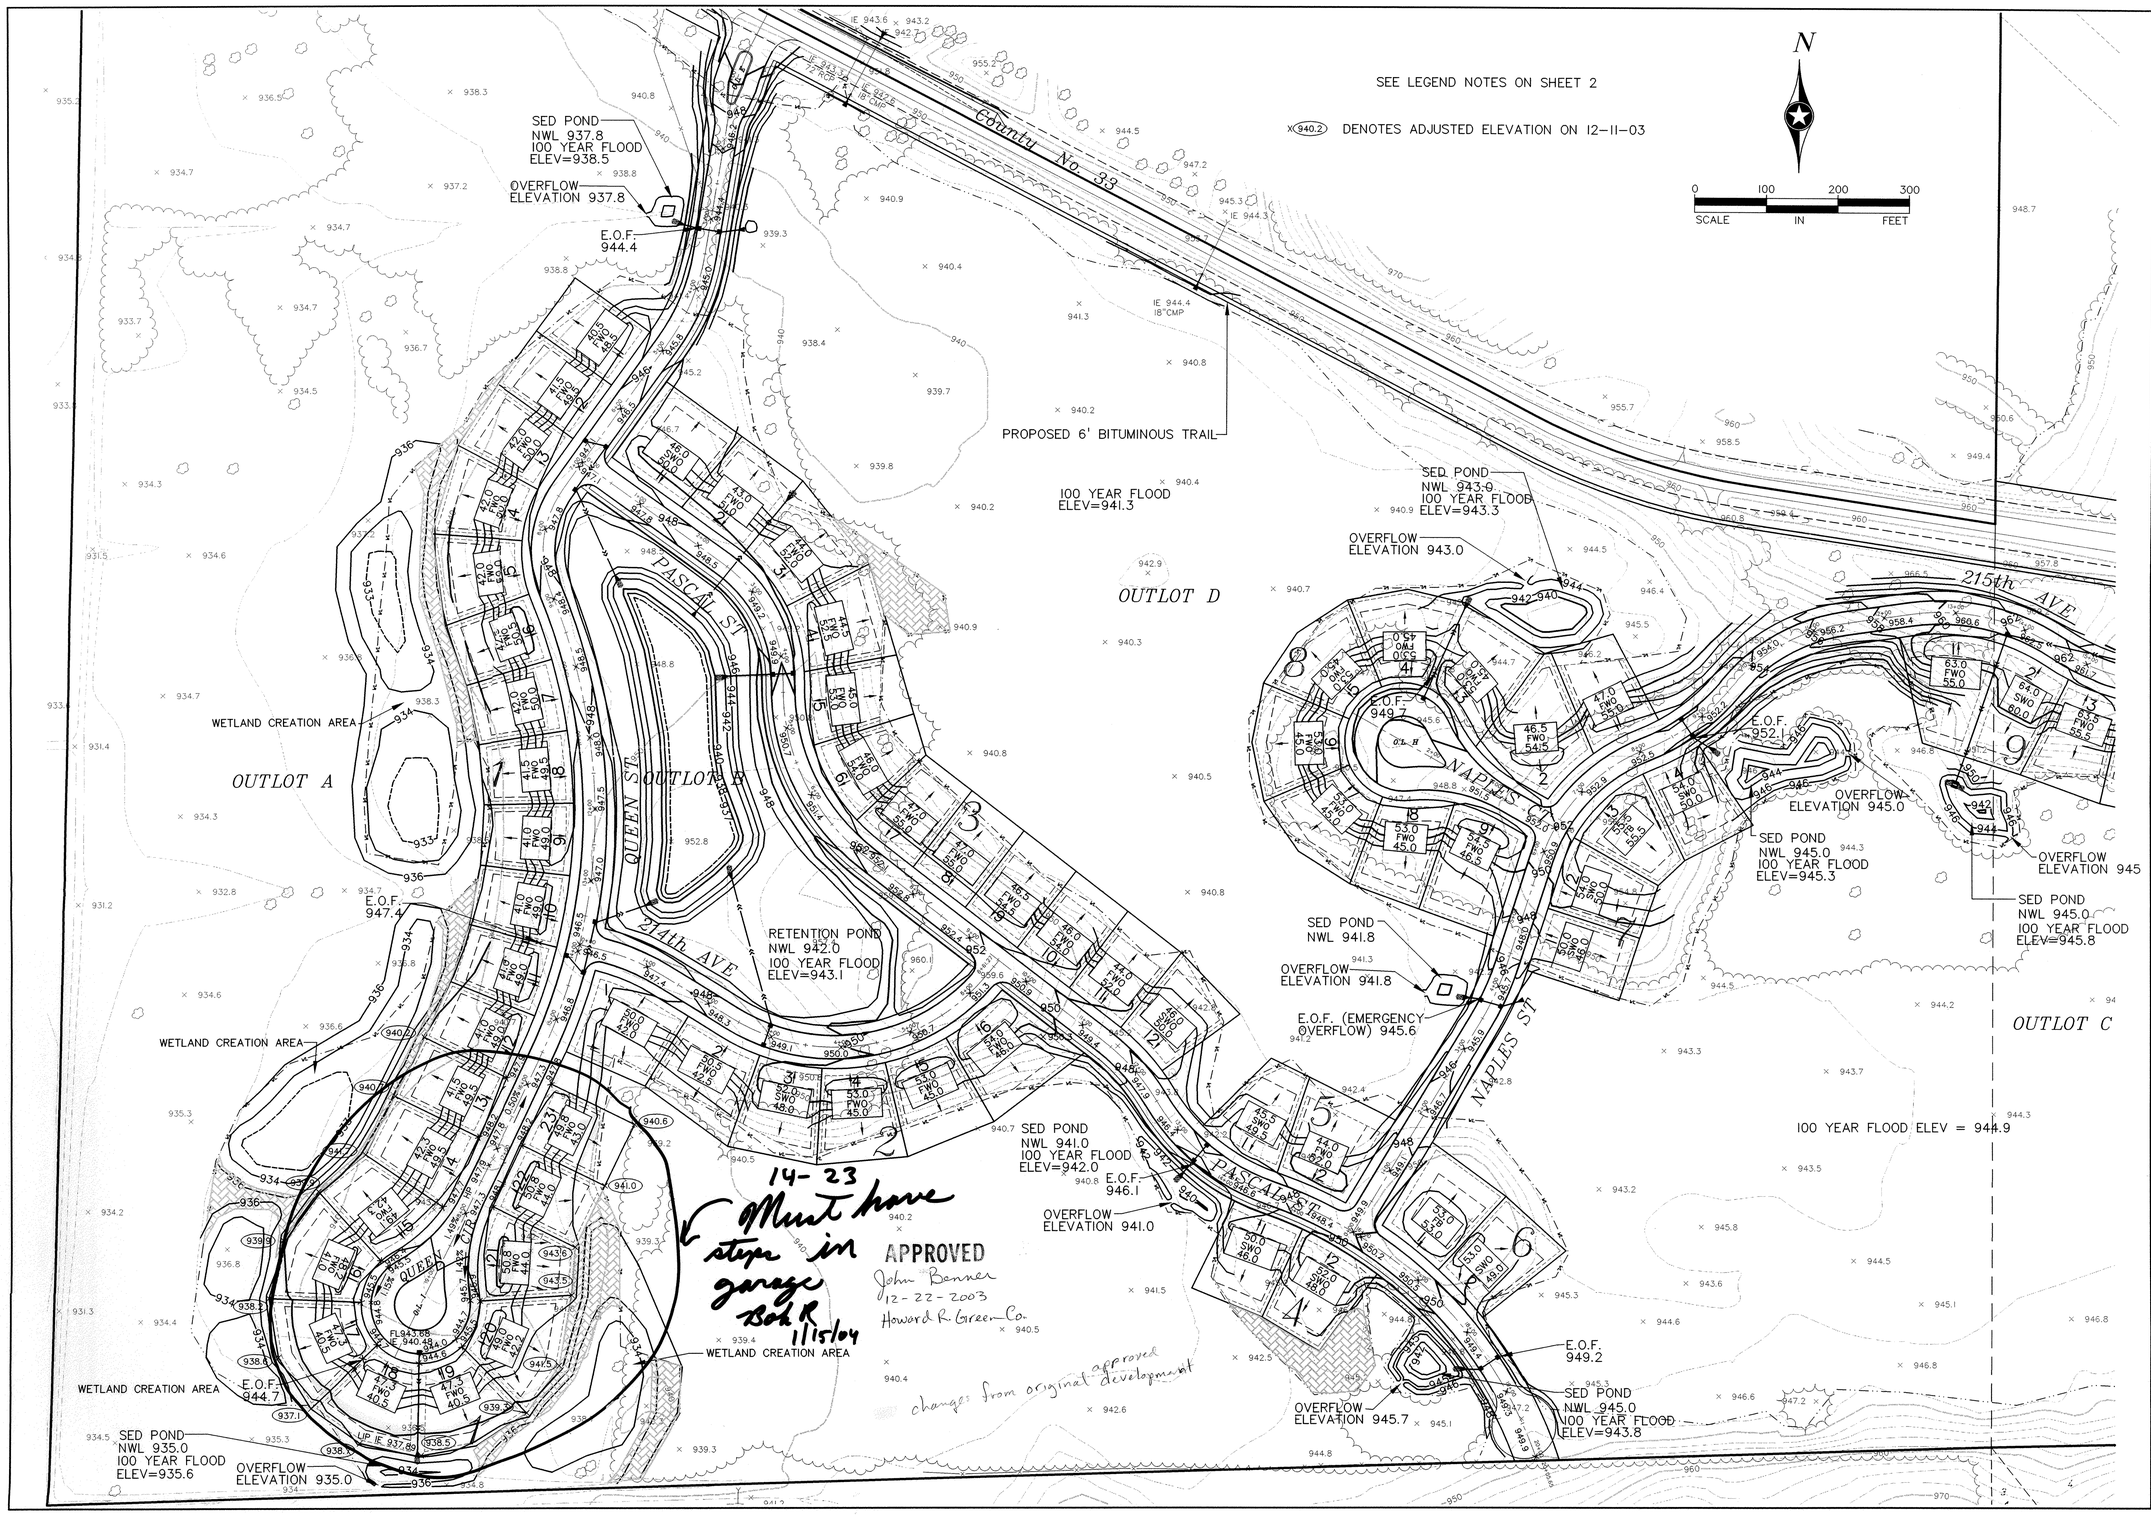

REV NO.	DATE	DESCRIPTION
1	12-11-03	HSE PADS & REAR ELEVATIONS ADJUSTED
		LOTS 13-23 BLK 1

DATE: DATE 9/26/02
DESIGN BY: JKB,PG,GB
DRAWN BY: JRH
CHECKED BY: CCO,JKB
DWG FILE: dev_plan_02
FILE NO.: 101304.0

I hereby certify that this plan was prepared by me or under my direct supervision and that I am a duly Licensed Professional Engineer under the laws of the State of Minnesota.

Signed: Gary Bogart
Date: 12/11/03 Reg. No. 41929

BOGART, PEDERSON & ASSOCIATES, INC.
LAND SURVEYING
CIVIL ENGINEERING
MAPPING
13076 FIRST STREET, BECKER, MN 55308-9322
TEL: 763-262-8822 FAX: 763-262-8844

WINDSOR PARK 3RD ADD.
CITY OF ELK RIVER, MN.
DYNAMICS DESIGN & LAND CO.

DEVELOPMENT PLAN

SHEET NO. 2 / 2

January 13, 2004
File: 916950J-0240