


DEVELOPMENT PLAN THE WOODS AT HILLSIDE

CITY OF ELK RIVER
SHERBURNE COUNTY, MN

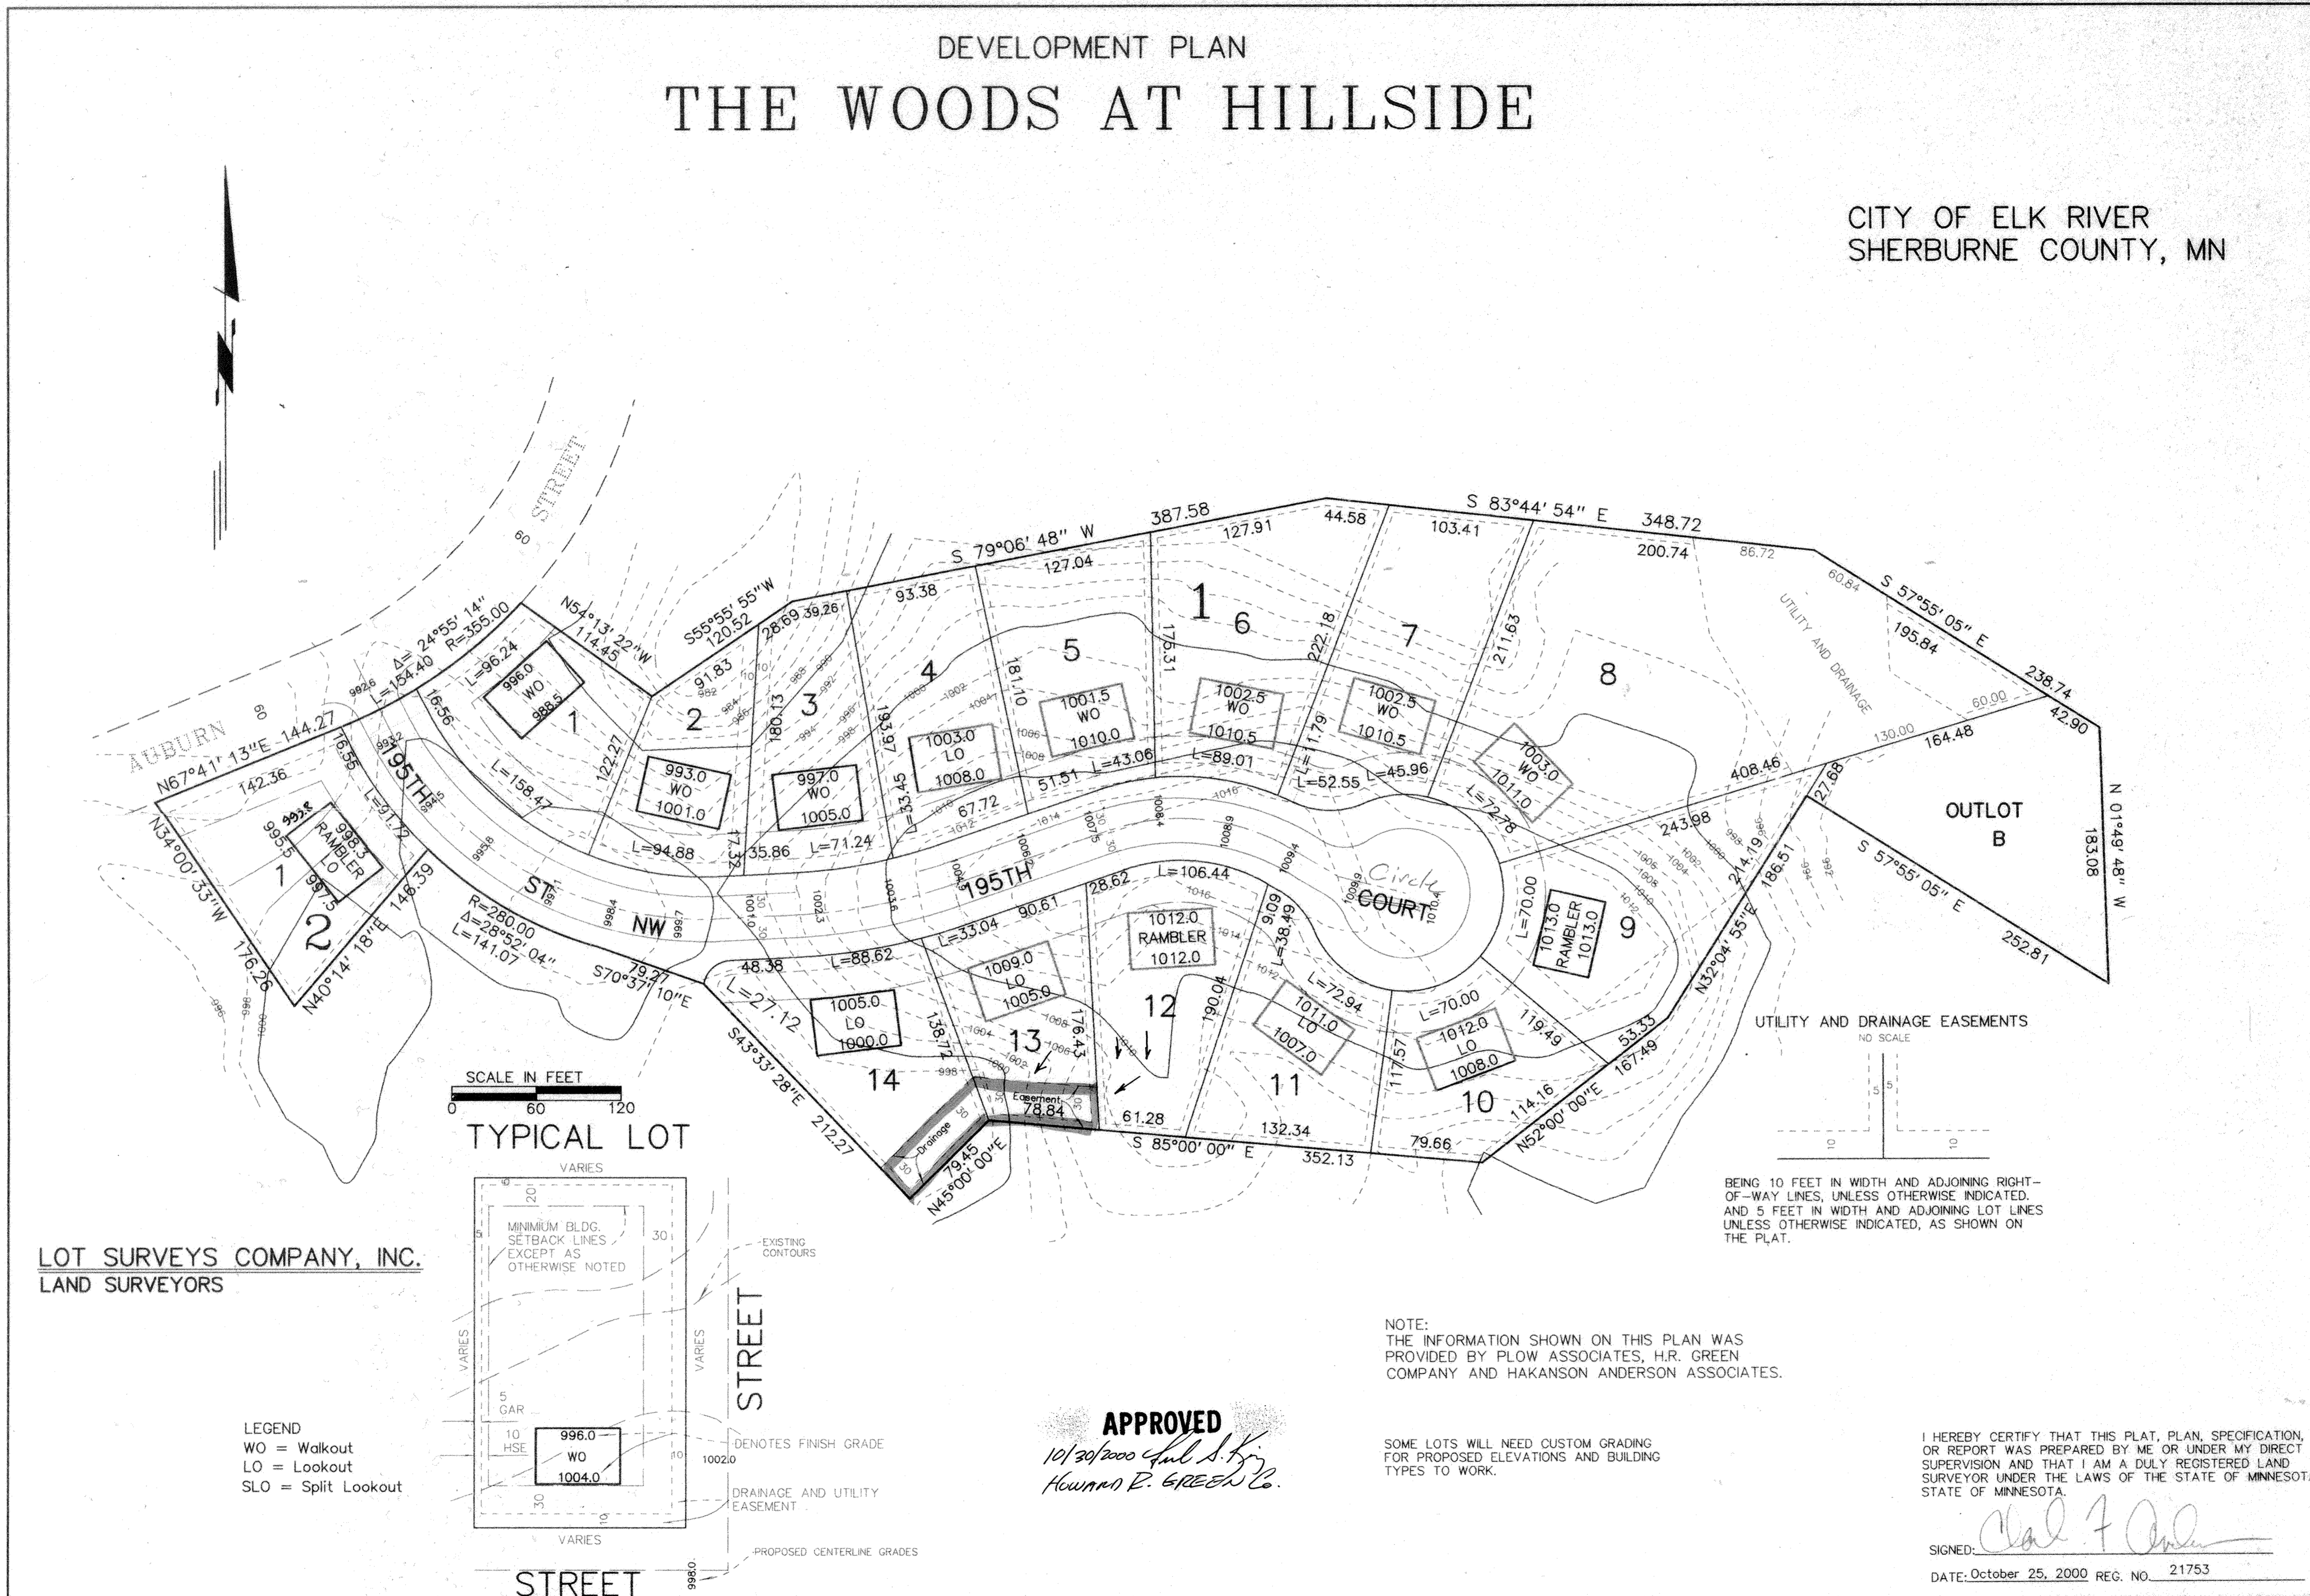

LOT SURVEYS COMPANY, INC.
LAND SURVEYORS