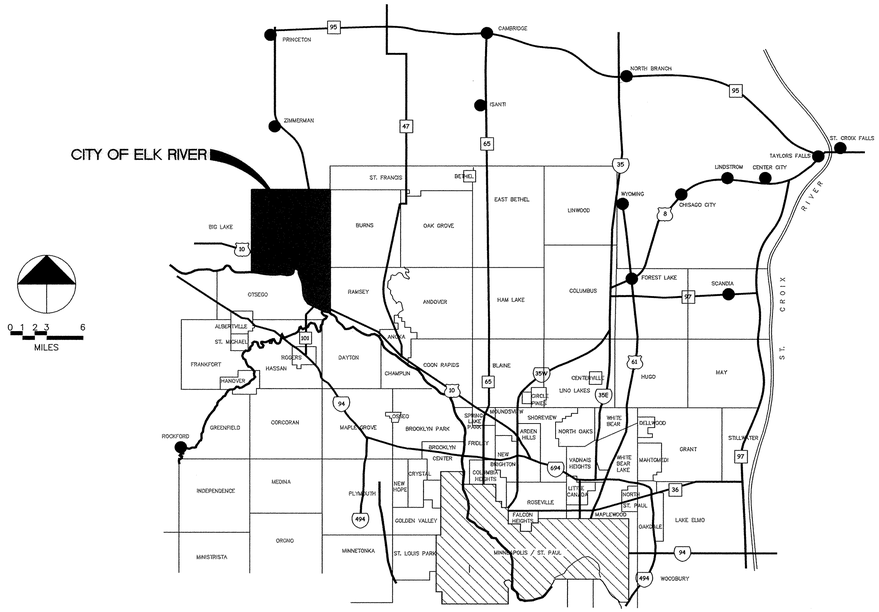

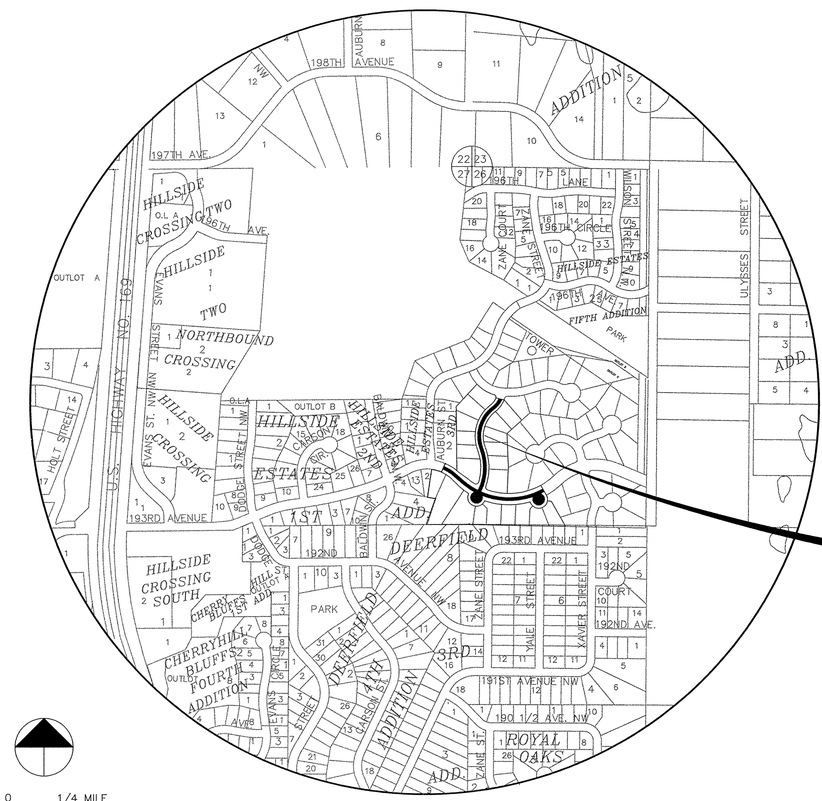

PROJECT LOCATION

193RDTH STREET NW./ZANE AVENUE
LOCATION MAP

ASBUILT NOTE:

SAN. SERVICE ELEVATIONS SHOWN ON LOTS ARE TO THE INVERT OF THE 45° BEND AT ENDS OF SERVICES. SIX (6) FOOT RISER PIPES EXTEND UPWARD FROM THE 45° BENDS.
ALL TIES ARE TO THE CURB BOX. SAN. SERVICES ARE IN THE SAME TRENCH 1-3 FT DOWNSTREAM OF THE WATER SERVICE.
SAN. SERVICES ON 193RD AVE SET NO HIGHER THAN 1.5 FT. ABOVE SERVICE WYE ON MAINLINE.
SAN. SERVICES ON ZANE AVE SET A MINIMUM OF TEN (10) FT. BELOW C/L EXCEPT AT WYES 7+05 WEST: 992.0' - 4.8 FT BELOW C/L AND 7+03 EAST: 992.0' - 5.8 FT BELOW C/L.

THE WOODS OF HILLSIDE II

193RD STREET NW.
ZANE AVENUE

SANITARY SEWER, WATERMAIN, STORM SEWER AND STREET CONSTRUCTION

I HEREBY CERTIFY THAT THIS PLAN, SPECIFICATION, OR REPORT WAS PREPARED BY ME OR UNDER MY DIRECT SUPERVISION AND THAT I AM A DULY REGISTERED PROFESSIONAL ENGINEER UNDER THE LAWS OF THE STATE OF MINNESOTA.

DATE _____ REG.NO. 15316

1326 ENERGY PARK DRIVE
ST. PAUL, MINNESOTA 55108
(651) 644-4389
Howard R. Green Company
CONSULTING ENGINEERS

PREPARED FOR:

City of Elk River

SEPTEMBER 2000

SHEET 1 OF 11

RECORD PLAN
MARCH 2002

September 08, 2000 11:09:13 a.m.
811380\811380-T.DWG

DRAWING NUMBER
SAFCO PRODUCTS • NEW HOPE, MINNESOTA
REORDER BY PART NUMBER 6532
PROTECTION EDGE OF PRINT ON THIS LINE

DRAWING NUMBER
SAFCO PRODUCTS • NEW HOPE, MINNESOTA
REORDER BY PART NUMBER 6532
PROTECTION EDGE OF PRINT ON THIS LINE

DRAWING NUMBER
SAFCO PRODUCTS • NEW HOPE, MINNESOTA
REORDER BY PART NUMBER 6532
PROTECTION EDGE OF PRINT ON THIS LINE

DRAWING NUMBER
WOODS2.00
1
SAFCO PRODUCTS • NEW HOPE, MINNESOTA
REORDER BY PART NUMBER 6532
PROTECTION EDGE OF PRINT ON THIS LINE