XAVIER COURT

SEE SHEET 5

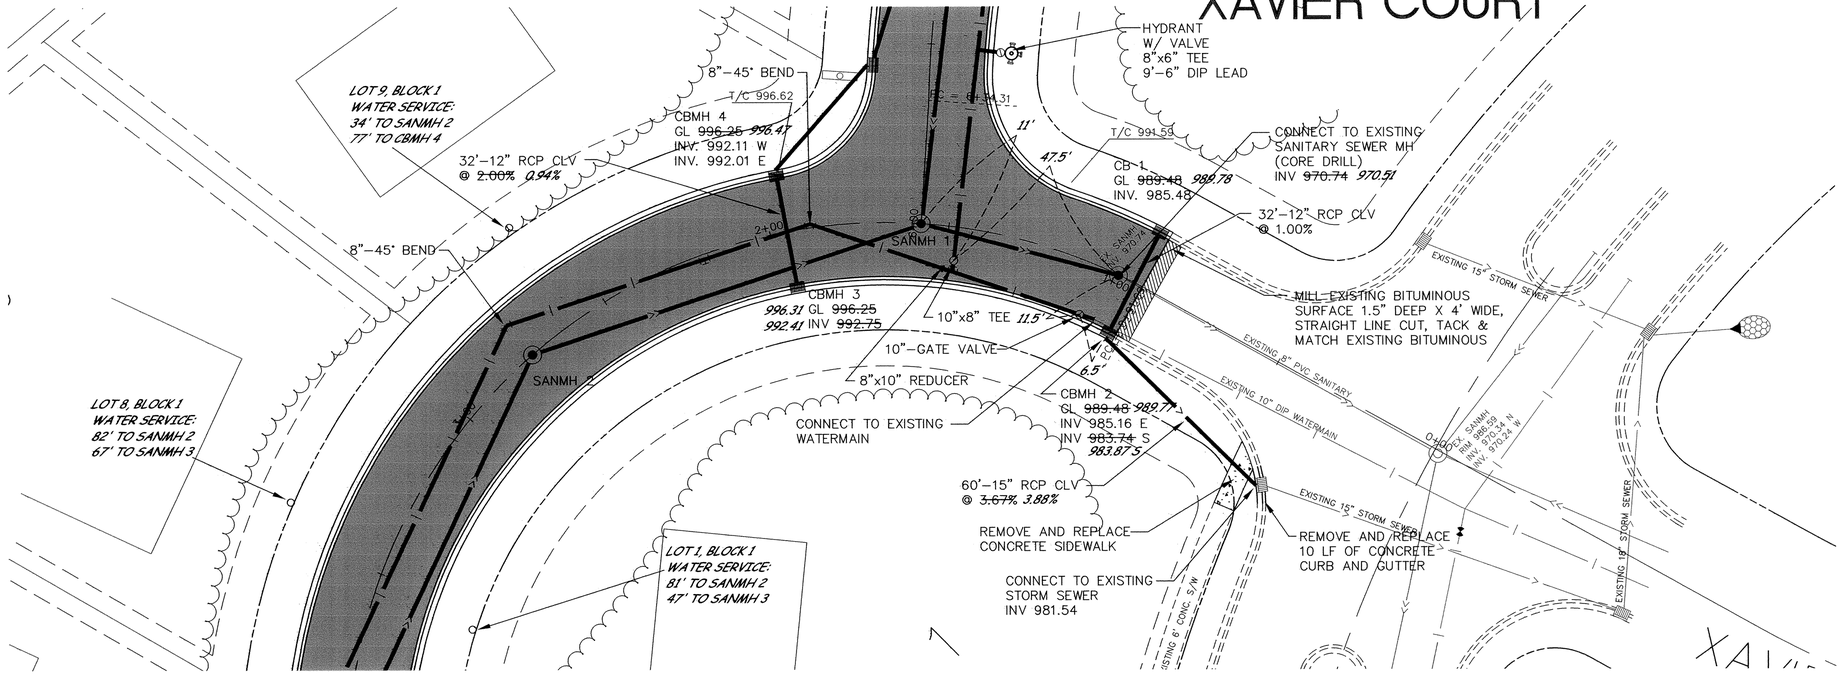

SEE SHEET 4

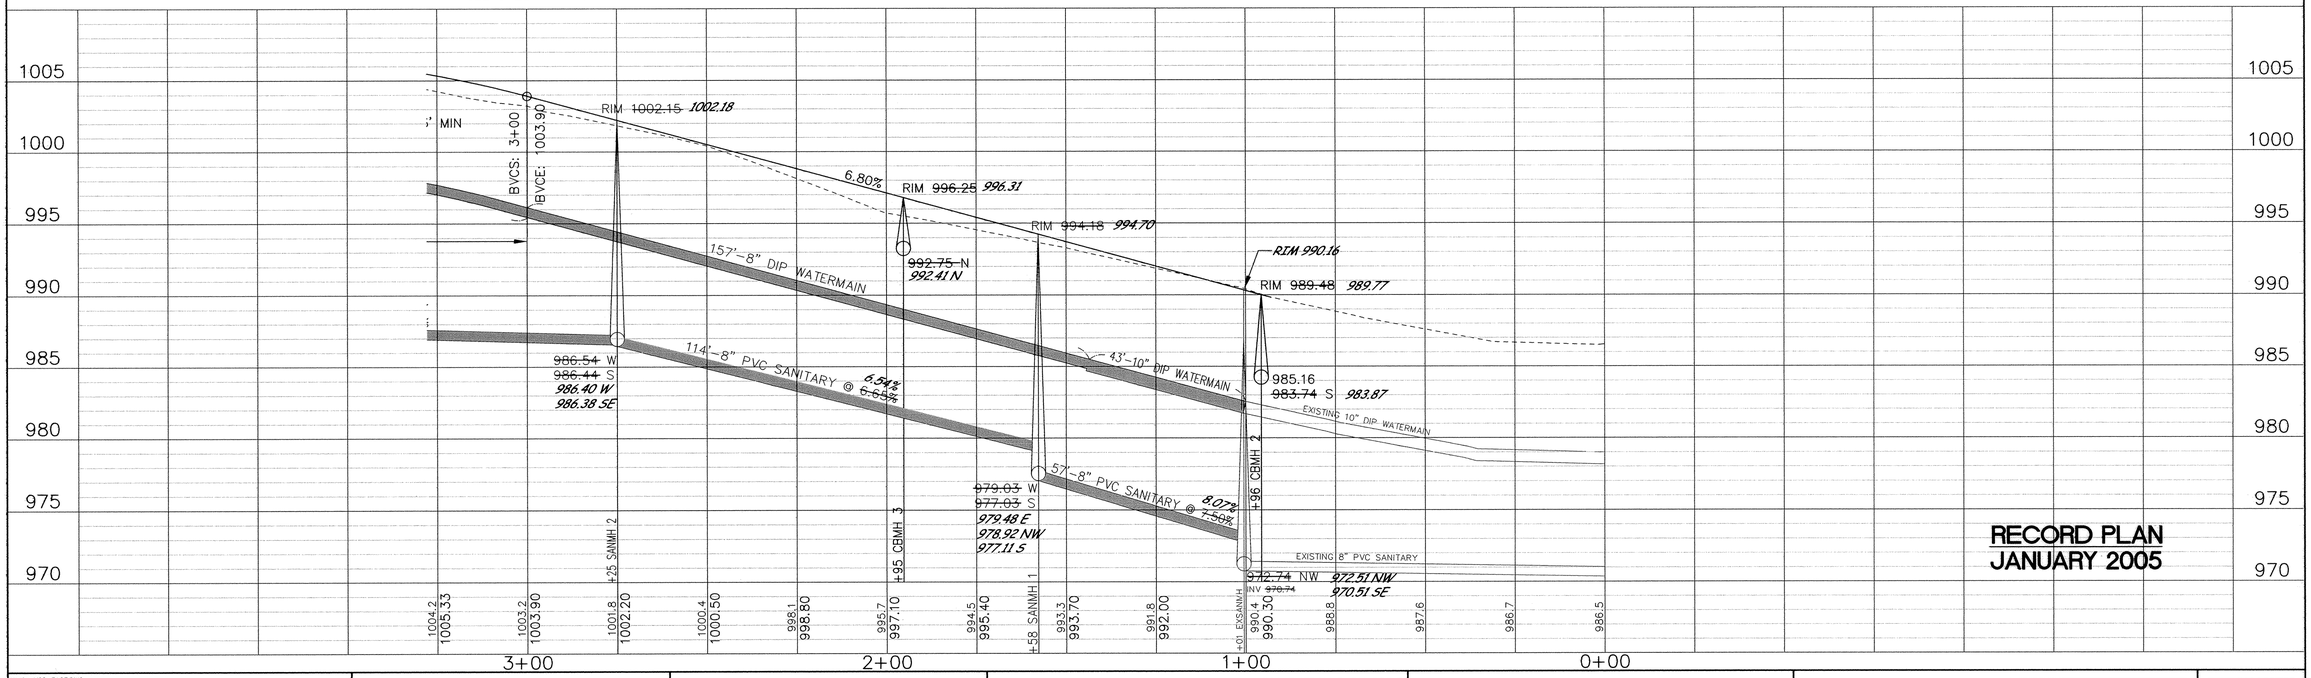

RECORD PLAN
JANUARY 2005

Xrefs: XCS-BASE.DWG

DESIGNED BY: DESIGNED BY DRAWN BY: RKM
APPROVED BY: APPROVED BY JOB NUMBER 811388J
CAD DATE: January 06, 2005 12:13:09 p.m.
CAD FILE: 811388J\As-Built\Dwgs\C\CT-D01.DWG (JCUNNIN)

I HEREBY CERTIFY THAT THIS PLAN, SPECIFICATION, OR REPORT WAS PREPARED BY ME OR UNDER MY DIRECT SUPERVISION AND THAT I AM A DULY LICENSED PROFESSIONAL ENGINEER UNDER THE LAWS OF THE STATE OF MINNESOTA.

SIGNATURE _____ DATE 2/2/05
PRINTED NAME JOHN M. ANDERSON LIC.NO. 25889

NO.	DATE	BY	REVISION DESCRIPTION

Howard R. Green Company
1326 ENERGY PARK DRIVE
ST. PAUL, MINNESOTA 55108
(651) 644-4389

THE WOODS OF HILLSIDE IV
CITY OF ELK RIVER

PLAN AND PROFILE
XAVIER COURT
0+00 TO 3+00

SHEET NO. 3

DRAWING NUMBER
WOODS4.05
3

SAFCO PRODUCTS • NEW HOPE, MINNESOTA
REORDER BY PART NUMBER 65002
POSITION EDGE OF PRINT ON THIS LINE