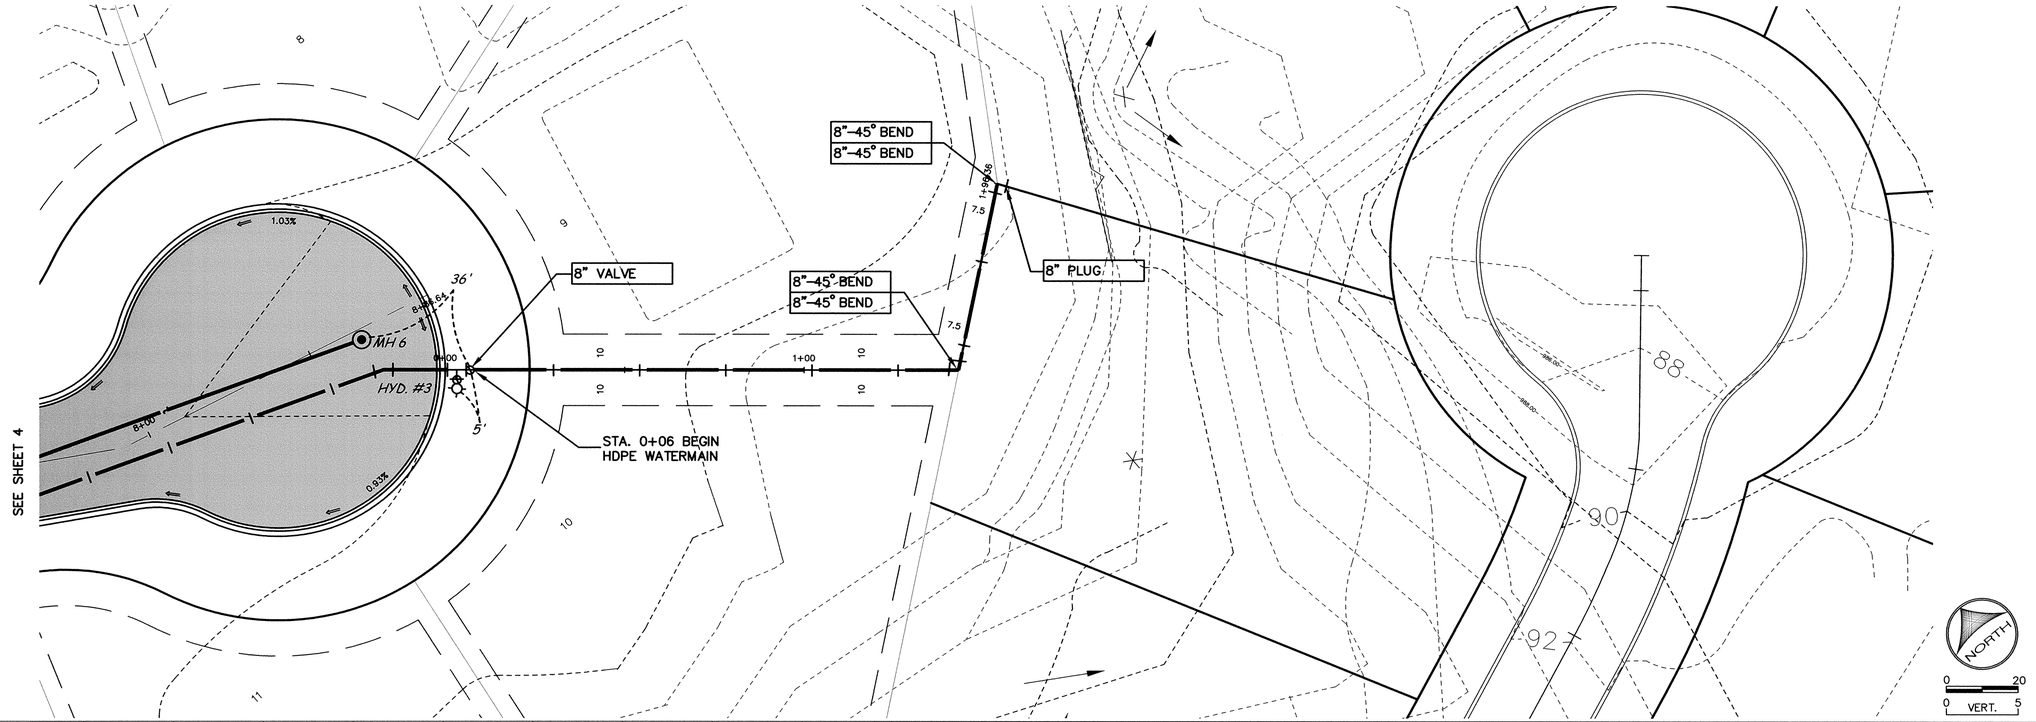

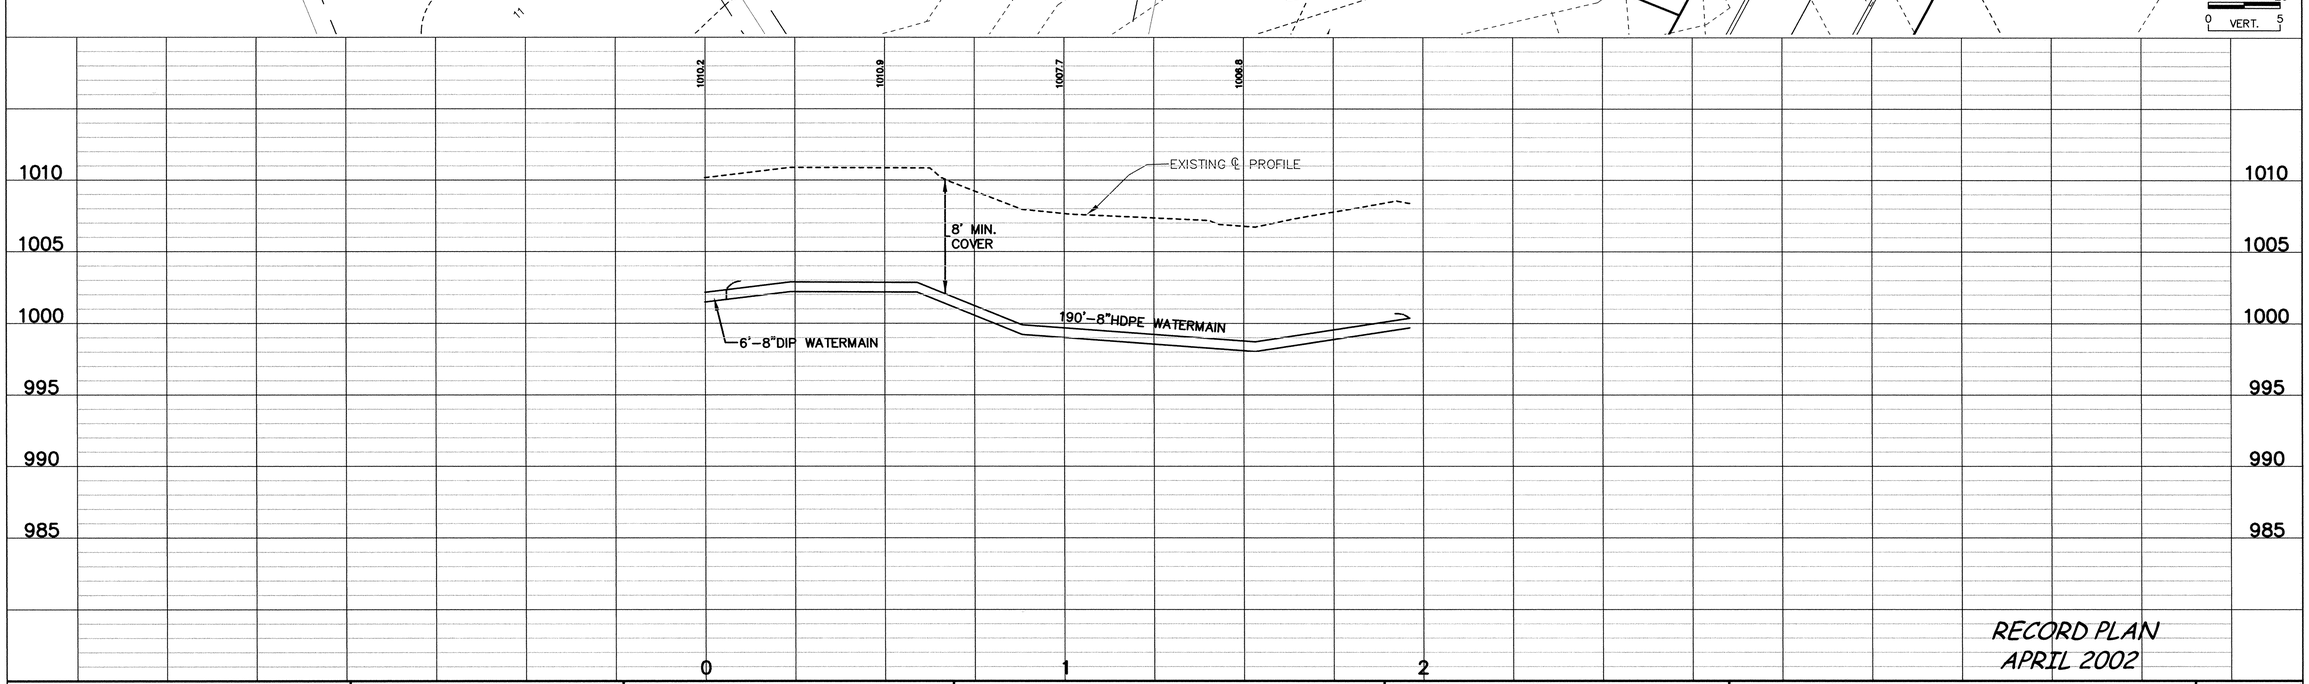

RECORD PLAN
APRIL 2002

Xrefs: 804411-A.DWG

DESIGNED BY: – DRAWN BY: EY
APPROVED BY: – JOB NUMBER 804411J
CAD DATE: April 15, 2002 9:25:55 a.m.
CAD FILE: 804411j\asbuilt_dwgs\AB-804411-P3.DWG

I HEREBY CERTIFY THAT THIS PLAN, SPECIFICATION, OR REPORT WAS PREPARED BY ME OR UNDER MY DIRECT SUPERVISION AND THAT I AM A DULY REGISTERED PROFESSIONAL ENGINEER UNDER THE LAWS OF THE STATE OF MINNESOTA.

DATE _____ REG.NO. 15316

NO.	DATE	BY	REVISION DESCRIPTION

1326 ENERGY PARK DRIVE
ST. PAUL, MINNESOTA 55108
(651) 644–4389
Howard R Green Company
CONSULTING ENGINEERS

CITY OF ELK RIVER
THE WOODS AT HILLSIDE
STREET AND UTILITY IMPROVEMENTS

PLAN AND PROFILE
WATERMAIN LOOP
STA. 0+00 TO STA. 2+28.97

SHEET NO. 5 OF 9

DRAWING NUMBER

DRAWING NUMBER WOODS1.00 5

SAFCO PRODUCTS • NEW HOPE, MINNESOTA
REORDER BY PART NUMBER 63502
POSITION EDGE OF PRINT ON THIS LINE