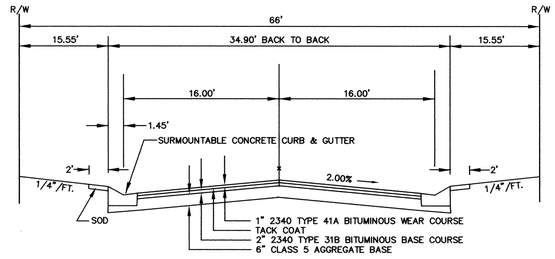

TYPICAL STREET SECTION

NOTE :

B618 CONCRETE CURB AND GUTTER SHALL BE PLACED AROUND RADII AND AT STORM SEWER STRUCTURES.

RECORD PLAN
APRIL 2002

DESIGNED BY: – DRAWN BY: EY
APPROVED BY: – JOB NUMBER 804411J
CAD DATE: April 15, 2002 9:27:46 a.m.
CAD FILE: 804411\asbuilt_dwgs\AB-804411-L.DWG

I HEREBY CERTIFY THAT THIS PLAN, SPECIFICATION, OR REPORT WAS PREPARED BY ME OR UNDER MY DIRECT SUPERVISION AND THAT I AM A DULY REGISTERED PROFESSIONAL ENGINEER UNDER THE LAWS OF THE STATE OF MINNESOTA.

DATE _____ REG.NO. 15316

NO.	DATE	BY	REVISION DESCRIPTION

1326 ENERGY PARK DRIVE
ST. PAUL, MINNESOTA 55108
(651) 644-4389
Howard R. Green Company
CONSULTING ENGINEERS

CITY OF ELK RIVER
THE WOODS AT HILLSIDE
STREET AND UTILITY IMPROVEMENTS

SHEET INDEX, TYPICAL SECTION, NOTES

SHEET NO. 2 OF 9

DRAWING NUMBER

SACO PRODUCTS • NEW HOPE, MINNESOTA
REORDER BY PART NUMBER 6552
POSITION EDGE OF PRINT ON TITEL LINE

DRAWING NUMBER

SACO PRODUCTS • NEW HOPE, MINNESOTA
REORDER BY PART NUMBER 6552
POSITION EDGE OF PRINT ON TITEL LINE

DRAWING NUMBER
WOODS1.00
2

SACO PRODUCTS • NEW HOPE, MINNESOTA
REORDER BY PART NUMBER 6552
POSITION EDGE OF PRINT ON TITEL LINE