INDEX OF DRAWINGS

	DRAWING NO	DRAWING TITLE
GENERAL	TD	TITLE DRAWING
	1	INDEX OF DRAWINGS
	2	TYPICAL SECTIONS AND GENERAL INFORMATION
REMOVALS	3	UPLAND AVENUE TOPOGRAPHY & REMOVALS
	4	UPLAND AVENUE & FIFTH STREET TOPOGRAPHY & REMOVALS
	5	TIPTON AVENUE TOPOGRAPHY & REMOVALS
	6	TIPTON AVENUE & FIFTH STREET TOPOGRAPHY AND REMOVALS
	7	FIFTH STREET TOPOGRAPHY AND REMOVALS
	8	FIFTH STREET TOPOGRAPHY AND REMOVALS
	9	NORFOLK AVENUE & OXFORD AVENUE TOPOGRAPHY AND REMOVALS
	10	PROCTOR AVENUE & QUINN AVENUE TOPOGRAPHY AND REMOVALS
	11	RUSH AVENUE & SEYMOUR AVENUE TOPOGRAPHY AND REMOVALS
PLAN & PROFILE	12	UPLAND AVENUE PLAN & PROFILE STATION 0+00 TO STATION 5+00
	13	UPLAND AVENUE PLAN AND PROFILE STATION 5+00 TO STATION 10+00
	14	UPLAND AVENUE PLAN & PROFILE STATION 10+00 TO STATION 14+34.19
	15	FIFTH STREET PLAN & PROFILE STATION 15+00 TO STATION 18+32.39
	16	TIPTON AVENUE PLAN & PROFILE STATION 20+00 TO STATION 23+50
	17	TIPTON AVENUE PLAN & PROFILE STATION 23+50 TO STATION 26+00
	18	TIPTON AVENUE PLAN & PROFILE STATION 26+00 TO STATION 28+50
	19	FIFTH STREET PLAN & PROFILE STATION 30+64.92 TO STATION 36+00
	20	FIFTH STREET PLAN & PROFILE STATION 36+00 TO STATION 41+00
	21	FIFTH STREET PLAN & PROFILE STATION 41+00 TO STATION 46+00
	22	FIFTH STREET PLAN & PROFILE STATION 46+00 TO STATION 51+00
	23	FIFTH STREET PLAN & PROFILE STATION 51+00 TO STATION 55+
	24	NORFOLK AVENUE PLAN & PROFILE STATION 60+00 TO STATION 62+99

INDEX OF DRAWINGS

	DRAWING NO	DRAWING TITLE
PLAN & PROFILE	25	OXFORD AVENUE PLAN & PROFILE STATION 70+00 TO STATION 71+90.21
	26	QUINN AVENUE PLAN & PROFILE STATION 70+00 TO STATION 71+90
	27	RUSH AVENUE PLAN & PROFILE STATION 90+00 TO STATION 93+00
	28	SEYMOUR AVENUE PLAN & PROFILE STATION 100+00 TO STATION 103+18
	29	PLAN & PROFILE HIGHWAY 10 WATERMAIN JACKING
STORM SEWER PROFILES	30	STORM SEWER CROSSING PROFILES
	31	STORM SEWER CROSSING PROFILES
INTERSECTION DETAILS	32	INTERSECTION DETAILS
	33	INTERSECTION DETAILS
	34	INTERSECTION DETAILS
	35	INTERSECTION DETAILS
CROSS SECTIONS	36	CROSS SECTIONS UPLAND AVENUE
	37	CROSS SECTIONS UPLAND AVENUE
	38	CROSS SECTIONS UPLAND AVENUE
	39	CROSS SECTIONS UPLAND AVENUE
	40	CROSS SECTIONS FIFTH STREET (STATION 15+00 TO STATION 18+32)
	41	CROSS SECTIONS TIPTON AVENUE
	42	CROSS SECTIONS TIPTON AVENUE
	43	CROSS SECTIONS TIPTON AVENUE
	44	CROSS SECTIONS FIFTH STREET
	45	CROSS SECTIONS FIFTH STREET
	46	CROSS SECTIONS FIFTH STREET

INDEX OF DRAWINGS

	DRAWING NO	DRAWING TITLE
CROSS SECTIONS	47	CROSS SECTIONS FIFTH STREET
	48	CROSS SECTIONS FIFTH STREET
	49	CROSS SECTIONS FIFTH STREET
	50	CROSS SECTIONS FIFTH STREET
	51	CROSS SECTIONS OXFORD AVENUE
	52	CROSS SECTIONS NORFOLK AVENUE
	53	CROSS SECTIONS QUINN AVENUE
	54	CROSS SECTIONS RUSH AVENUE
	55	CROSS SECTION VOLUMES
	56	CROSS SECTION VOLUMES
STANDARD DETAILS	57	WATERMAIN DETAILS
	58	STREET DETAILS
	59	STORM SEWER DETAILS
TABULATIONS	60	STORM SEWER TABULATIONS

NOTE: 12 THIS NUMBER AS SEEN BELOW IS THE PLAN AND PROFLE DRAWING NUMBER.

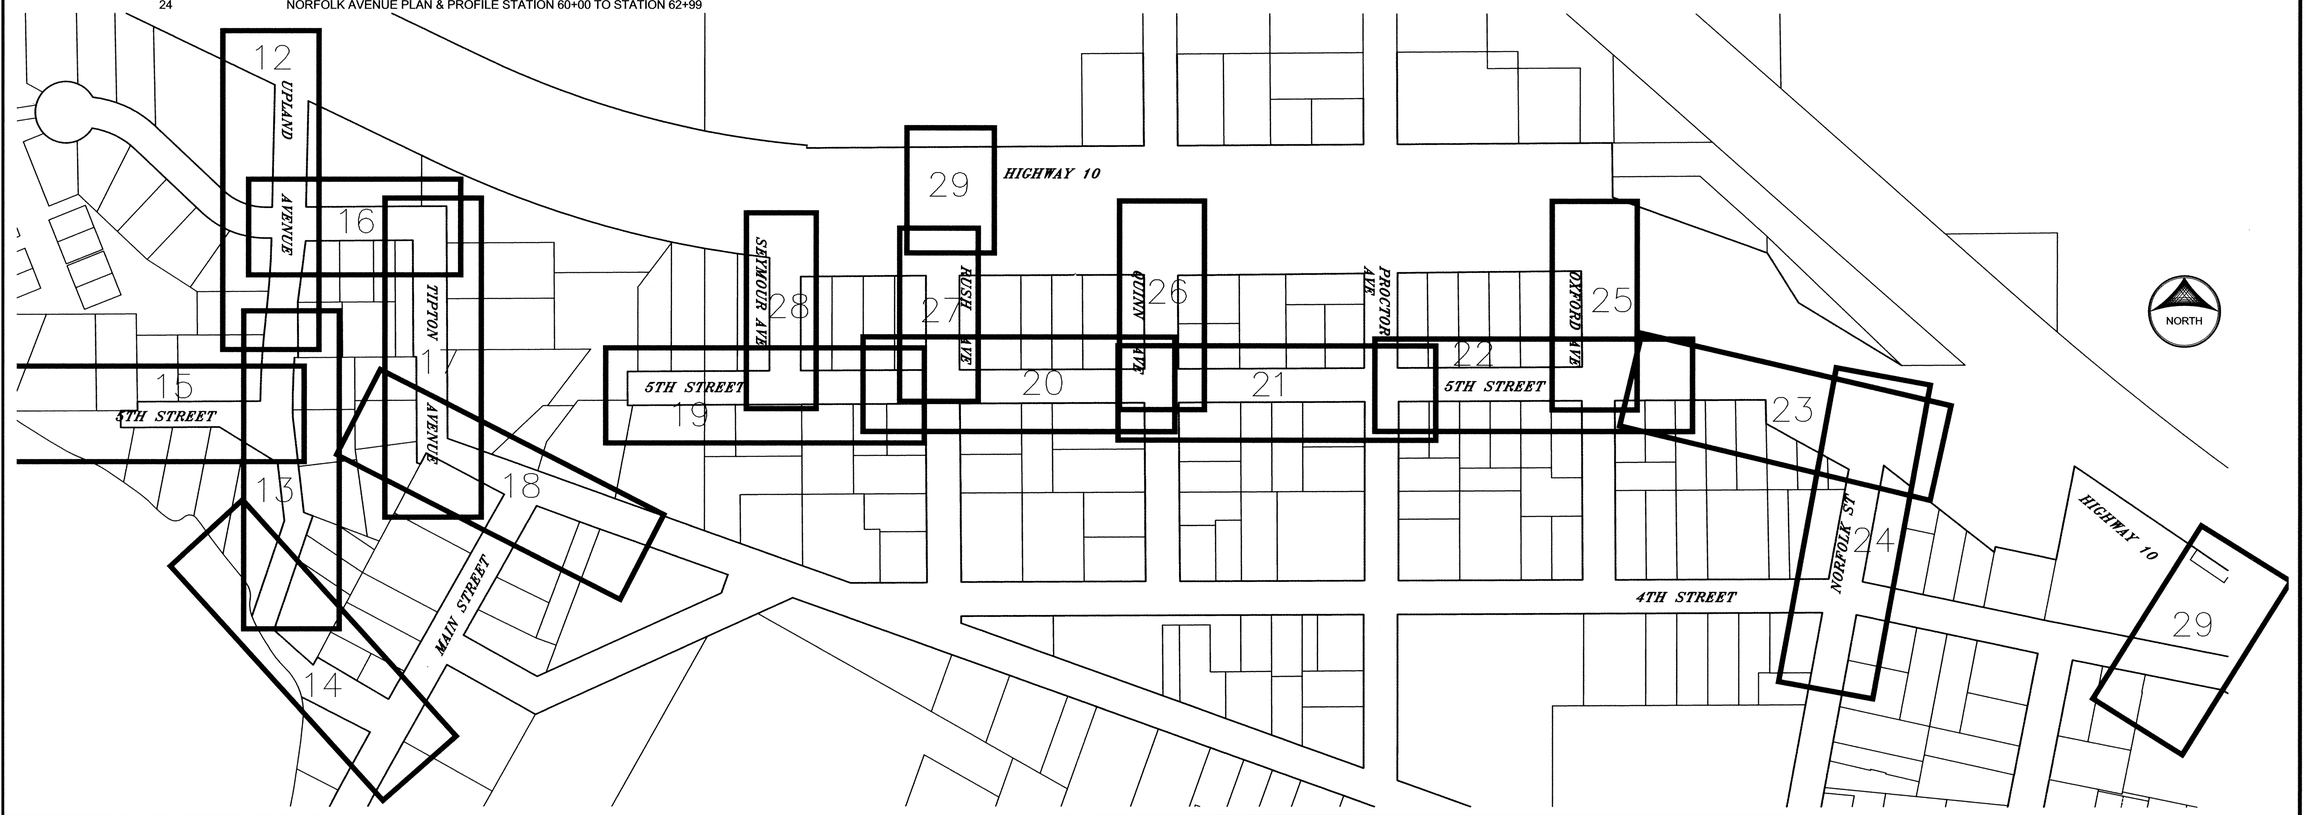

DESIGNED BY: JMA	DRAWN BY: LAK		
APPROVED BY: JMA	JOB NUMBER 824180J		
CAD DATE: April 01, 2005 10:29:37 a.m.			
CAD FILE: 824180j\Dwgs\C\CT-01.DWG (JANDERS)			

I HEREBY CERTIFY THAT THIS PLAN, SPECIFICATION, OR REPORT WAS PREPARED BY ME OR UNDER MY DIRECT SUPERVISION AND THAT I AM A DULY LICENSED PROFESSIONAL ENGINEER UNDER THE LAWS OF THE STATE OF MINNESOTA.

SIGNATURE _____ DATE 7/2/07

PRINTED NAME JOHN M. ANDERSON, P.E. LIC.NO. 25889

NO.	DATE	BY	REVISION DESCRIPTION

Howard R. Green Company
2550 UNIVERSITY AVENUE W, SUITE 400N
ST. PAUL, MINNESOTA 55114
(651) 644-4389

RECORD PLAN
2005 STREET IMPROVEMENTS
CITY OF ELK RIVER

DRAWING INDEX

SHEET NO. 1

DRAWING NUMBER
SAFCO PRODUCTS • NEW HOPE, MINNESOTA
REORDER BY PART NUMBER 65302
POSITION SIDE OF PART ON THIS LINE

DRAWING NUMBER
SAFCO PRODUCTS • NEW HOPE, MINNESOTA
REORDER BY PART NUMBER 65302
POSITION SIDE OF PART ON THIS LINE

DRAWING NUMBER
MAINS.05
02
SAFCO PRODUCTS • NEW HOPE, MINNESOTA
REORDER BY PART NUMBER 65302
POSITION SIDE OF PART ON THIS LINE