UPLAND AVENUE

MILL EXISTING BITUMINOUS SURFACE 1.5" X 4' WIDE, STRAIGHT LINE CUT, TACK AND MATCH EXISTING BITUMINOUS

18" SOLID WHITE STRIPE

4" WIDE SOLID WHITE STRIPE

4" WIDE SOLID DOUBLE YELLOW STRIPE

HIGHWAY 10

0+00 (B/B)

0+50

1+00

1+50

2+00

2+50

3+00

3+10

3+50

4+00

4+50

5+00

5+50

36.00'(B/B)

30.58'(B/B)

B-1

B-2

CONCRETE PEDESTRIAN RAMP (TYP)

HOUSE

STORM CROSSING E SEE DRAWING 30

CB5

TIPTON AVENUE SEE DRAWING 16

STMH4

STMH6

ADJUST GATE VALVE

STORM CROSSING A SEE DRAWING 30

CB7

PC = 1+59.58

PT

1+89 BEGIN TAPPER

2+85 END TAPPER

TAPER END OF CURB 5' (TYP.)

MILL EXISTING BITUMINOUS SURFACE 1.5" X 4' WIDE, STRAIGHT LINE CUT, TACK AND MATCH EXISTING BITUMINOUS

MATCH EXISTING CURB & GUTTER

ADJUST FRAME & RING CASTING, REMOVE 4 RINGS EX. TOP 893.18 PROP. TOP ~~892.52~~ 892.30

MATCH EXISTING CURB & GUTTER

ADJUST FRAME & RING CASTING, REMOVE 2 RINGS EX. TOP 891.15 PROP. TOP ~~891.50~~ 890.48

WATERMAIN

INSTALL SIGN (STREET)

INSULATE WATERMAIN 360 S.F.

4' x 24' INSULATION

4 x 8 INSULATION ON WATER SERVICE TO 519

DELETE STORM.

STATION 5+00

MATCHLINE SEE DRAWING 13

EX.SAN.MH TOP 893.18 INV E 885.28 INV N 885.42 INV NW 885.42 2 RINGS=1.65"

EX.SAN.MH TOP 891.15 INV S 882.95 SERVICE E 875.81 2 RINGS=0.4'

#633 #1705 #577 #519 #520

HOUSE GARAGE FFE 894.20 GARAGE FFE 893.34 GARAGE FFE 890.61 GARAGE FFE 887.6

43' CONC DWY #519 20' CONC DWY 19' CONC DWY 19' BIT DWY 12' CONC DWY

RETAINING WALL

ELECTRIC VAULT

12" EVGRN 14" EVGRN 20" EVGRN 24" TREE 36" TREE 20" TREE 18" TREE 12" TREE 10" TREE 2" TREE 6" EVGRN 5" EVGRN 4" EVGRN

UGT UGTV UGE UGM UGG GAS W/M

NORTH 0 20 VERT. 0 3

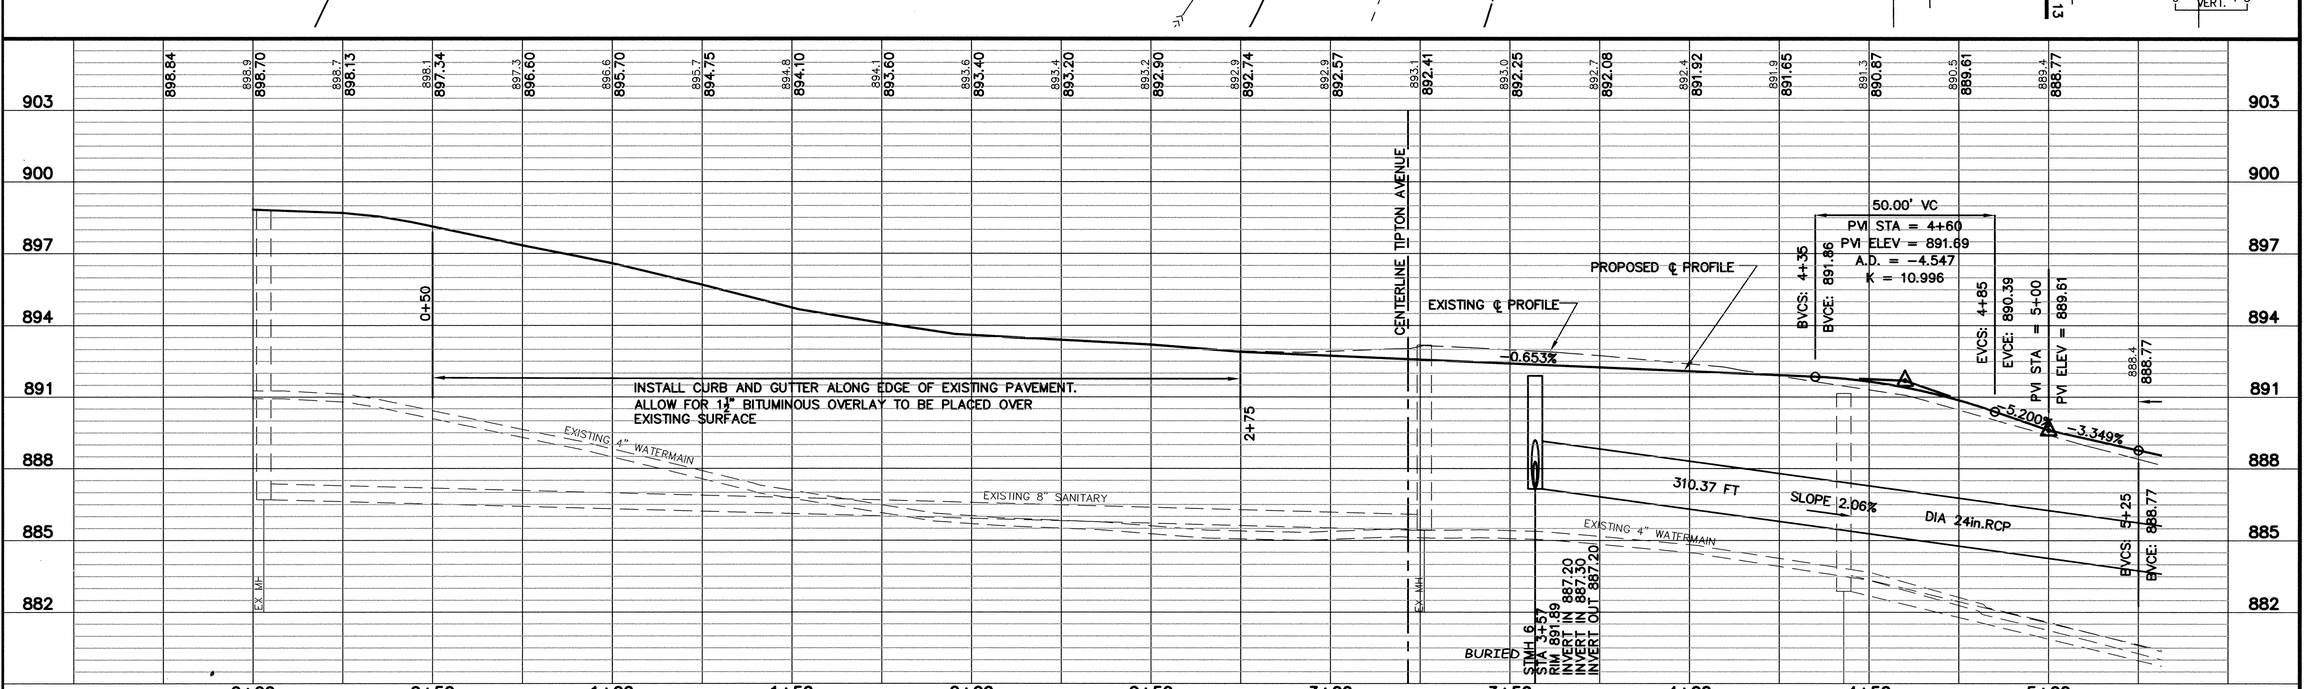

DESIGNED BY: JMA DRAWN BY: LAK
APPROVED BY: JMA JOB NUMBER 824180J
CAD DATE: March 31, 2005 12:39:04 p.m.
CAD FILE: 824180j\Dwgs\C\CT-12.DWG (TLAMKIN)

I HEREBY CERTIFY THAT THIS PLAN, SPECIFICATION, OR REPORT WAS PREPARED BY ME OR UNDER MY DIRECT SUPERVISION AND THAT I AM A DULY LICENSED PROFESSIONAL ENGINEER UNDER THE LAWS OF THE STATE OF MINNESOTA.
SIGNATURE _____ DATE 2/2/07
PRINTED NAME JOHN M. ANDERSON, P.E. LIC.NO. 25889

NO.	DATE	BY	REVISION DESCRIPTION

2550 UNIVERSITY AVENUE W, SUITE 400N
ST. PAUL, MINNESOTA 55114
(651) 644-4389
Howard R. Green Company

RECORD PLAN
2005 STREET IMPROVEMENTS
CITY OF ELK RIVER

STATION 0+00 TO STATION 5+00
PLAN AND PROFILE
UPLAND AVENUE

SHEET NO. 12

DRAWING NUMBER

SAFCO PRODUCTS • NEW HOPE, MINNESOTA
REORDER BY PART NUMBER 65502
PRINTED SIDE UP FROM THIS LINE

DRAWING NUMBER

MAINS.05
04

SAFCO PRODUCTS • NEW HOPE, MINNESOTA
REORDER BY PART NUMBER 65502
PRINTED SIDE UP FROM THIS LINE

DRAWING NUMBER

SAFCO PRODUCTS • NEW HOPE, MINNESOTA
REORDER BY PART NUMBER 65502
PRINTED SIDE UP FROM THIS LINE