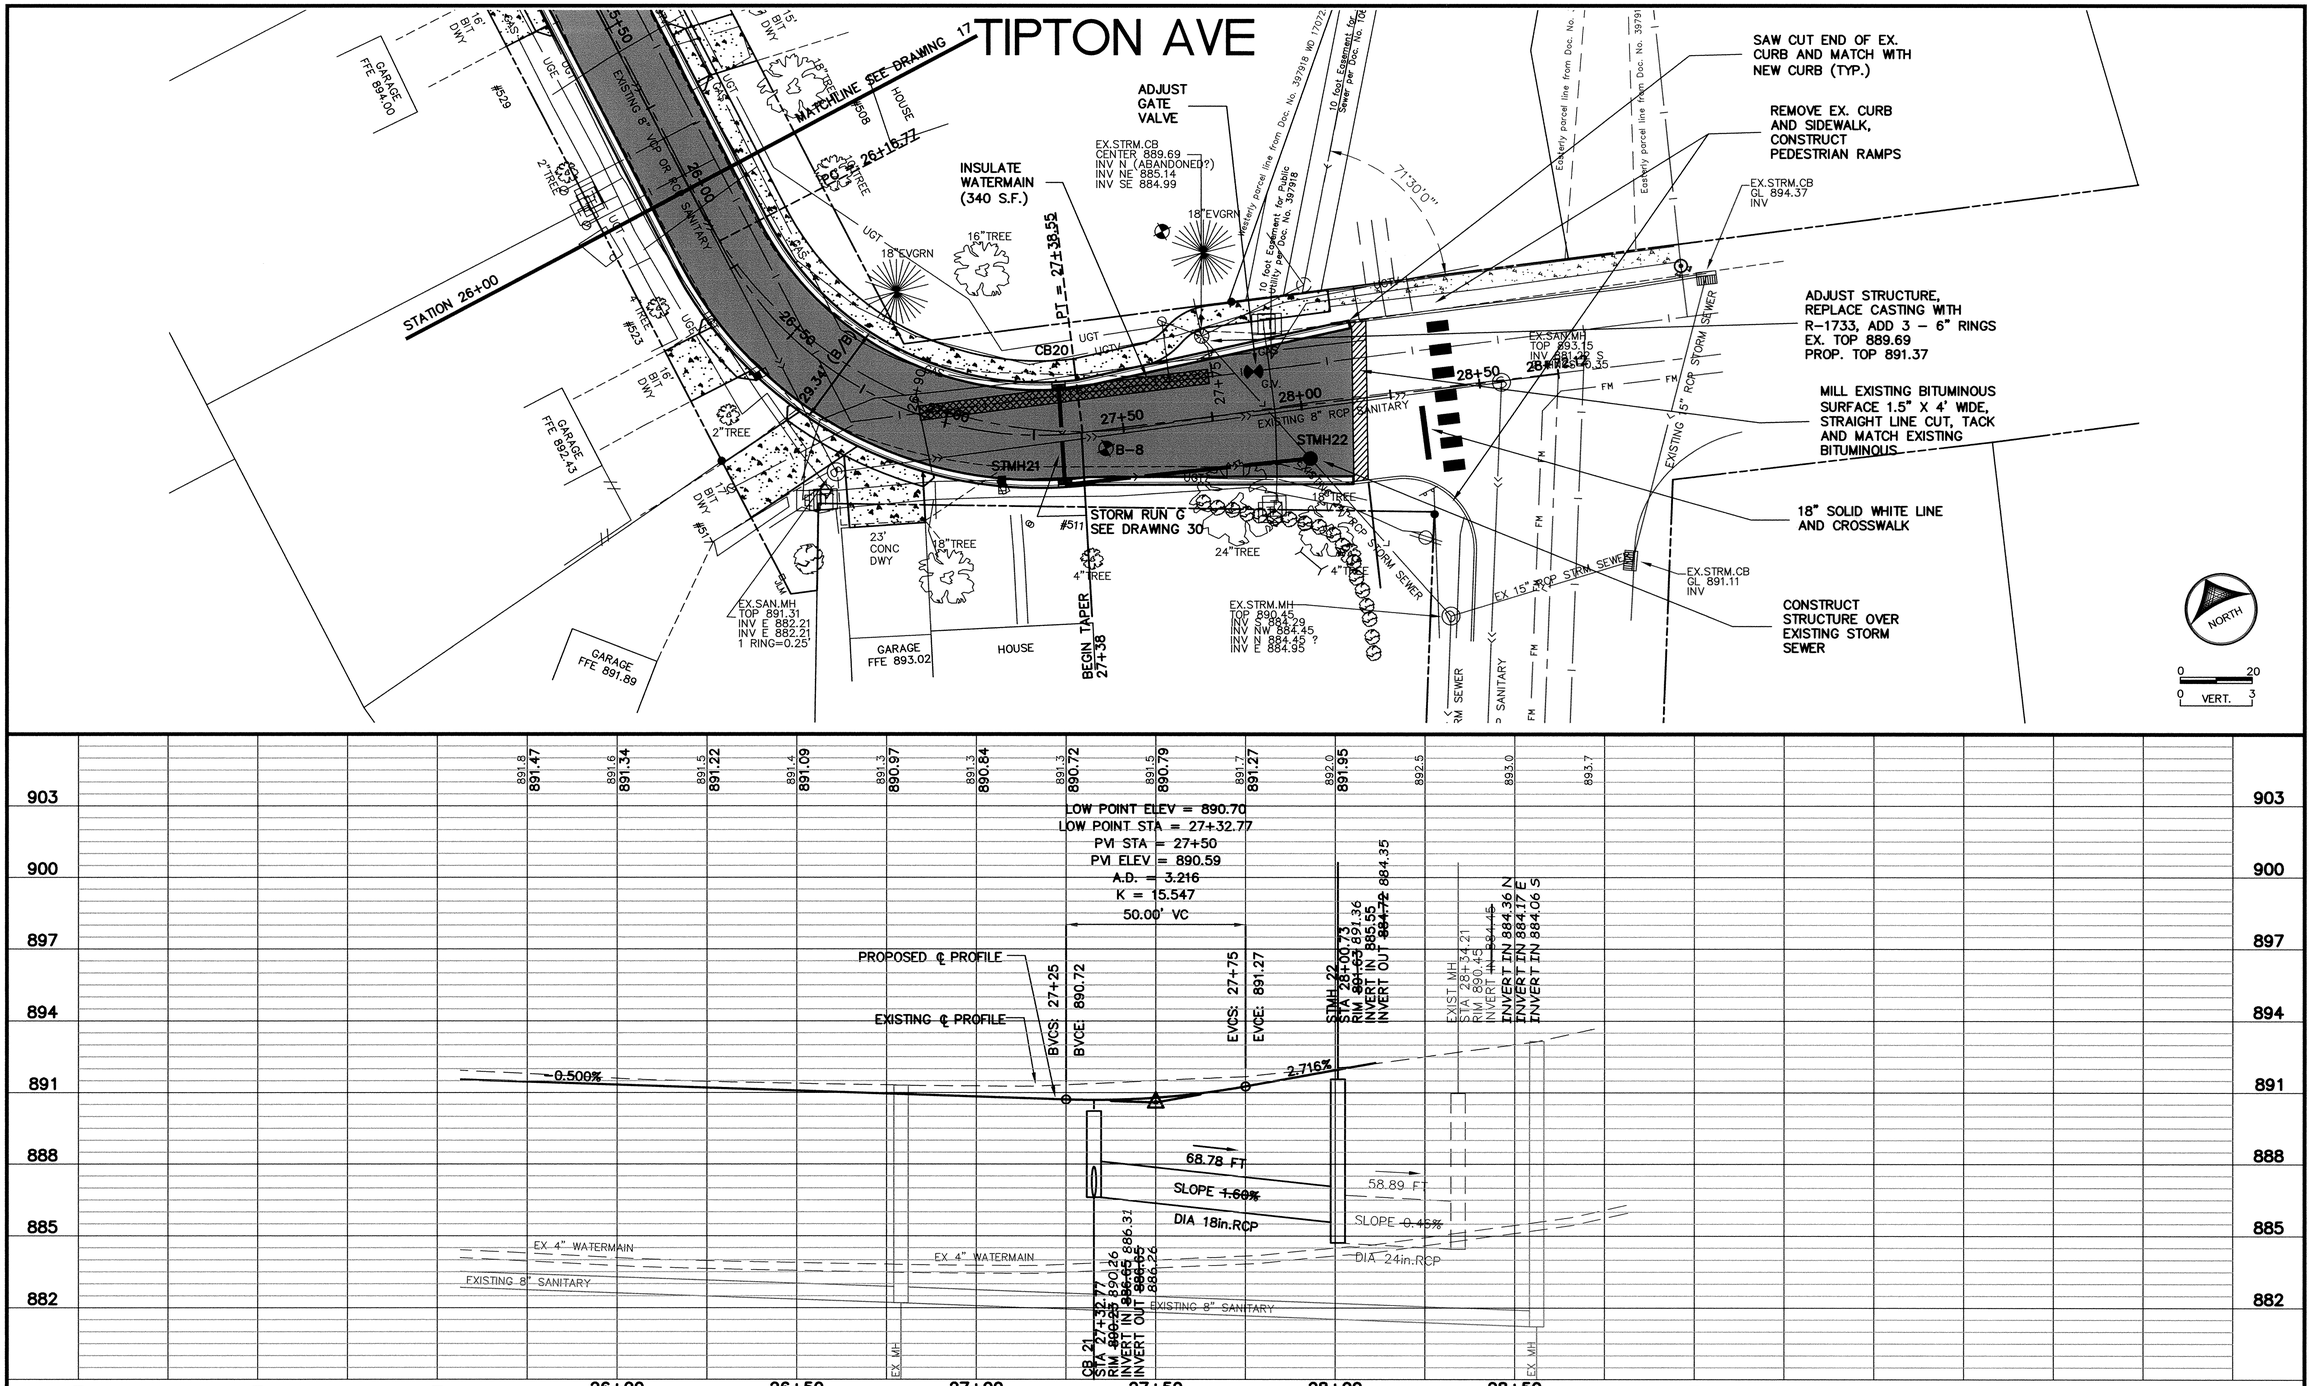

DESIGNED BY: JMA DRAWN BY: LAK
APPROVED BY: JMA JOB NUMBER 25889
CAD DATE: March 07, 2005 4:59:00 p.m.
CAD FILE: C:\824180j\C\CT-E07.DWG (LKIEWEL)

I HEREBY CERTIFY THAT THIS PLAN, SPECIFICATION, OR REPORT WAS PREPARED BY ME OR UNDER MY DIRECT SUPERVISION AND THAT I AM A DULY LICENSED PROFESSIONAL ENGINEER UNDER THE LAWS OF THE STATE OF MINNESOTA.

SIGNATURE [signature] DATE 2/2/07

PRINTED NAME JOHN M. ANDERSON, P.E. LIC.NO. 25889

NO.	DATE	BY	REVISION DESCRIPTION

2550 UNIVERSITY AVENUE W, SUITE 400N
ST. PAUL, MINNESOTA 55114
(651) 644-4389

Howard R. Green Company

RECORD PLAN

2005 STREET IMPROVEMENTS

CITY OF ELK RIVER

STATION 26+00 TO STATION 28+50

PLAN AND PROFILE

TIPTON AVENUE

SHEET NO. 18

DRAWING NUMBER

DRAWING NUMBER

DRAWING NUMBER

DRAWING NUMBER

MAINS.05
10