QUINN AVENUE

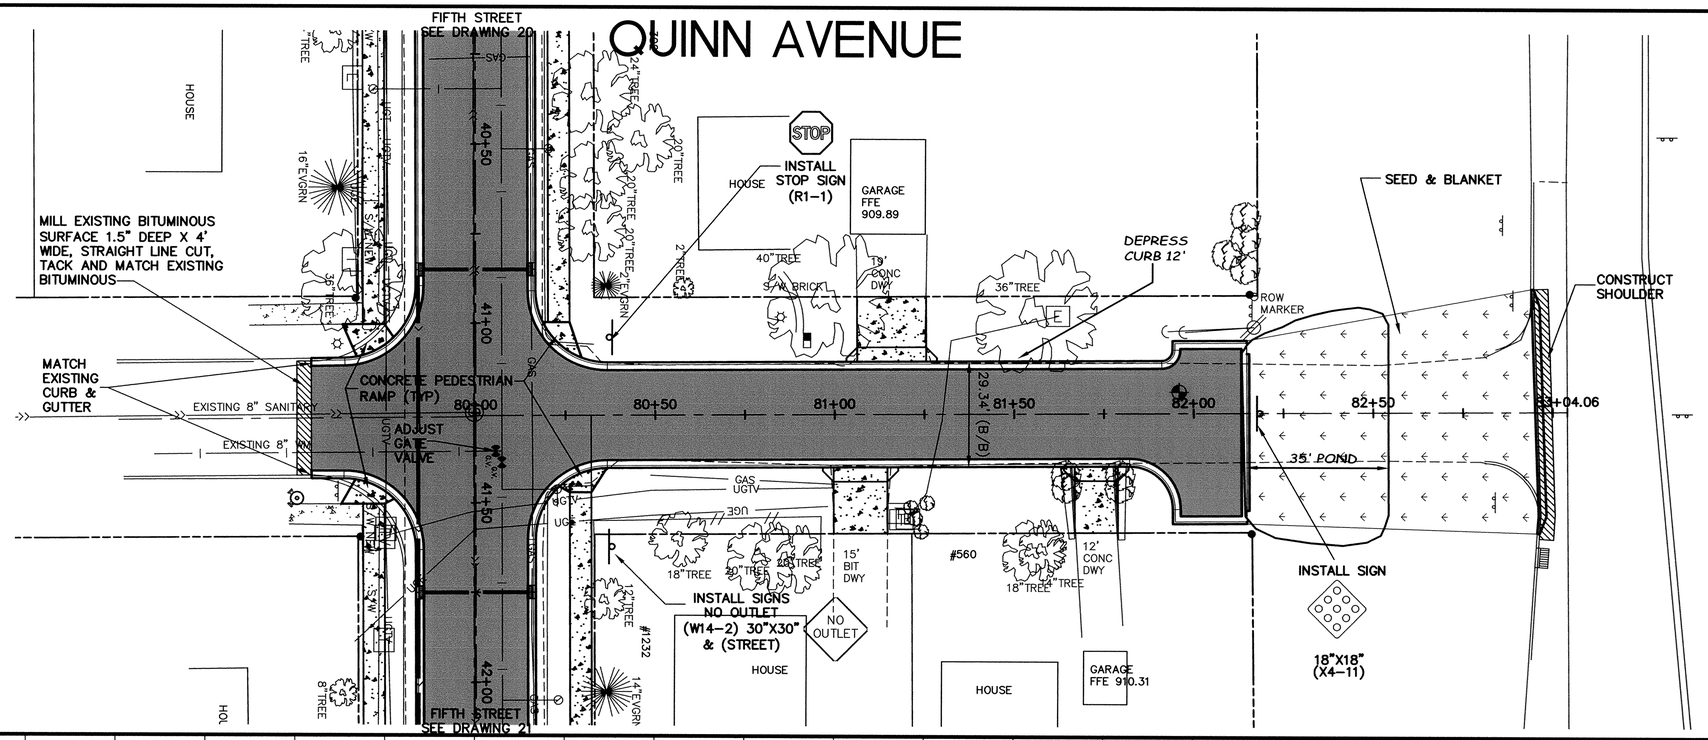

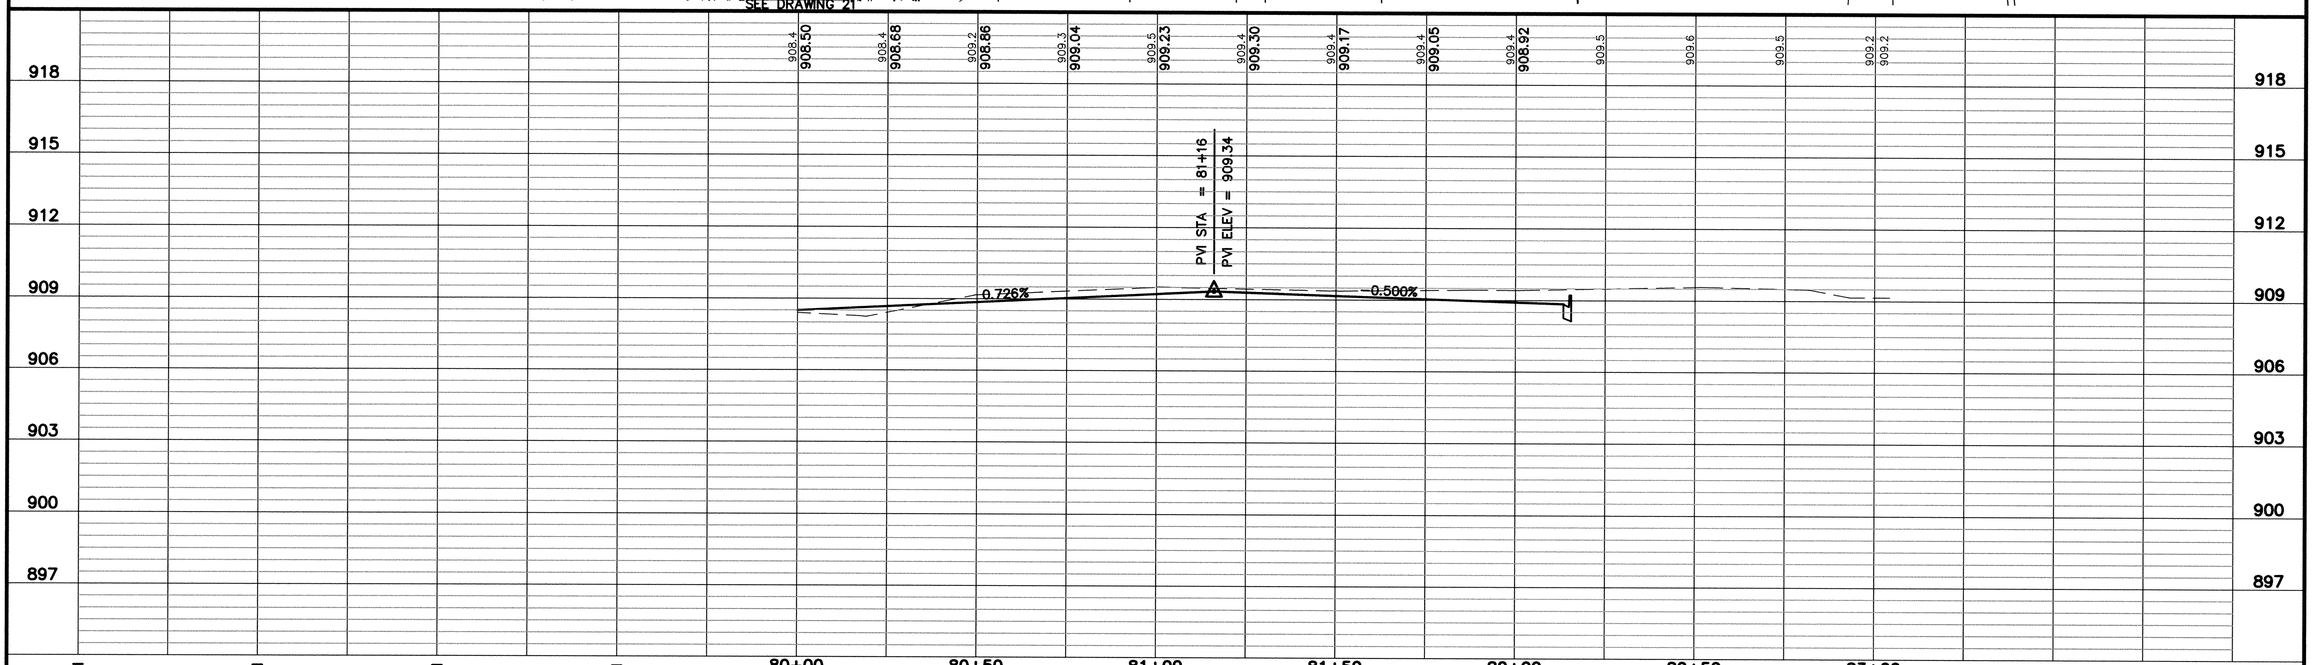

DESIGNED BY: JMA	DRAWN BY: LAK
APPROVED BY: JMA	JOB NUMBER 824180J
CAD DATE: March 31, 2005 1:54:35 p.m.	
CAD FILE: 824180j\Dwgs\C\CT-26.DWG (TLAMKIN)	

I HEREBY CERTIFY THAT THIS PLAN, SPECIFICATION, OR REPORT WAS PREPARED BY ME OR UNDER MY DIRECT SUPERVISION AND THAT I AM A DULY LICENSED PROFESSIONAL ENGINEER UNDER THE LAWS OF THE STATE OF MINNESOTA.

SIGNATURE _____ DATE 2/2/05

PRINTED NAME JOHN M. ANDERSON P.E. LIC.NO. 25889

NO.	DATE	BY	REVISION DESCRIPTION

Howard R. Green Company
2550 UNIVERSITY AVENUE W. SUITE 400N
ST. PAUL, MINNESOTA 55114
(651) 644-4389

RECORD PLAN
2005 STREET IMPROVEMENTS
CITY OF ELK RIVER

PLAN AND PROFILE
QUINN AVENUE

SHEET NO. 26

DRAWING NUMBER
ARCHITECTS • NEW HOPE, MINNESOTA
RECORDED BY PART NUMBER 65302
SAFCO PRODUCTS
POSITIVE CODE OF PRINT ON THIS LINE
DRAWING NUMBER
MAINS.05
18