SEYMOUR AVENUE

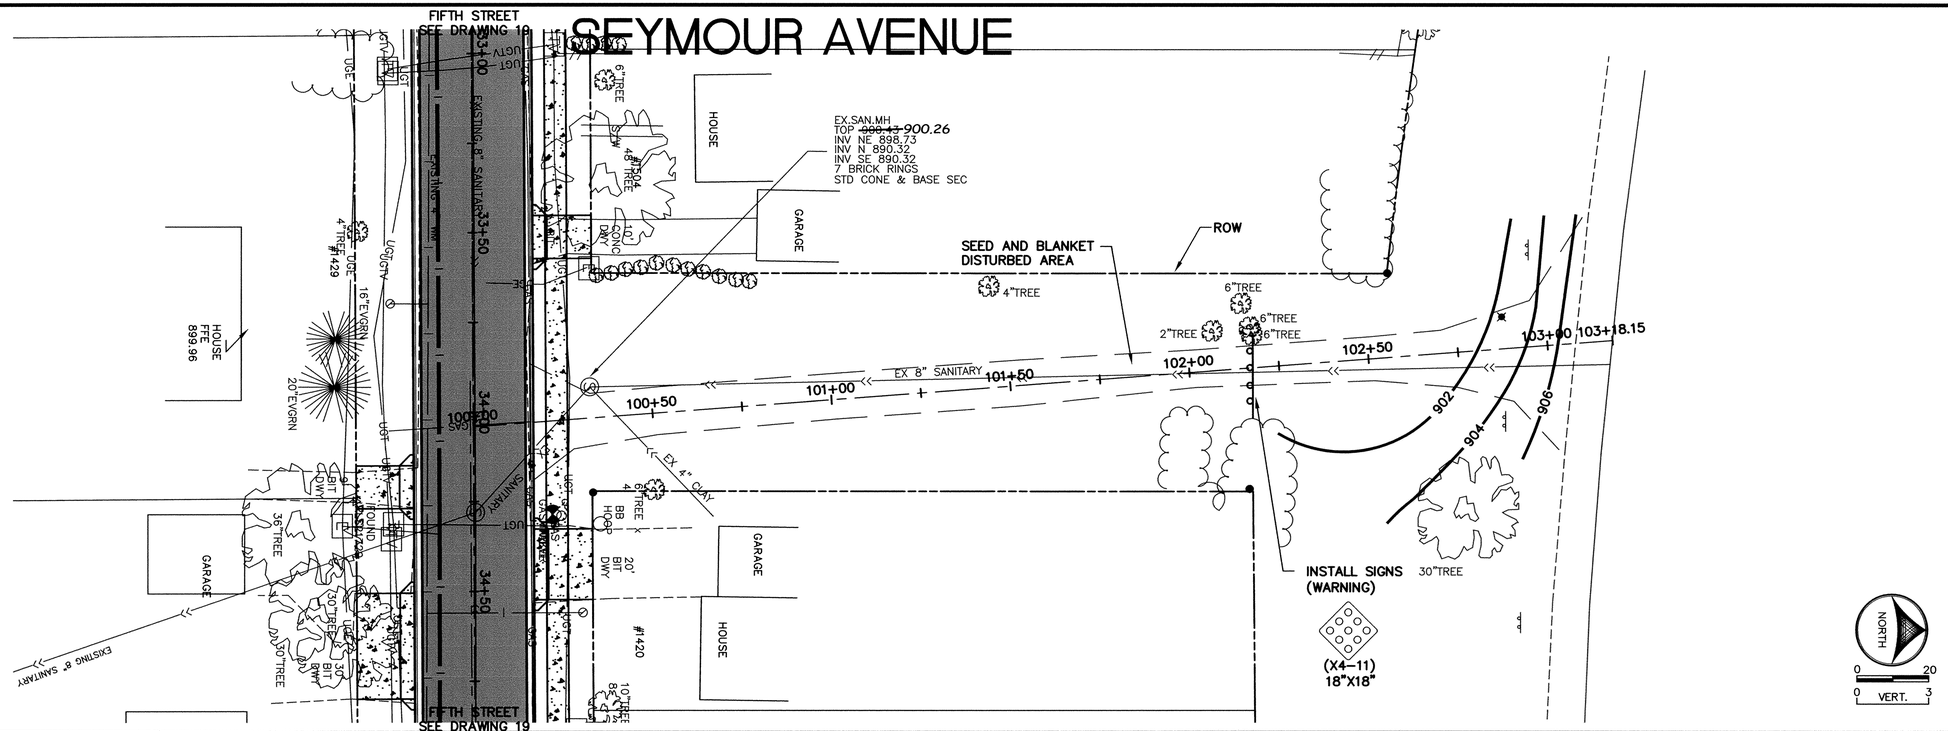

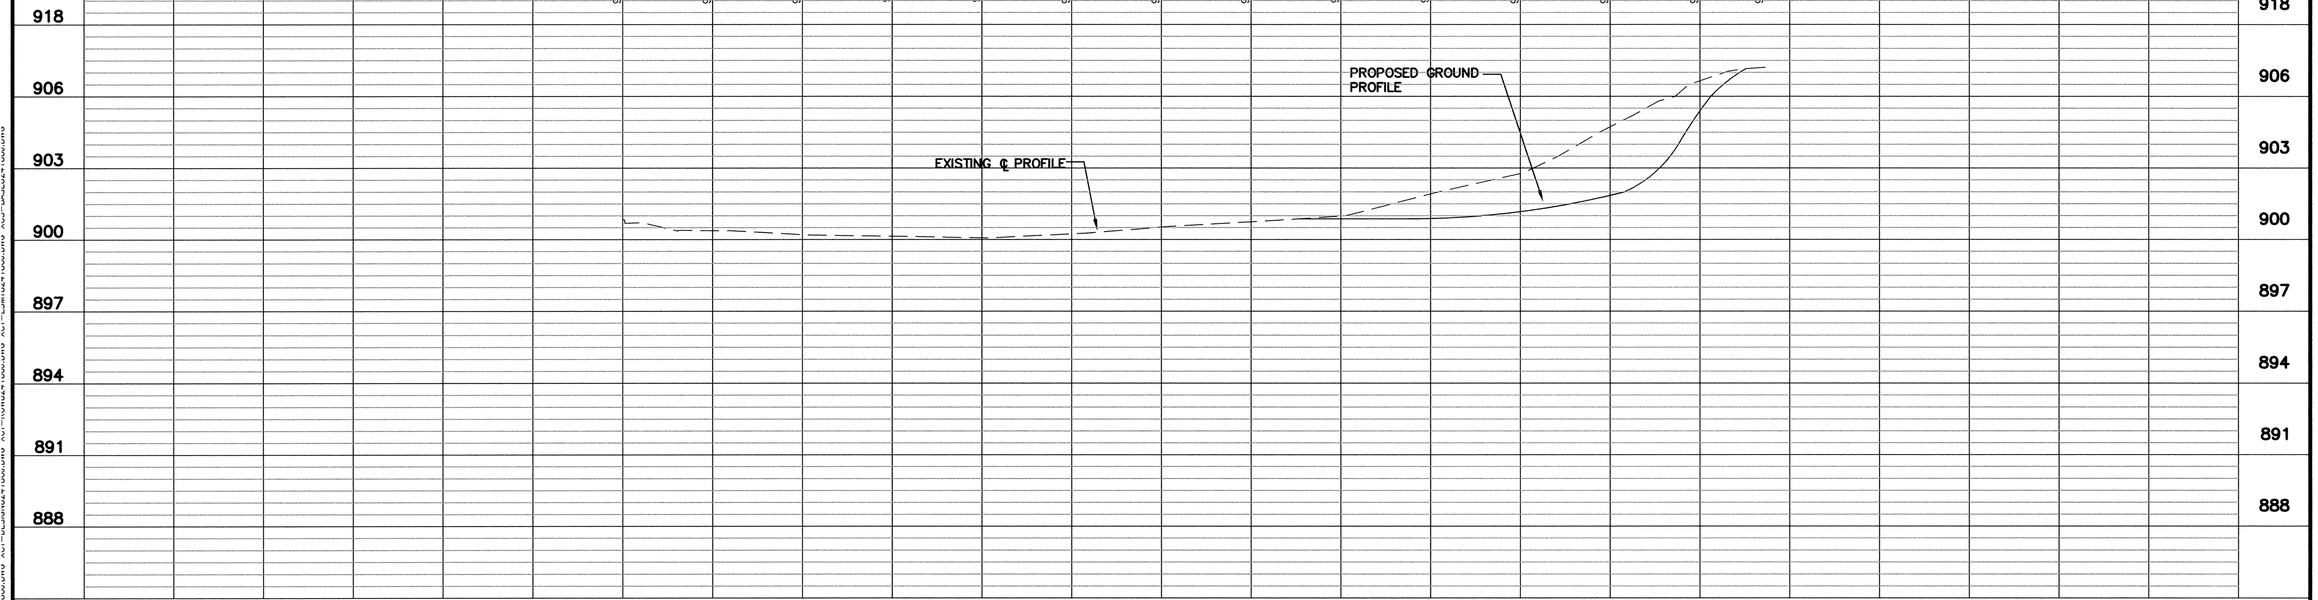

DESIGNED BY: JMA DRAWN BY: LAK
APPROVED BY: JMA JOB NUMBER 824180J
CAD DATE: March 31, 2005 2:23:36 p.m.
CAD FILE: 824180j\Dwgs\C\CT-28.DWG (TLAMKIN)

I HEREBY CERTIFY THAT THIS PLAN, SPECIFICATION, OR REPORT WAS PREPARED BY ME OR UNDER MY DIRECT SUPERVISION AND THAT I AM A DULY LICENSED PROFESSIONAL ENGINEER UNDER THE LAWS OF THE STATE OF MINNESOTA.
SIGNATURE _____ DATE 2/2/07
PRINTED NAME JOHN M. ANDERSON P.E. LIC.NO. 25889

NO.	DATE	BY	REVISION DESCRIPTION

2550 UNIVERSITY AVENUE W, SUITE 400N
ST. PAUL, MINNESOTA 55114
(651) 644-4389
Howard R. Green Company

RECORD PLAN
2005 STREET IMPROVEMENTS
CITY OF ELK RIVER

STATION 100+00 TO STATION 103+18
PLAN AND PROFILE
SEYMOUR AVENUE

SHEET NO. 28

DRAWING NUMBER
SAFCO PRODUCTS • NEW HOPE, MINNESOTA
REORDER BY PART NUMBER 6592
POSITION EDGE OF PAPER ON THIS LINE