HIGHWAY 10 WATERMAIN CROSSING

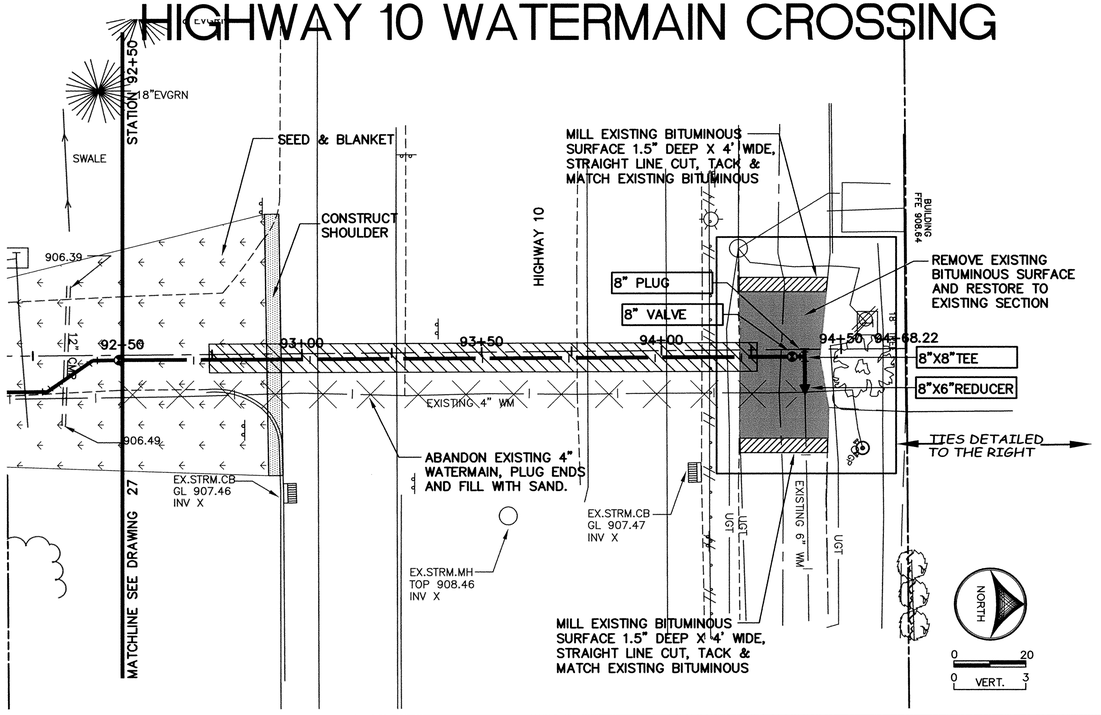

DETAILED TIES FOR SHEET #29

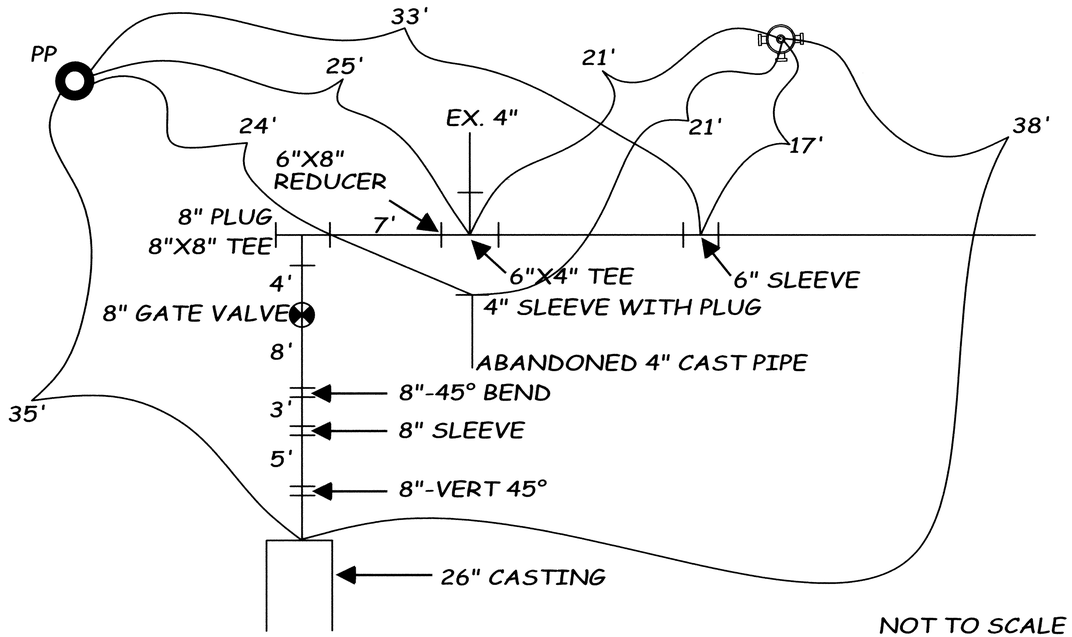

NOT TO SCALE

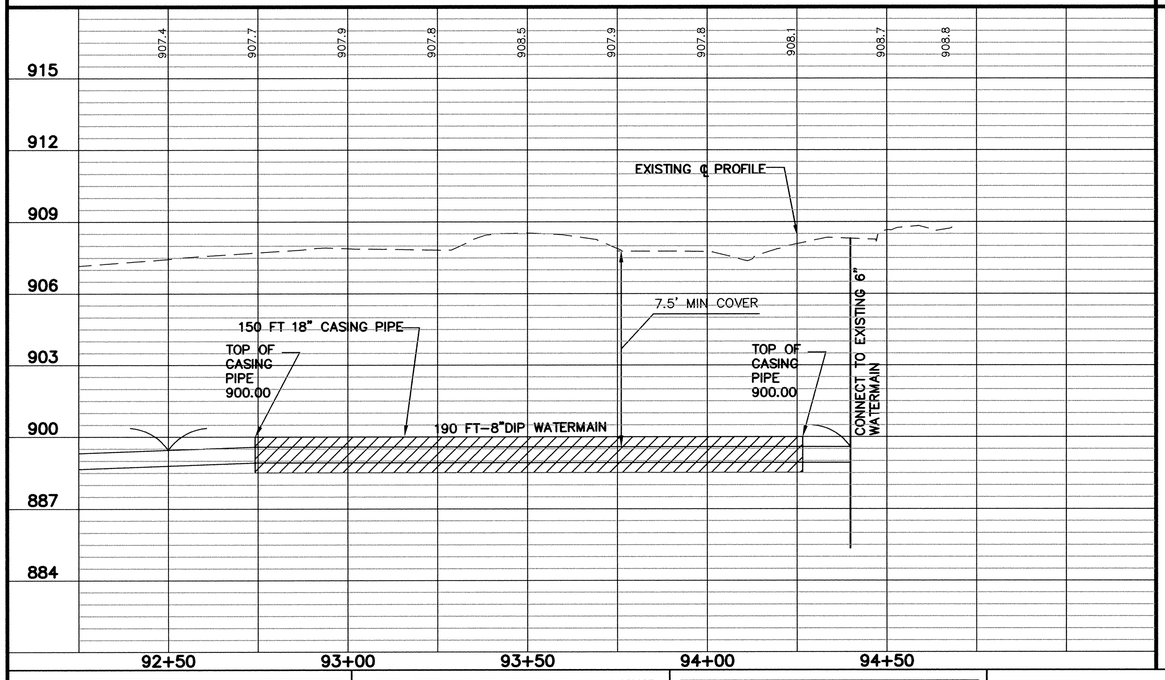

DETAILED TIES FOR SHEET #20

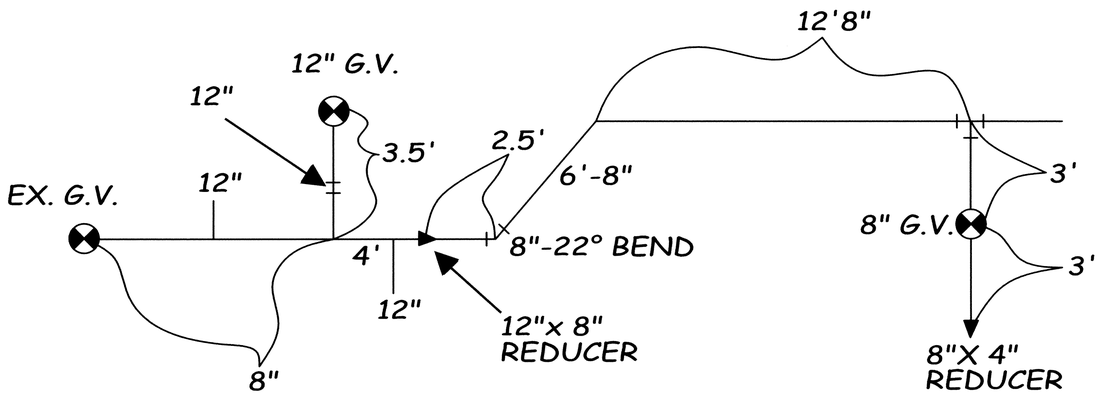

DESIGNED BY: JMA	DRAWN BY: LAK		
APPROVED BY: JMA	JOB NUMBER 824180J		
CAD DATE: March 31, 2005 2:08:47 p.m.			
CAD FILE: 824180j\Dwgs\C\CT-29.DWG (TLAMKIN)			

I HEREBY CERTIFY THAT THIS PLAN, SPECIFICATION, OR REPORT WAS PREPARED BY ME OR UNDER MY DIRECT SUPERVISION AND THAT I AM A DULY LICENSED PROFESSIONAL ENGINEER UNDER THE LAWS OF THE STATE OF MINNESOTA.

SIGNATURE _____ DATE 2/24/05

PRINTED NAME JOHN M. ANDERSON P.E. LIC.NO. 25889

NO.	DATE	BY	REVISION DESCRIPTION

Howard R. Green Company
2550 UNIVERSITY AVENUE W, SUITE 400N
ST. PAUL, MINNESOTA 55114
(651) 644-4389

RECORD PLAN
2005 STREET IMPROVEMENTS
CITY OF ELK RIVER

PLAN AND PROFILE
WATERMAIN CROSSING

SHEET NO. 29

DRAWING NUMBER

DRAWING NUMBER

DRAWING NUMBER
MAINS.05
21