# STORM SEWER CROSSINGS

## CROSSING K




## CROSSING L




## CROSSING M

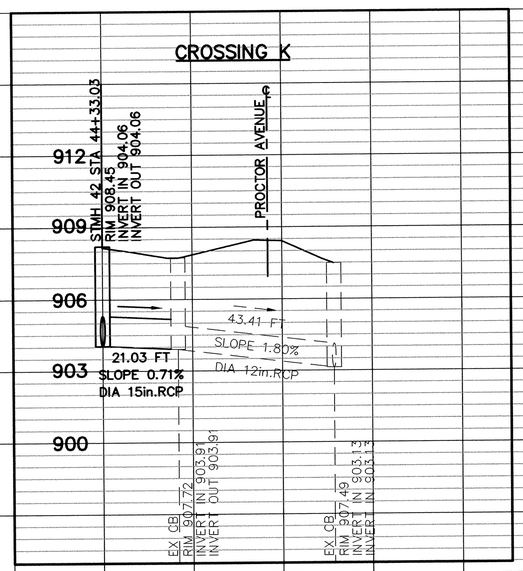


## CROSSING N

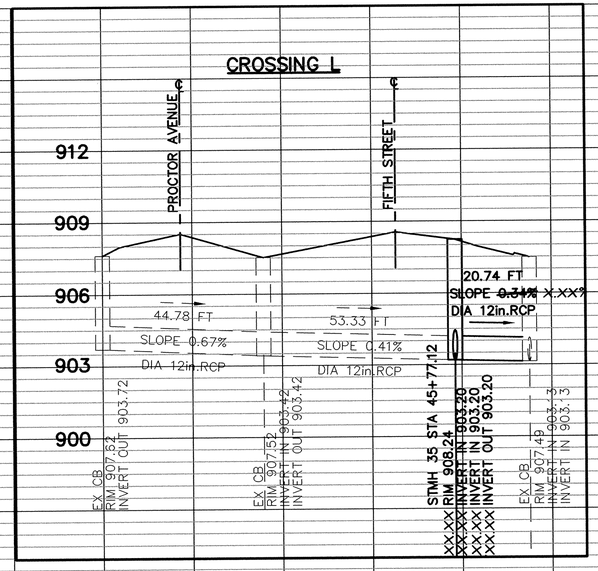


## CROSSING O

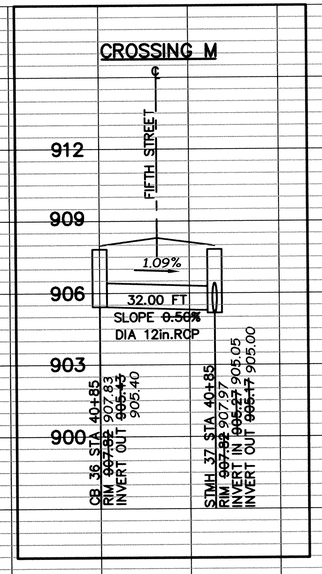


## CROSSING P

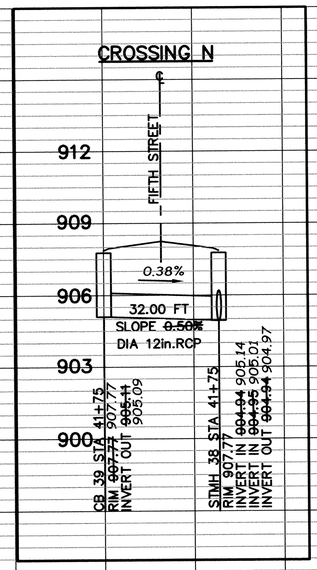


## CROSSING Q

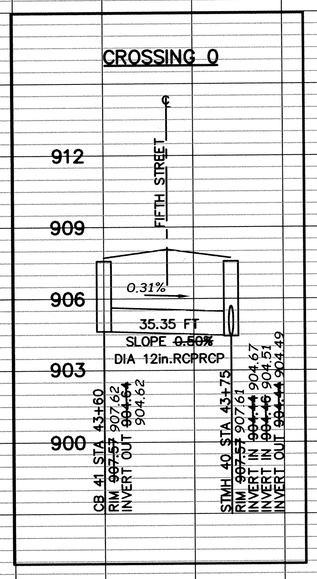


## CROSSING R

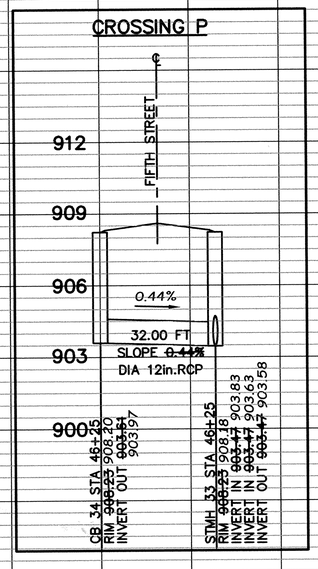


0 20
0 VERT. 3

DESIGNED BY: JAM DRAWN BY: LAK
APPROVED BY: JMA JOB NUMBER 824180J
CAD DATE: April 01, 2005 12:46:31 p.m.
CAD FILE: 824180j\Dwgs\C\CT-31.DWG (LKIEWEL)

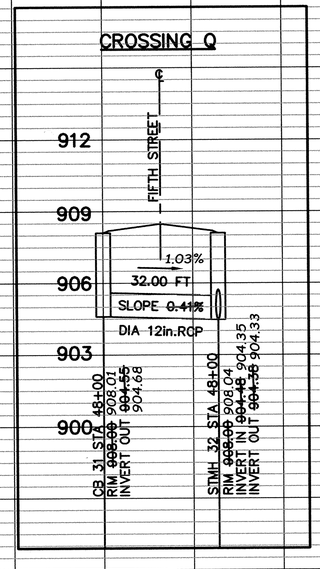I HEREBY CERTIFY THAT THIS PLAN, SPECIFICATION, OR REPORT WAS PREPARED BY ME OR UNDER MY DIRECT SUPERVISION AND THAT I AM A DULY LICENSED PROFESSIONAL ENGINEER UNDER THE LAWS OF THE STATE OF MINNESOTA.
SIGNATURE _____ DATE 2/2/07
PRINTED NAME JOHN M. ANDERSON, P.E. LIC.NO. 25889

| NO. | DATE | BY | REVISION DESCRIPTION |
|---|---|---|---|
| | | | |
| | | | |
| | | | |
| | | | |
| | | | |

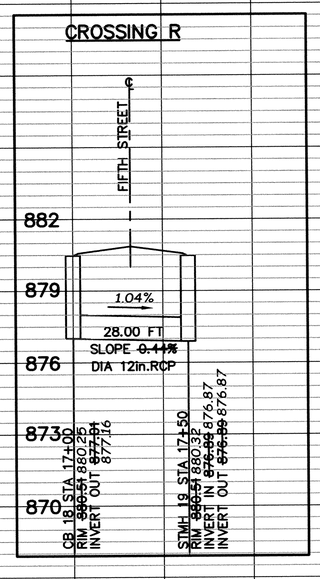Howard R. Green Company
2550 UNIVERSITY AVENUE W, SUITE 400N
ST. PAUL, MINNESOTA 55114
(651) 644-4389

**RECORD PLAN**
2005 STREET IMPROVEMENTS
CITY OF ELK RIVER

PROFILE
STORM SEWER CROSSINGS

SHEET NO. 31

Xrefs: XCT-DESIGN824180J.DWG


DRAWING NUMBER
SAFCO PRODUCTS • NEW HOPE, MINNESOTA
REORDER BY PART NUMBER 8052
PRINTED IN USA
DRAWING NUMBER
SAFCO PRODUCTS • NEW HOPE, MINNESOTA
REORDER BY PART NUMBER 8052
PRINTED IN USA
DRAWING NUMBER
MAINS.05
23
SAFCO PRODUCTS • NEW HOPE, MINNESOTA
REORDER BY PART NUMBER 8052
PRINTED IN USA