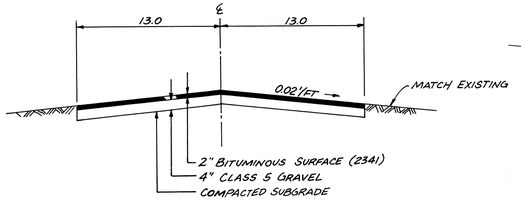

SIMONET DRIVE STREET SECTION

SIMONET DRIVE

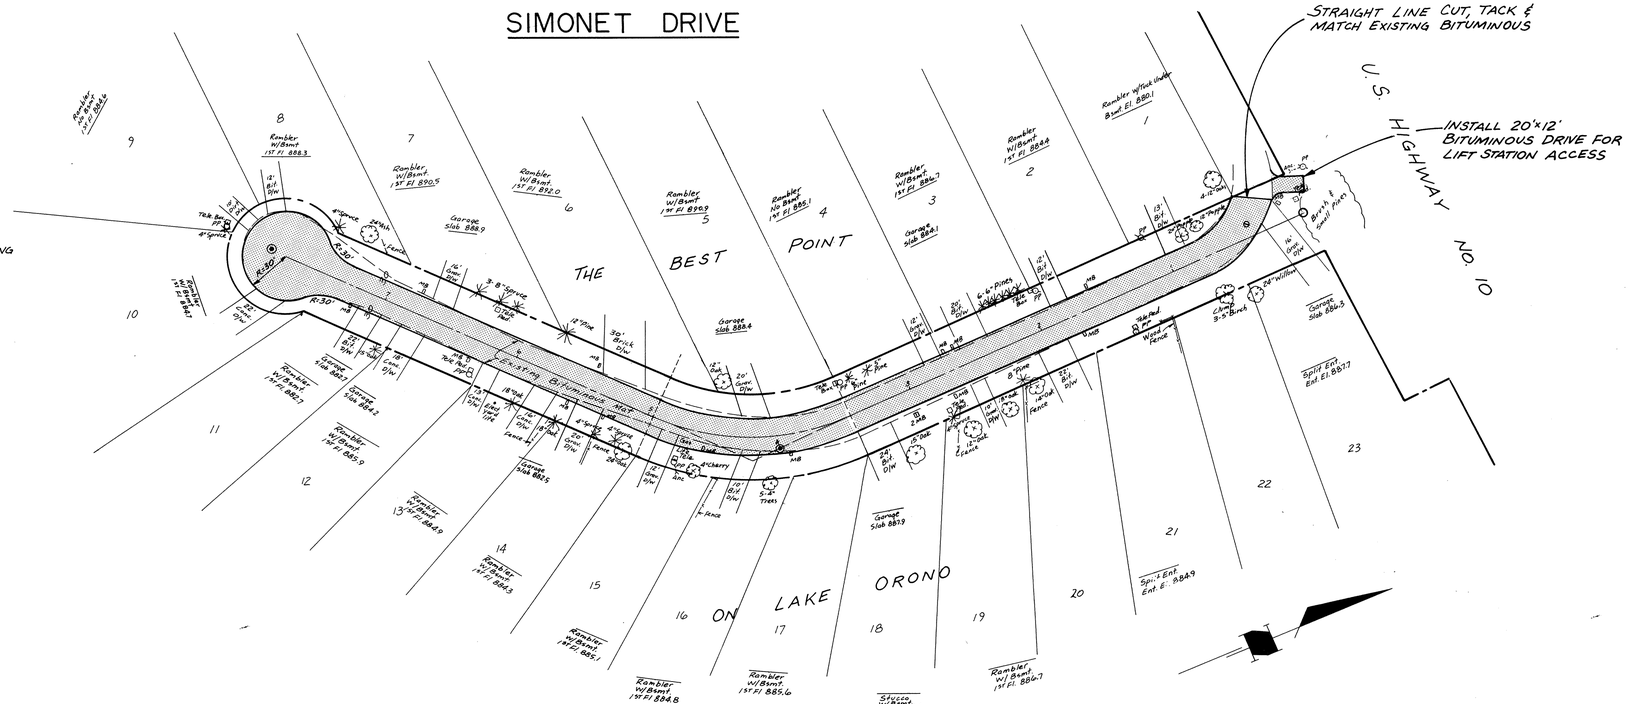

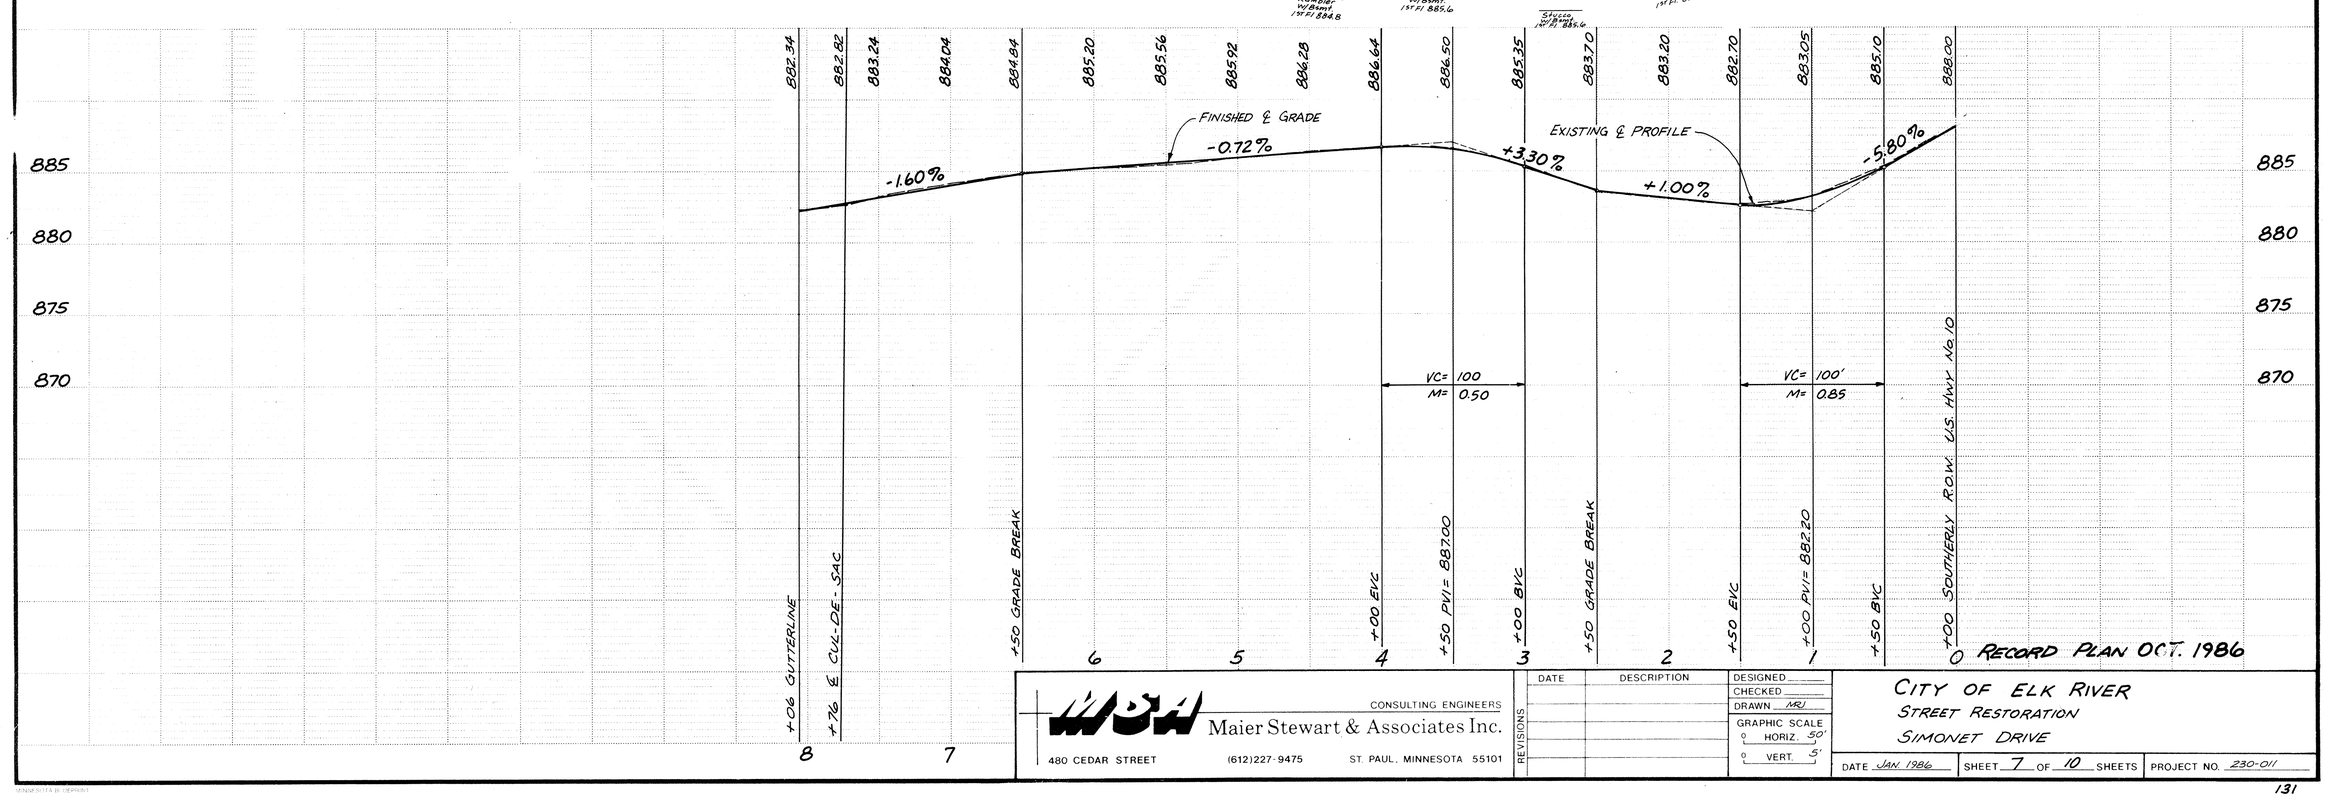

RECORD PLAN OCT. 1986

CONSULTING ENGINEERS
Maier Stewart & Associates Inc.
480 CEDAR STREET (612)227-9475 ST. PAUL, MINNESOTA 55101

REVISIONS	DATE	DESCRIPTION

DESIGNED ____
CHECKED ____
DRAWN MRJ
GRAPHIC SCALE
HORIZ. 50'
VERT. 5'

CITY OF ELK RIVER
STREET RESTORATION
SIMONET DRIVE

DATE JAN. 1986 | SHEET 7 OF 10 SHEETS | PROJECT NO. 230-011

DRAWING NUMBER
SIGTEX PRODUCTS • NEW HOPE, MINNESOTA
REORDER BY PART NUMBER 6505
DRAWING NUMBER
XENIA 86
7