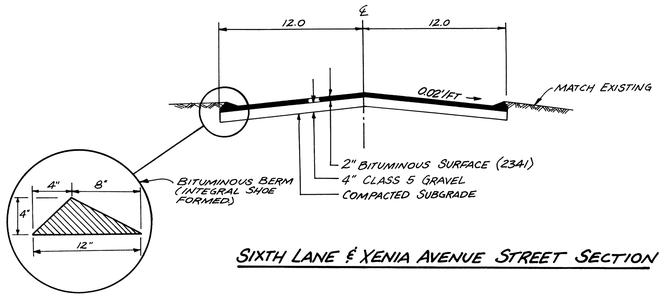

SIXTH LANE & XENIA AVENUE STREET SECTION

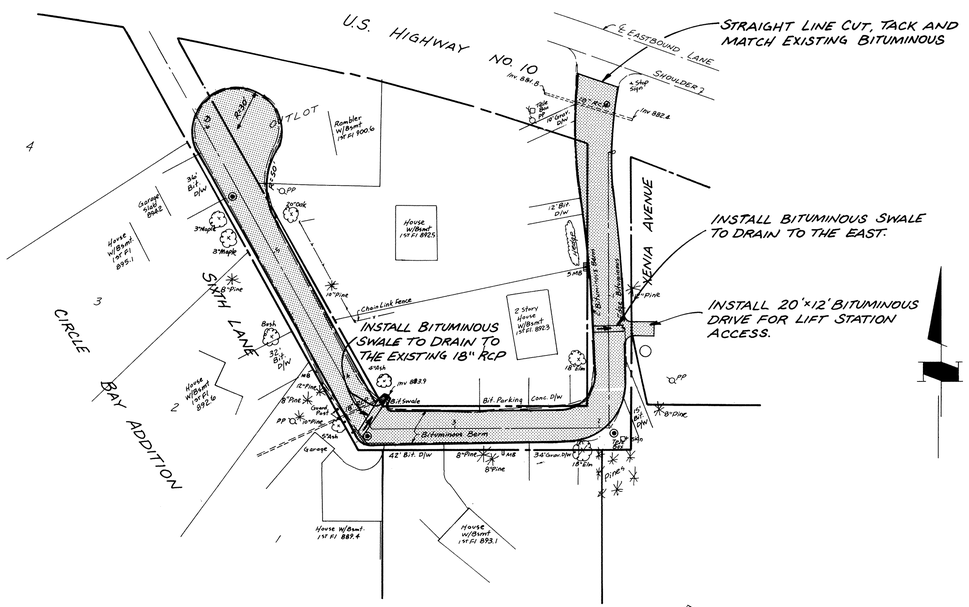

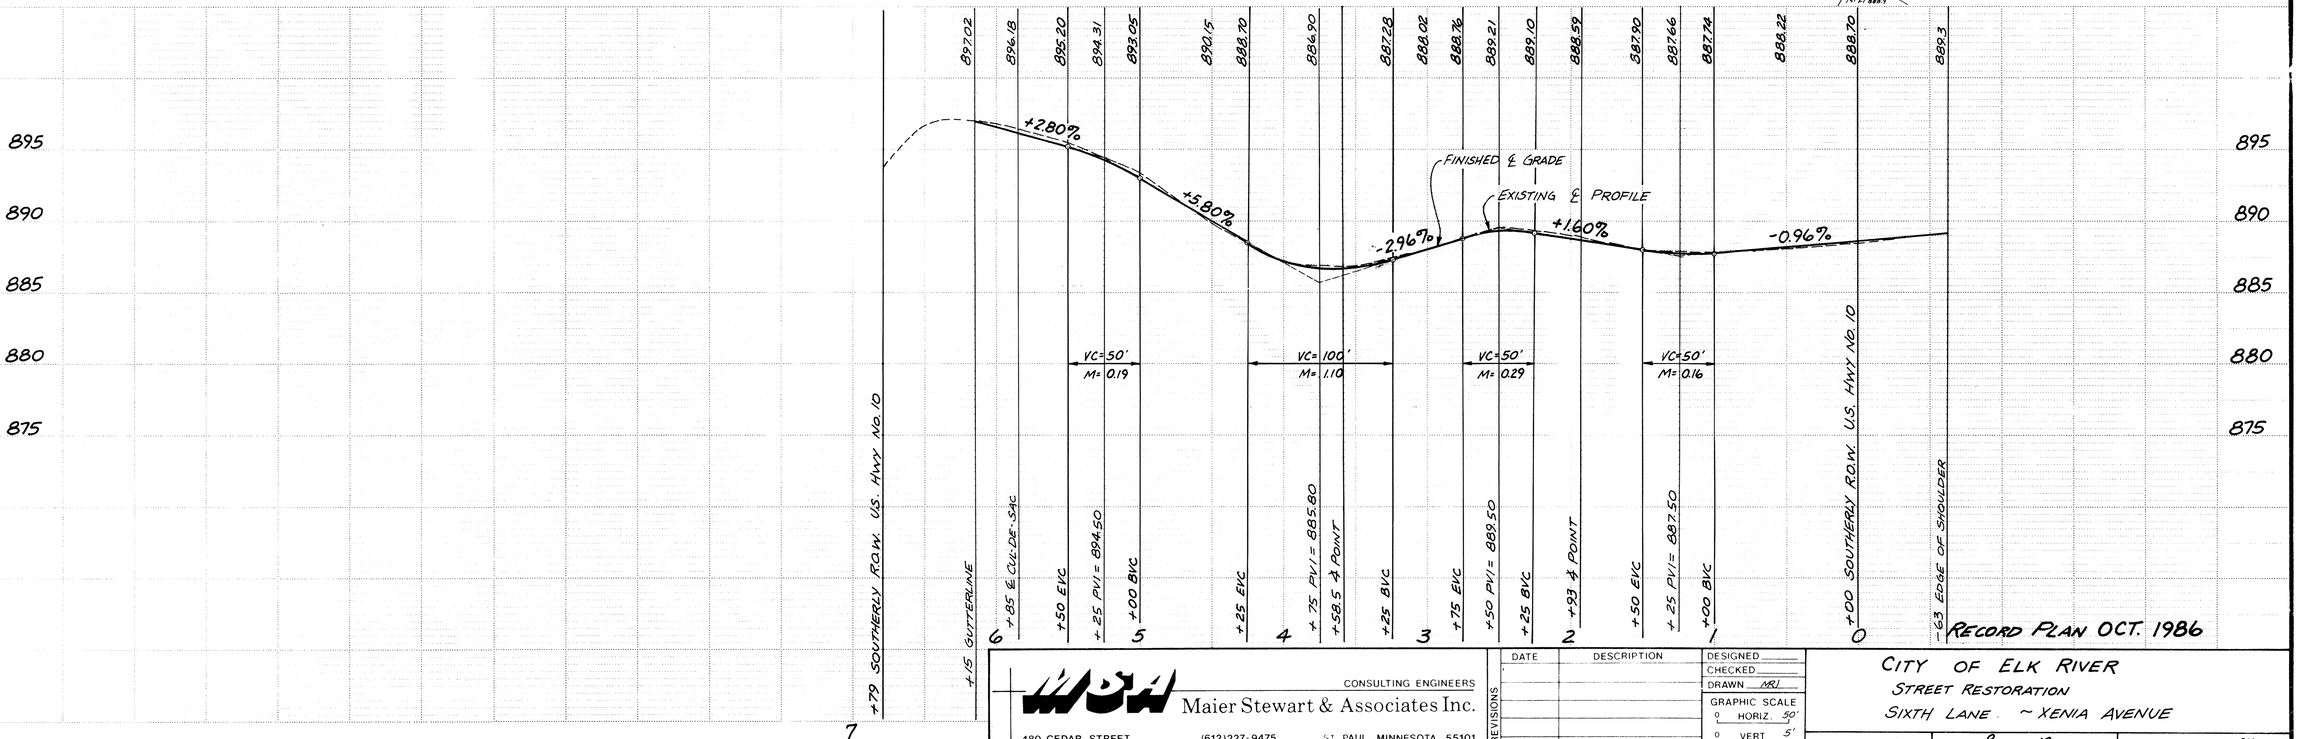

CONSULTING ENGINEERS Maier Stewart & Associates Inc. 480 CEDAR STREET (612)227-9475 ST. PAUL, MINNESOTA 55101	REVISIONS DATE / DESCRIPTION	DESIGNED CHECKED DRAWN MRI GRAPHIC SCALE 0 HORIZ. 50' 0 VERT. 5'

CITY OF ELK RIVER
STREET RESTORATION
SIXTH LANE ~ XENIA AVENUE

DATE JAN 1986 | SHEET 8 OF 10 SHEETS | PROJECT NO. 230-011

DRAWING NUMBER


XENIA 86
8