YALE STREET

NORTH

0 20

0 VERT. 5

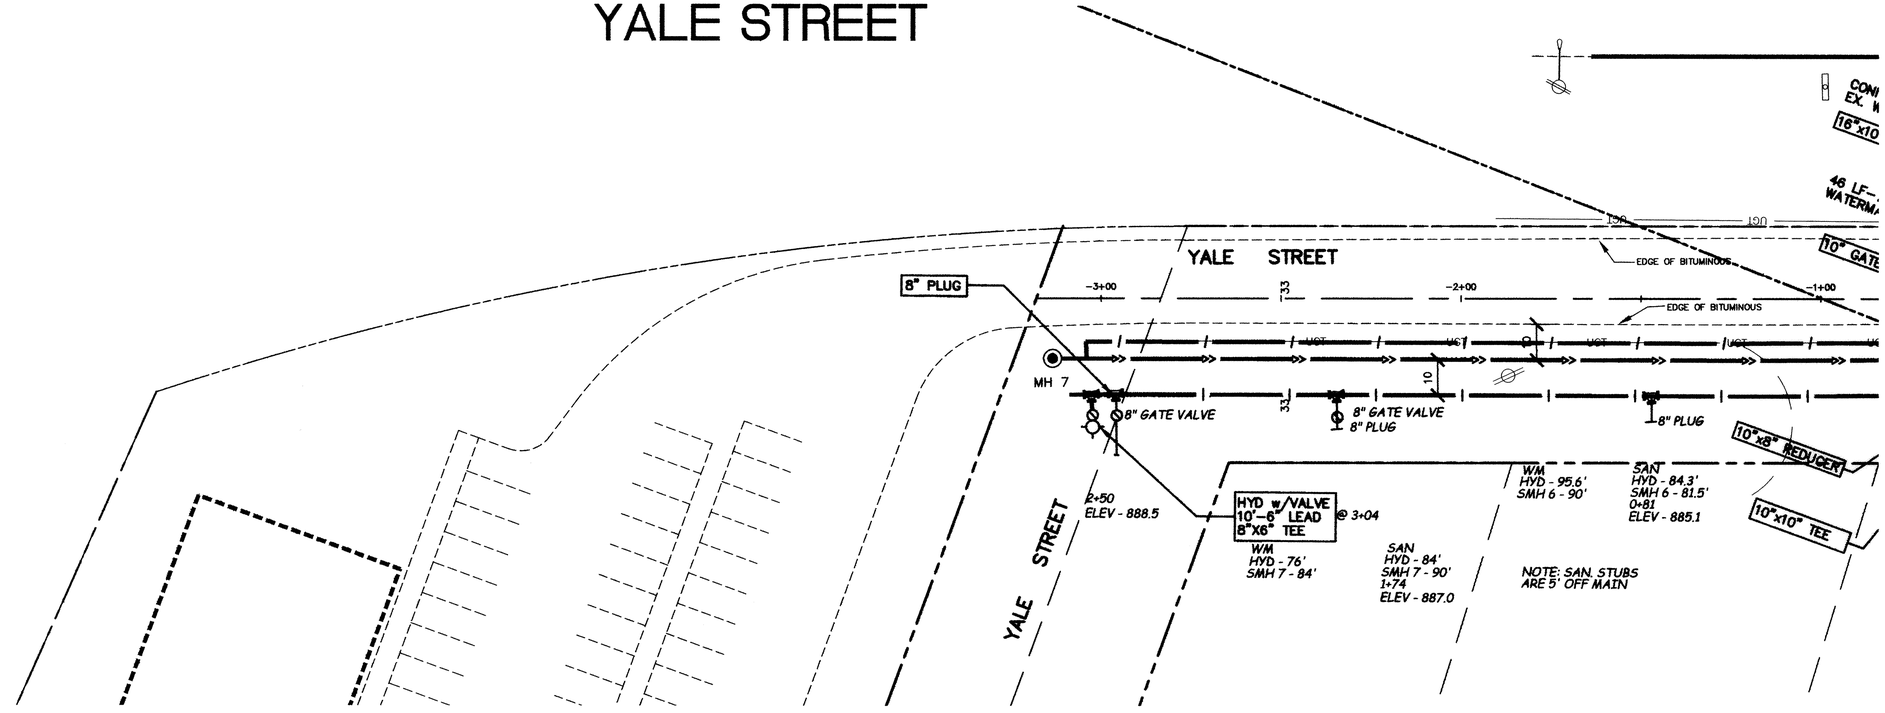

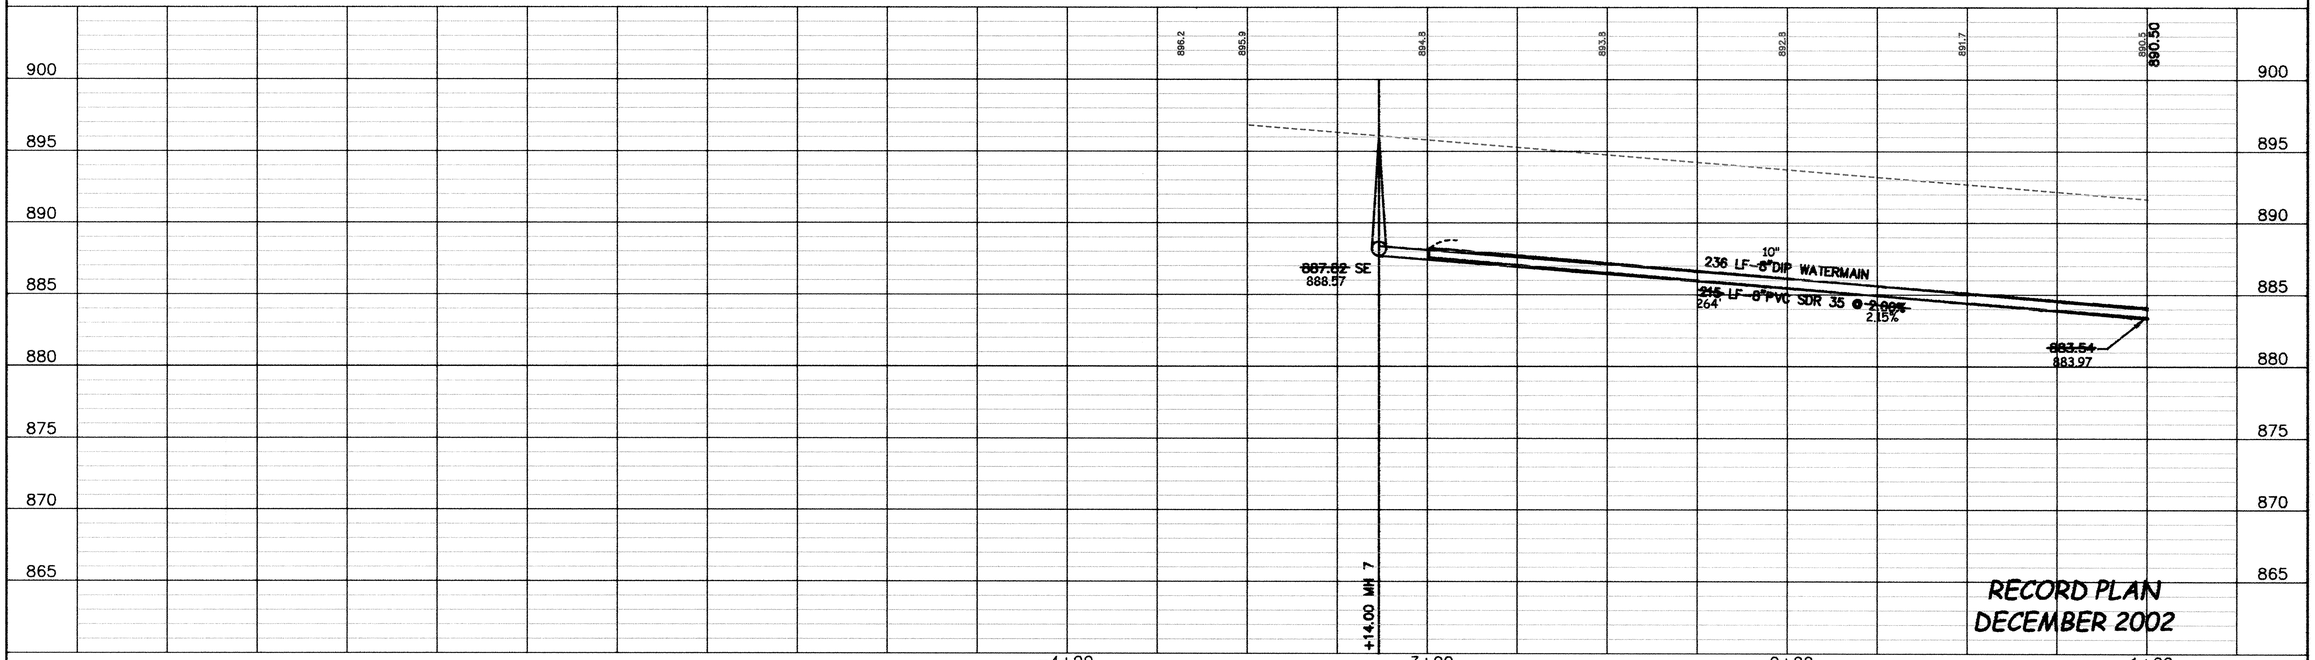

RECORD PLAN
DECEMBER 2002

DESIGNED BY: KT/EY DRAWN BY: EY
APPROVED BY: — JOB NUMBER 815640J
CAD DATE: May 01, 2003 8:06:17 a.m.
CAD FILE: 815640j\dwg\815640B.DWG (JLALLEN)

I HEREBY CERTIFY THAT THIS PLAN, SPECIFICATION, OR REPORT WAS PREPARED BY ME OR UNDER MY DIRECT SUPERVISION AND THAT I AM A DULY LICENSED PROFESSIONAL ENGINEER UNDER THE LAWS OF THE STATE OF MINNESOTA.

SIGNATURE _____ DATE _____

PRINTED NAME TERRY J. MAURER LIC.NO. 15316

NO.	DATE	BY	REVISION DESCRIPTION
1	6/20/02	JRC	Watermain Revisions

Howard R. Green Company
CONSULTING ENGINEERS
1326 ENERGY PARK DRIVE
ST. PAUL, MINNESOTA 55108
(612) 644-4389

ZANE AVENUE IMPROVEMENTS
CITY OF ELK RIVER

S.P. 7101-56
YALE STREET
STA. 4+50 TO STA. 8+50

SHEET NO. 7

DRAWING NUMBER

DRAWING NUMBER

DRAWING NUMBER
ZANEA.02
8

SAFCO PRODUCTS • NEW HOPE, MINNESOTA
REORDER BY PART NUMBER 6502