


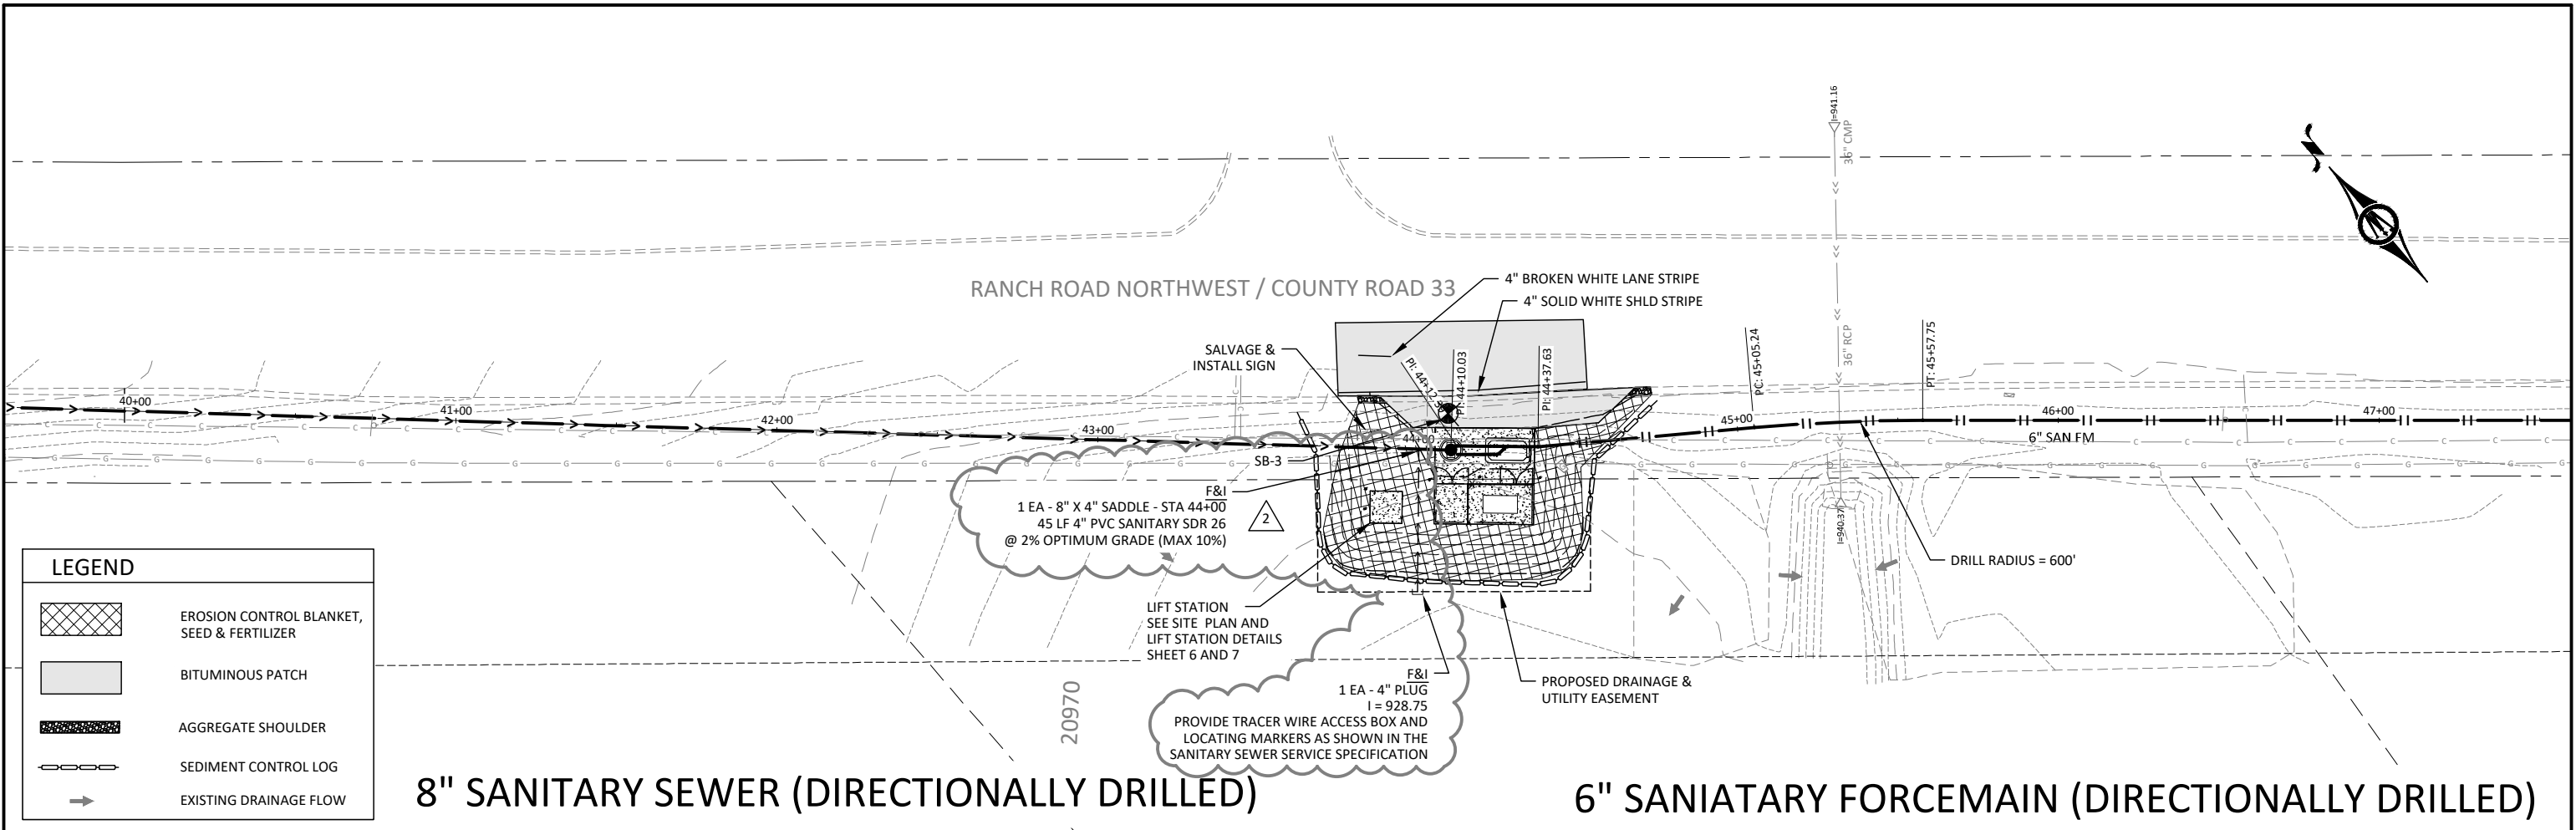

LEGEND

EROSION CONTROL BLANKET, SEED & FERTILIZER

BITUMINOUS PATCH

AGGREGATE SHOULDER

SEDIMENT CONTROL LOG

EXISTING DRAINAGE FLOW

