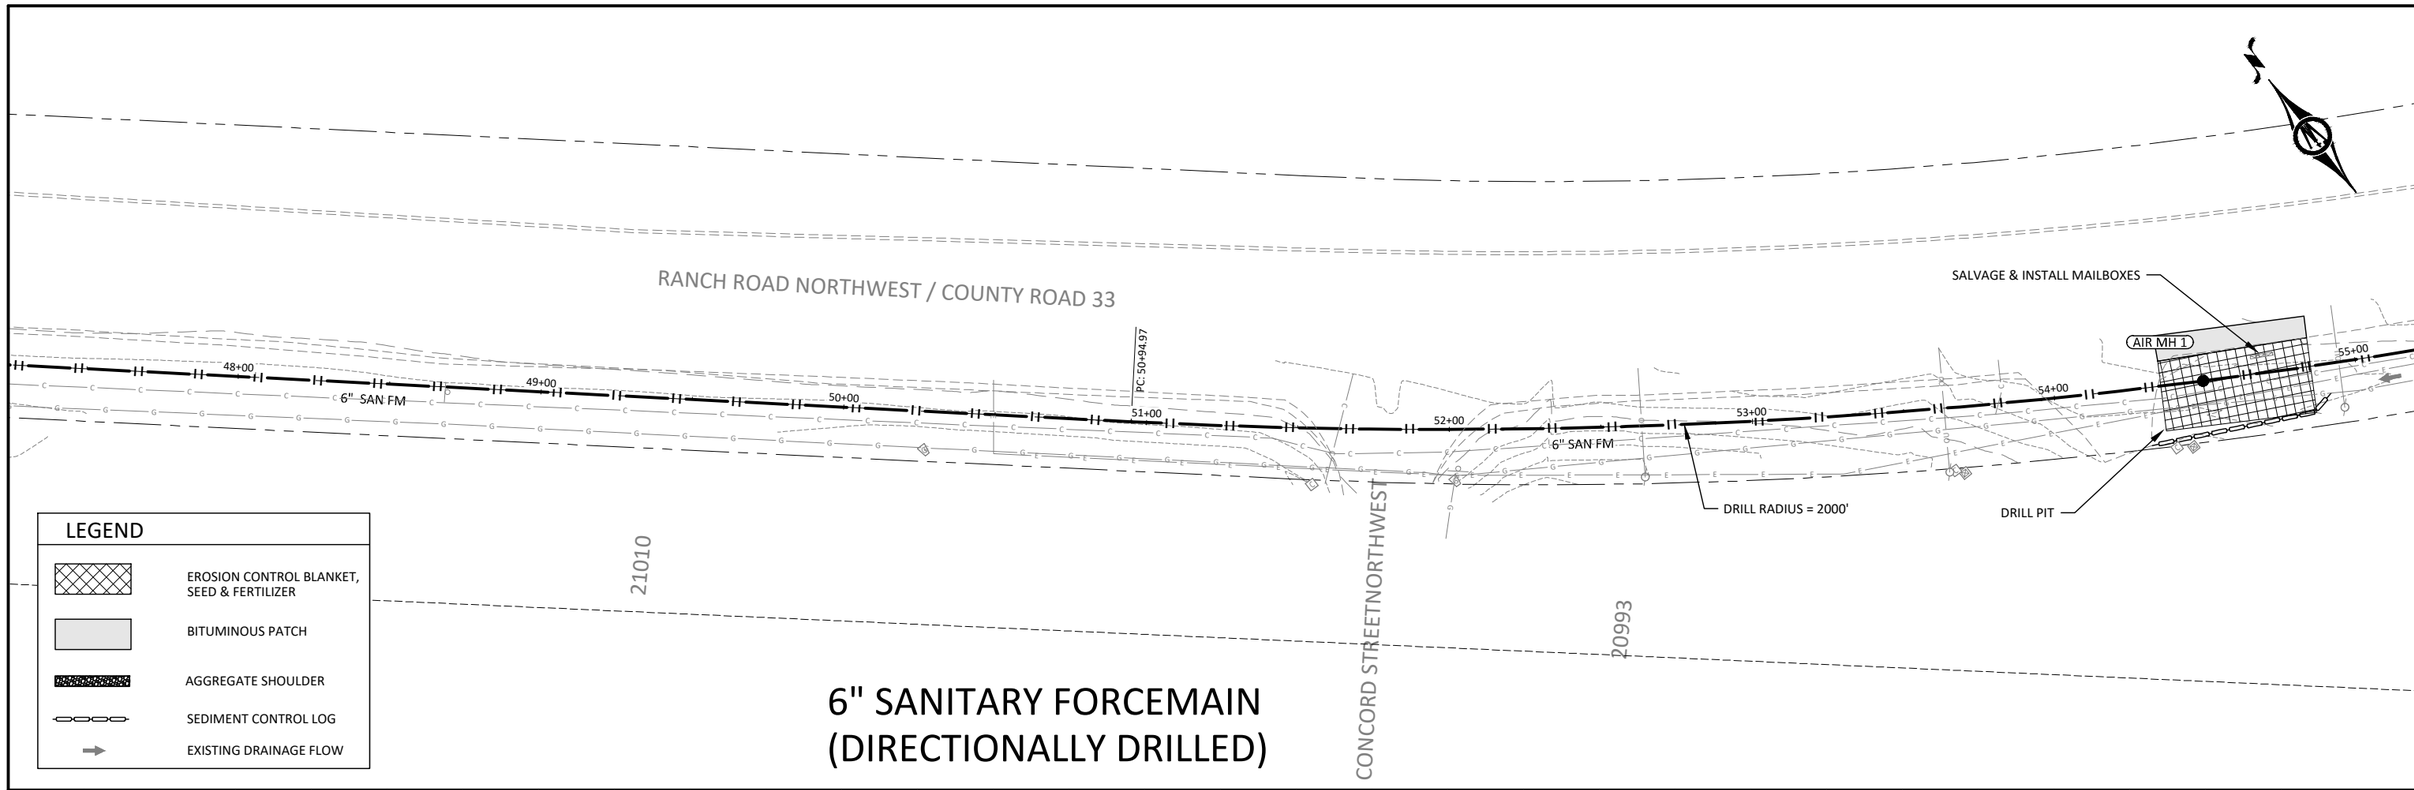

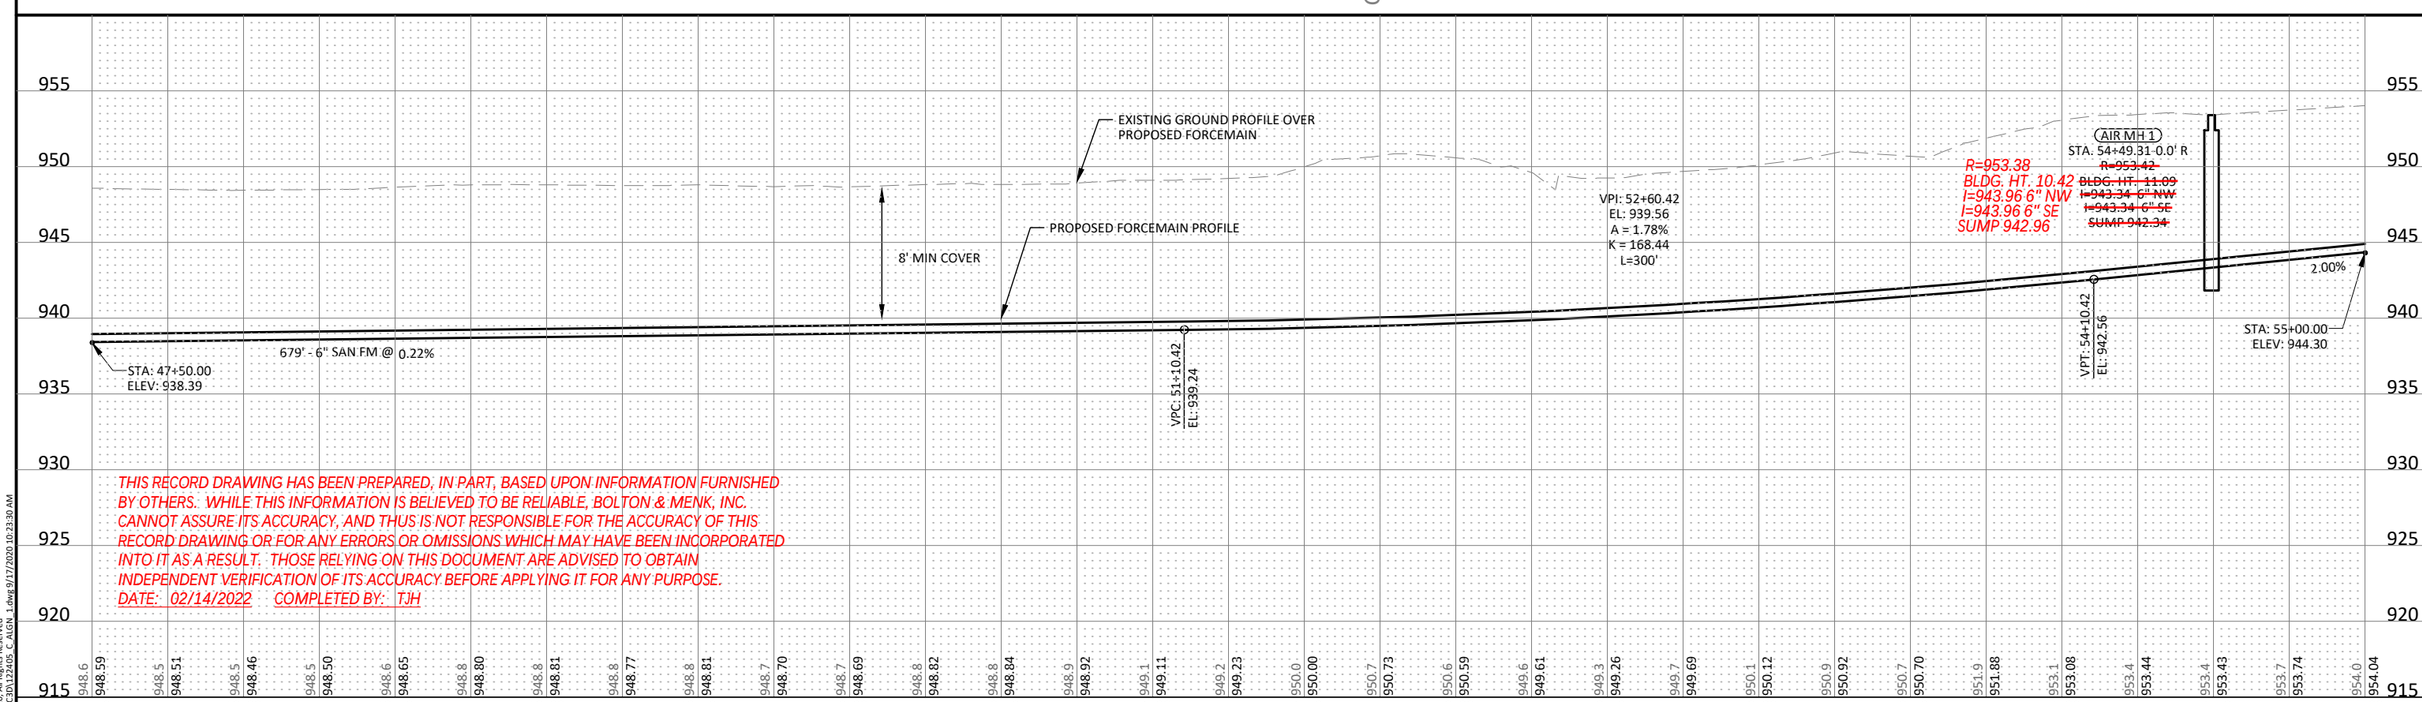

THIS RECORD DRAWING HAS BEEN PREPARED, IN PART, BASED UPON INFORMATION FURNISHED BY OTHERS. WHILE THIS INFORMATION IS BELIEVED TO BE RELIABLE, BOLTON & MENK, INC. CANNOT ASSURE ITS ACCURACY, AND THUS IS NOT RESPONSIBLE FOR THE ACCURACY OF THIS RECORD DRAWING OR FOR ANY ERRORS OR OMISSIONS WHICH MAY HAVE BEEN INCORPORATED INTO IT AS A RESULT. THOSE RELYING ON THIS DOCUMENT ARE ADVISED TO OBTAIN INDEPENDENT VERIFICATION OF ITS ACCURACY BEFORE APPLYING IT FOR ANY PURPOSE.
DATE: 02/14/2022 COMPLETED BY: TJH

HORZ. 0 25 50 SCALE FEET
VERT. 0 5 10 SCALE FEET

I HEREBY CERTIFY THAT THIS PLAN, SPECIFICATION, OR REPORT WAS PREPARED BY ME OR UNDER MY DIRECT SUPERVISION AND THAT I AM A DULY LICENSED PROFESSIONAL ENGINEER UNDER THE LAWS OF THE STATE OF MINNESOTA.

JASON W. COOK, P.E.
LIC. NO. 47451 DATE 09/08/2020

BOLTON & MENK

7533 SUNWOOD DR NW, SUITE 206
RAMSEY, MINNESOTA 55303
Phone: (763) 433-2851
Email: Ramsey@bolton-menk.com
www.bolton-menk.com

DESIGNED	JWC
DRAWN	KGA
CHECKED	JWC
CLIENT PROJ. NO.	R19.122405

NO.	ISSUED FOR	DATE

ELK RIVER, MINNESOTA
WINDSOR PARK 3RD. ADDITION - SEWER EXTENSION
SANITAY SEWER PLAN AND PROFILE

SHEET 13 OF 16

© Bolton & Menk, Inc. 2020, All Rights Reserved
H:\ELKR\R19122405\CAD\C3D\122405_C_ALGN_1.dwg 9/17/2020 10:23:30 AM