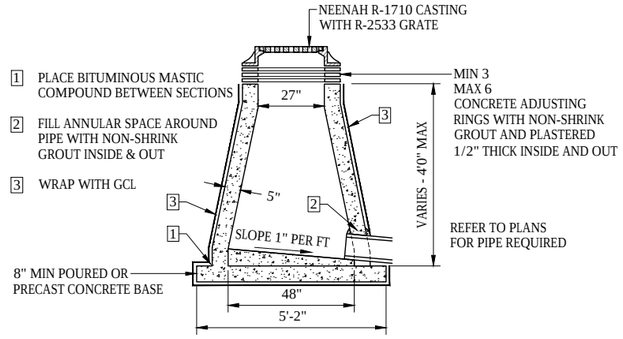

CATCH BASIN 22 - DESIGN G

NOT TO SCALE

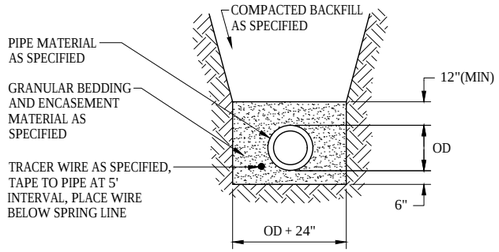

NON-RIGID SANITARY SEWER TRENCH

NOT TO SCALE

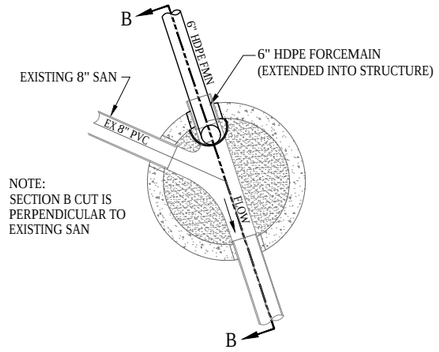

PLAN VIEW

EXISTING SANITARY MANHOLE 1
NEW FORCEMAIN CONNECTION DETAIL

NOT TO SCALE

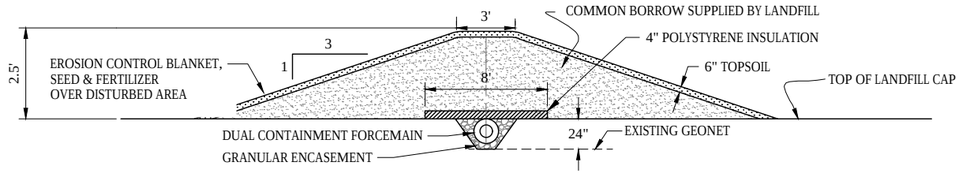

FORCEMAIN COVER BERM
STA. 233+50 TO 248+50

NOT TO SCALE

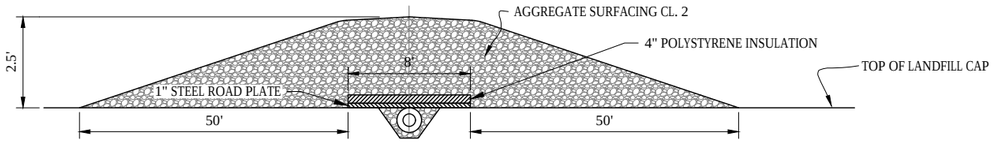

LANDFILL CAP ROAD CROSSING DETAIL

NOT TO SCALE

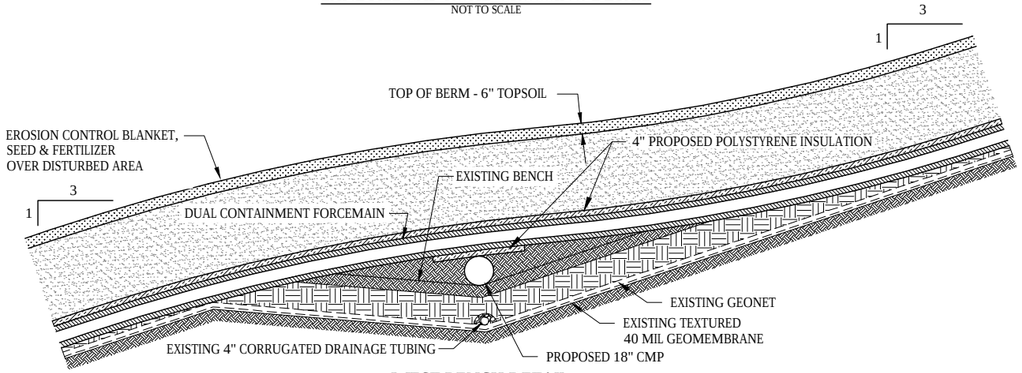

WEST BENCH DETAIL

NOT TO SCALE

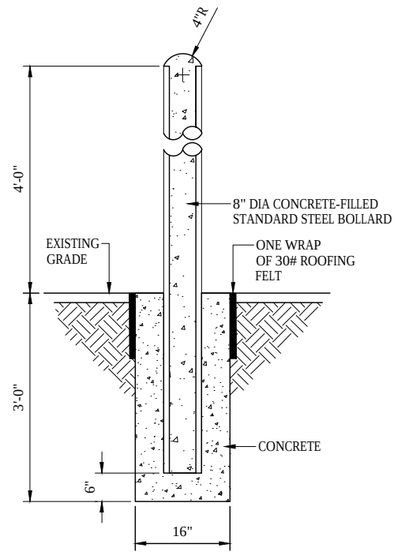

BOLLARD GUARD POST

NOT TO SCALE

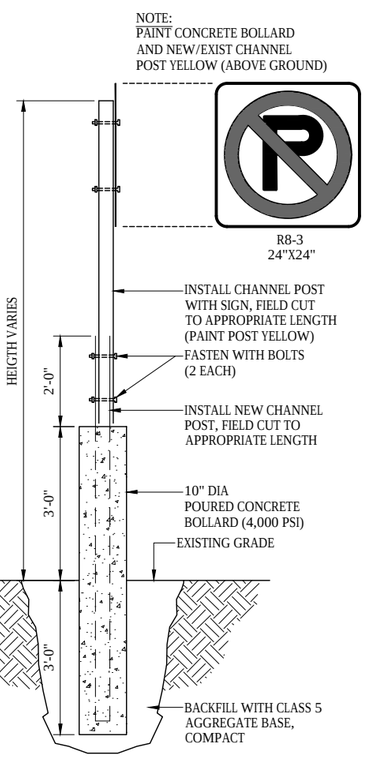

NEW SIGN POST INSTALLATION, PARKING LOT

NOT TO SCALE

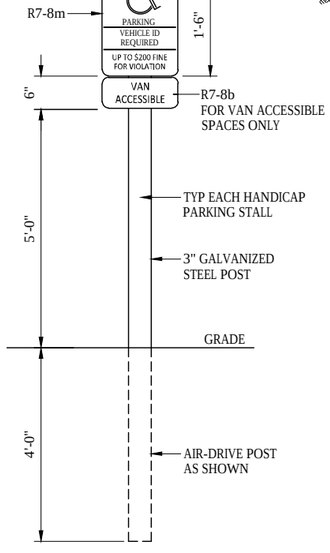

DISABLED PARKING SIGN

NOT TO SCALE

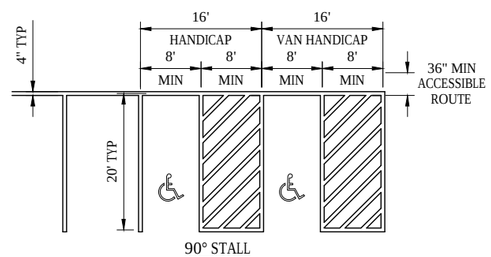

90° STALL

HANDICAP PARKING STRIPING

NOT TO SCALE

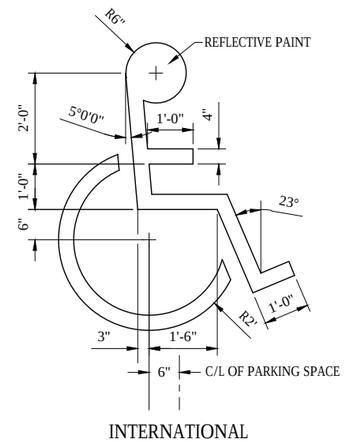

INTERNATIONAL HANDICAP SYMBOL

NOT TO SCALE

©Bolton & Menk, Inc. 2019. All Rights Reserved
H:\WASTEMAN_PR\R16\115896\CAD\C3D\115896G003.dwg 3/1/2019 4:00:10 PM

CONTRACTOR: Minger Construction

RECORD PLAN

ZGN 12-22-2020

I HEREBY CERTIFY THAT THIS PLAN, SPECIFICATION, OR REPORT WAS PREPARED BY ME OR UNDER MY DIRECT SUPERVISION AND THAT I AM A DULY LICENSED PROFESSIONAL ENGINEER UNDER THE LAWS OF THE STATE OF MINNESOTA.

Kevin F. Bittner

LIC. NO. 21814 DATE 03/01/2019

BOLTON & MENK
7533 SUNWOOD DR NW, SUITE 206
RAMSEY, MINNESOTA 55303
Phone: (763) 433-2851
Email: Ramsey@bolton-menk.com
www.bolton-menk.com

DESIGNED	KFB
DRAWN	KGA
CHECKED	KFB
CLIENT PROJ. NO.	R16.115896

NO.	REVISION	DATE

ELK RIVER LANDFILL INC.

WASTE WATER FORCEMAIN

DETAILS

SHEET 7 OF 46