


SCALES:
1"=50' HOR
1"=10' VER

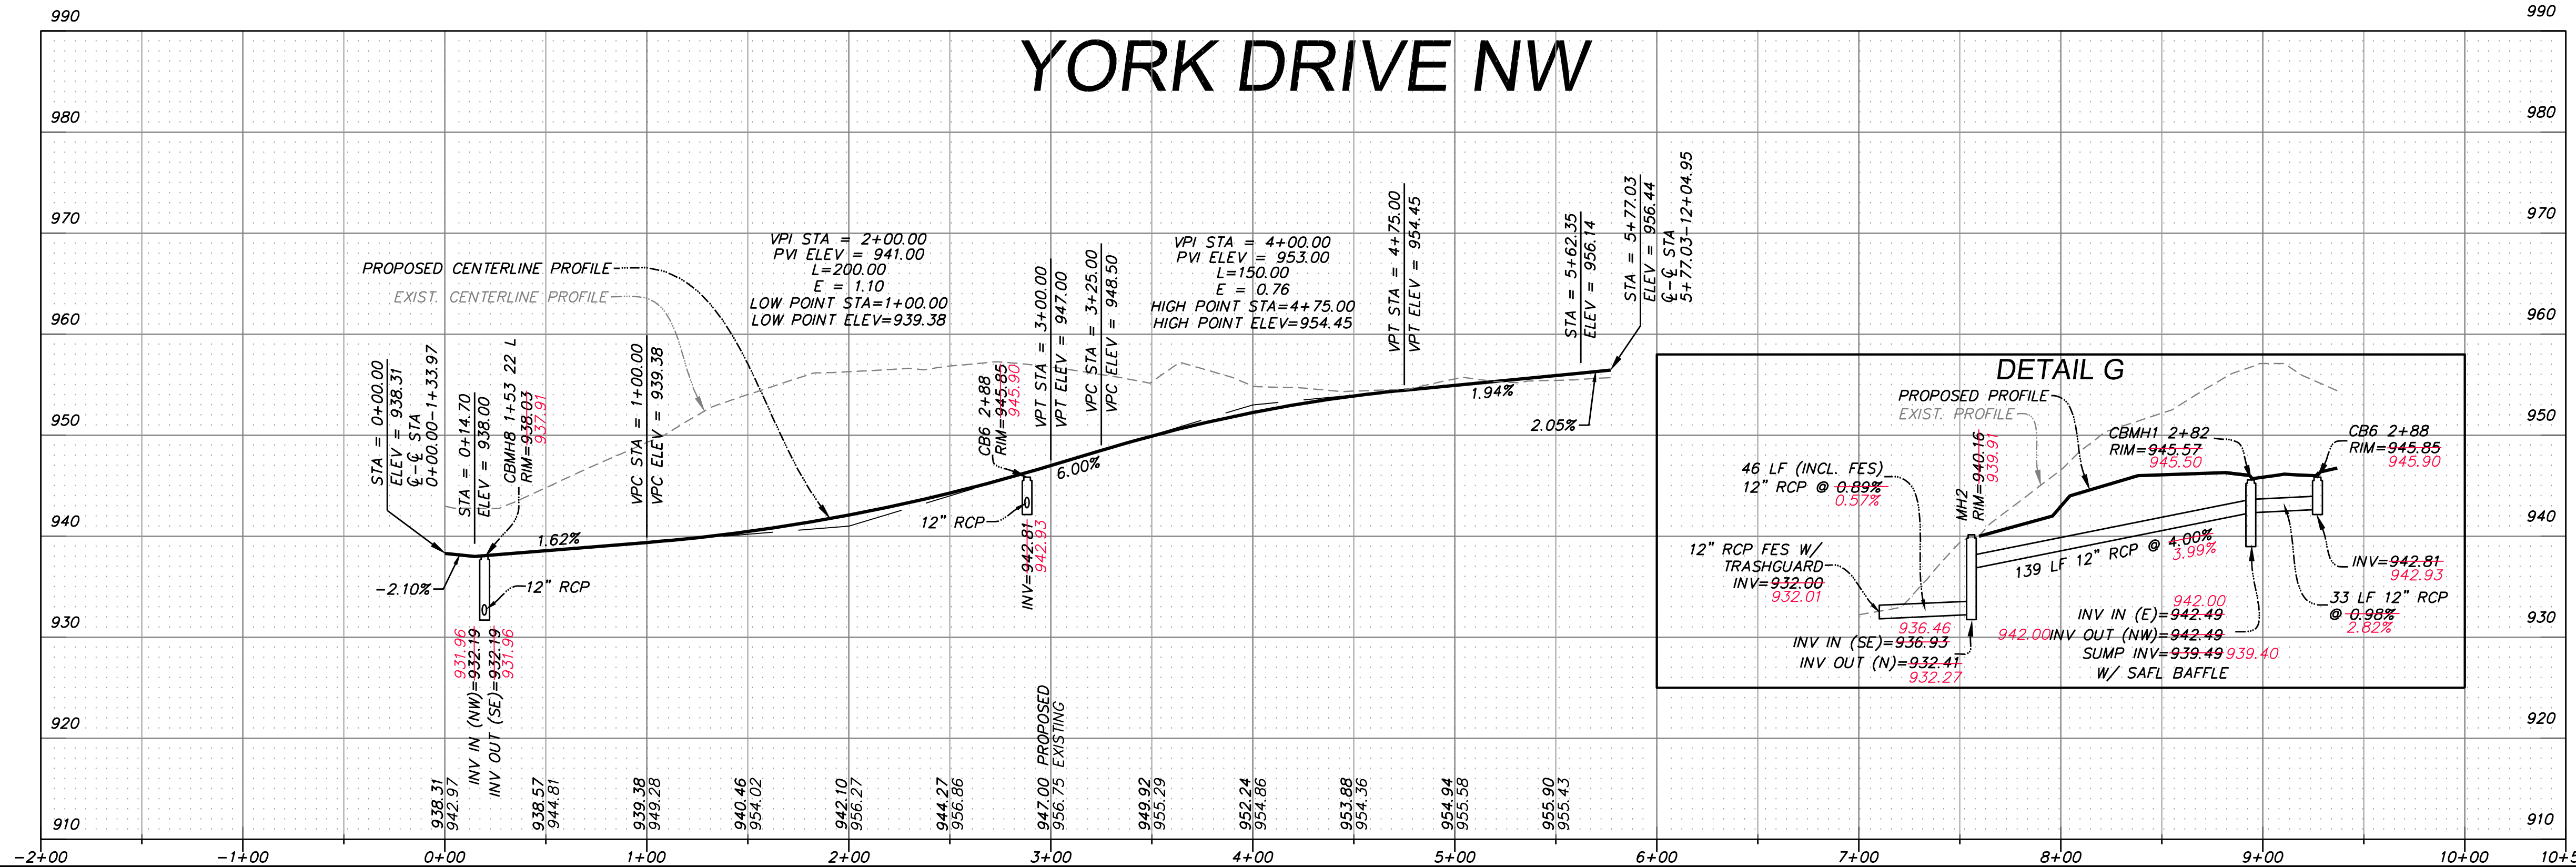

REV. NO.	DATE	BY	DESCRIPTION

DESIGNED: C.S.O.
DRAWN: T.J.B.
CHECKED: C.S.O.

I hereby certify that this plan, specification, or report was prepared by me or under my direct supervision and that I am a duly Licensed Professional Engineer under the laws of the State of Minnesota.

Cara M. Schwahn Otto
Cara M. Schwahn Otto
License # 40433
Date: 4-8-22

OTTO ASSOCIATES
Engineers & Land Surveyors, Inc.

www.ottoassociates.com
9 West Division Street
Buffalo, MN 55313
(763)682-4727
Fax: (763)682-3522

PRESTIGIOUS WOODLAND HILLS FIFTH ADDITION
BENZINGER PROPERTIES
ELK RIVER, MN

STREET & STORM SEWER PLAN
YORK DRIVE NW
SHEET NO. 7 OF 13 SHEETS

PROJECT NO: 19-0318
DATE: 2-1-22