


DRAWING NUMBER

DRAWING NUMBER

DRAWING NUMBER

DRAWING NUMBER

PLAN HOLD CORPORATION • IRVINE, CALIFORNIA
REGISTERED PROFESSIONAL ENGINEER
PIONEER ENGINEERING, INC. • IRVINE, CALIFORNIA
REGISTERED PROFESSIONAL ENGINEER

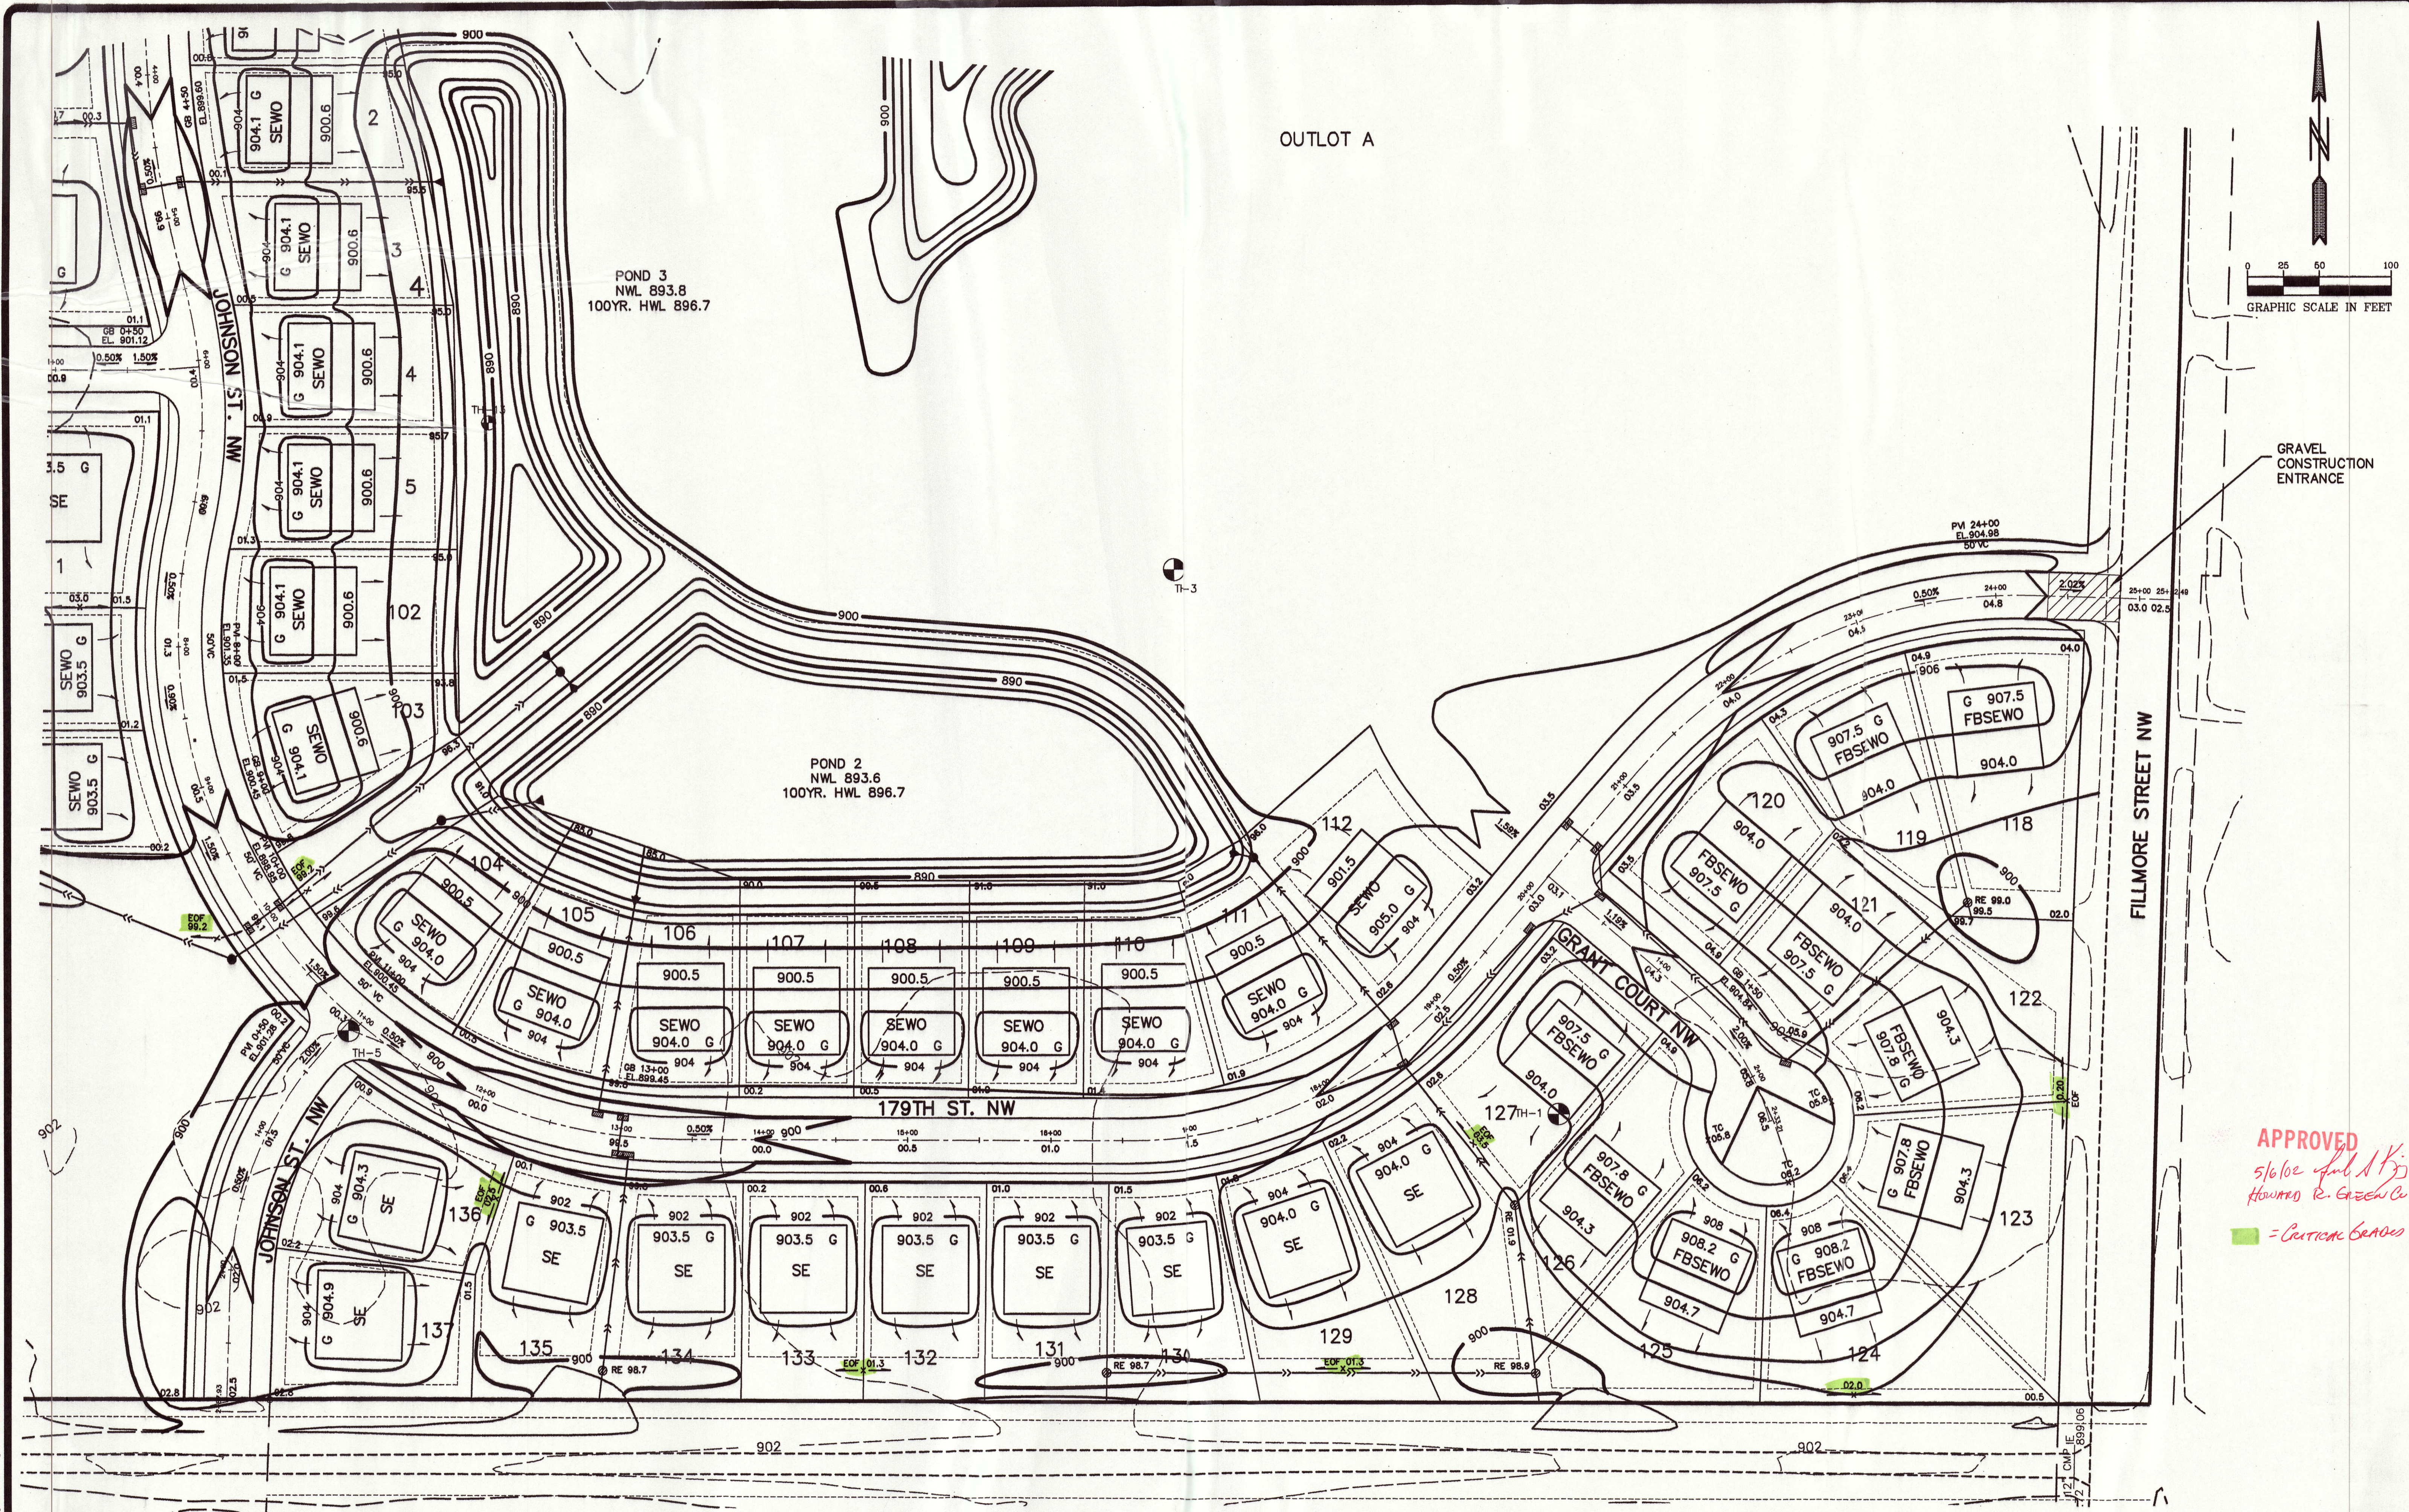

APPROVED
 5/6/02 *[Signature]*
 Howard R. Greenlee
 = Carbon Beams

PIONEER engineering
 2422 Enterprise Drive
 Irvine, CA 92614
 (949) 261-1111 FAX 949-261-1112
 WWW.PIONEERENGINEERING.COM

I hereby certify that this plan was prepared by me or under my direct supervision and that I am a duly Licensed Professional Engineer under the laws of the State of Minnesota.

Name: *[Signature]*
 Paul J. Cheng
 Reg. No. 19860 Date 7/28/01

Revisions
 1. 5/14/01
 2. 8/20/01
 3. 5/03/02
 4. 5/7/02

Date 7/26/01
 Designed PJC
 Drawn SAG

SHEET TITLE: GRADING, DEVELOPMENT AND EROSION CONTROL PLAN
 OWNER: GOLD NUGGET
 8857 ZEALAND AVENUE NORTH
 BROOKLYN PARK, MINNESOTA 55445

PROJECT: KLIEVER LAKE FIELDS
 ELK RIVER

SHEET 4 OF 5 SHEETS

J:\DWG\2007\ELK_RIVER\DWG\2007\650.dwg 5/27/2002 09:38:19 AM CDT