




248 Railroad Drive
Elk River, MN 55330
Phone: 763-635-1170

Owner City of Elk River	Pipe Number P23	Upstream MH 0873	Downstream MH 0874	Date 09-Jun-2021
Surveyor Andy	Street Albany/Medowvale		City Elk River	Time 9:50 AM
Size 8	Material PVC	Sewer Use Sanitary	Purpose Maintenance Related	Length 223.414 3
			(TV'd) 222.5	Pre-Clean Jetting
				Weather Dry

Comments

Medowvale inspection for replacement 6/9/21 #2

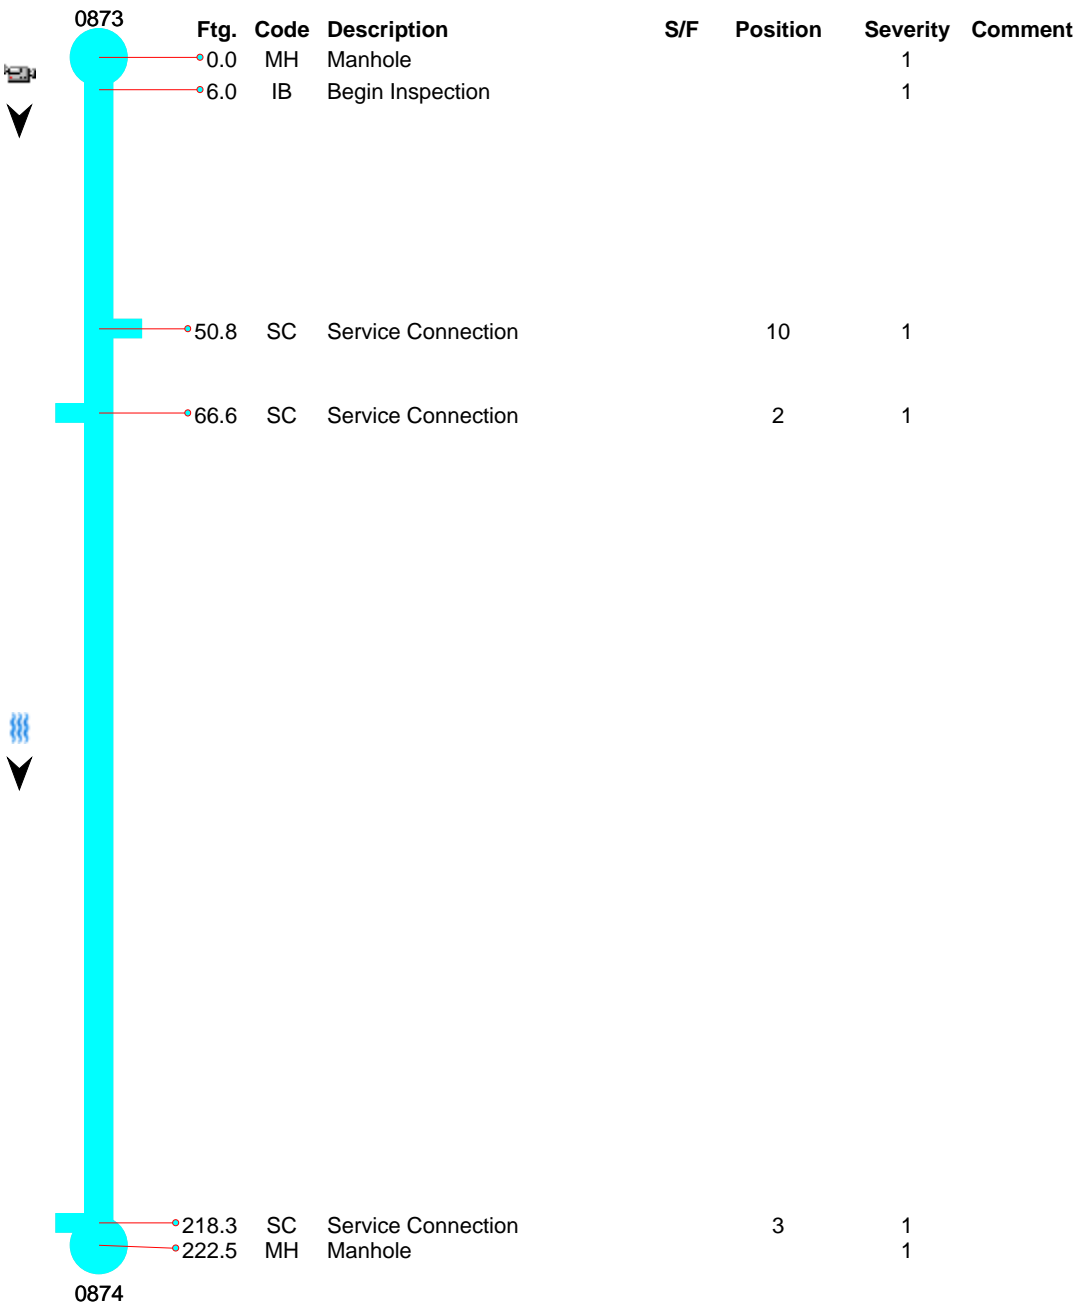



248 Railroad Drive
Elk River, MN 55330
Phone: 763-635-1170

Owner	Pipe Number	Upstream MH	Downstream MH	Date			
City of Elk River	P23	0873	0874	09-Jun-2021			
Surveyor	Street		City	Time			
Andy	Albany/Medowvale		Elk River	9:50 AM			
Size	Material	Sewer Use	Purpose	Length	(TV'd)	Pre-Clean	Weather
8	PVC	Sanitary	Maintenance Related	223.414 3	222.5	Jetting	Dry

Comments

Medowvale inspection for replacement 6/9/21 #2



MH - Manhole @ 0.0 ft.



248 Railroad Drive
Elk River, MN 55330
Phone: 763-635-1170

Owner	Pipe Number	Upstream MH	Downstream MH	Date			
City of Elk River	P23	0873	0874	09-Jun-2021			
Surveyor	Street	City	Time				
Andy	Albany/Medowvale	Elk River	9:50 AM				
Size	Material	Sewer Use	Purpose	Length	(TV'd)	Pre-Clean	Weather
8	PVC	Sanitary	Maintenance Related	223.414 3	222.5	Jetting	Dry

Comments

Medowvale inspection for replacement 6/9/21 #2



IB - Begin Inspection @ 6.0 ft.




248 Railroad Drive
Elk River, MN 55330
Phone: 763-635-1170

Owner	Pipe Number	Upstream MH	Downstream MH	Date			
City of Elk River	P23	0873	0874	09-Jun-2021			
Surveyor	Street	City	Time				
Andy	Albany/Medowvale	Elk River	9:50 AM				
Size	Material	Sewer Use	Purpose	Length	(TV'd)	Pre-Clean	Weather
8	PVC	Sanitary	Maintenance Related	223.414 3	222.5	Jetting	Dry

Comments

Medowvale inspection for replacement 6/9/21 #2

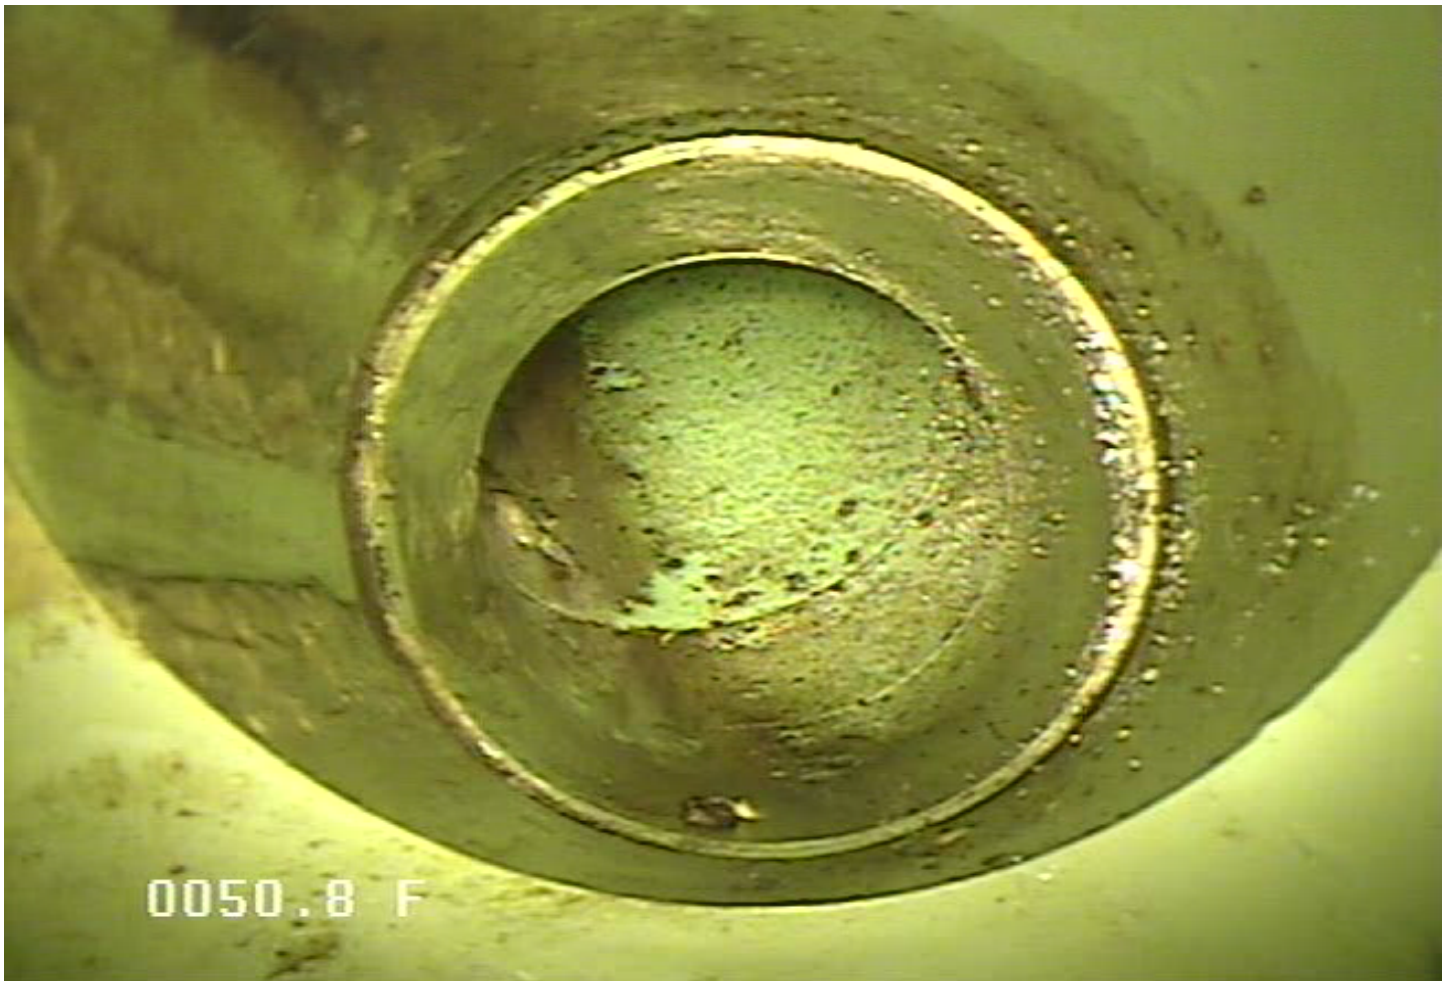

SC - Service Connection @ 50.8 ft.




248 Railroad Drive
Elk River, MN 55330
Phone: 763-635-1170

Owner City of Elk River	Pipe Number P23	Upstream MH 0873	Downstream MH 0874	Date 09-Jun-2021			
Surveyor Andy	Street Albany/Medowvale		City Elk River	Time 9:50 AM			
Size 8	Material PVC	Sewer Use Sanitary	Purpose Maintenance Related	Length 223.414 3	(TV'd) 222.5	Pre-Clean Jetting	Weather Dry

Comments

Medowvale inspection for replacement 6/9/21 #2

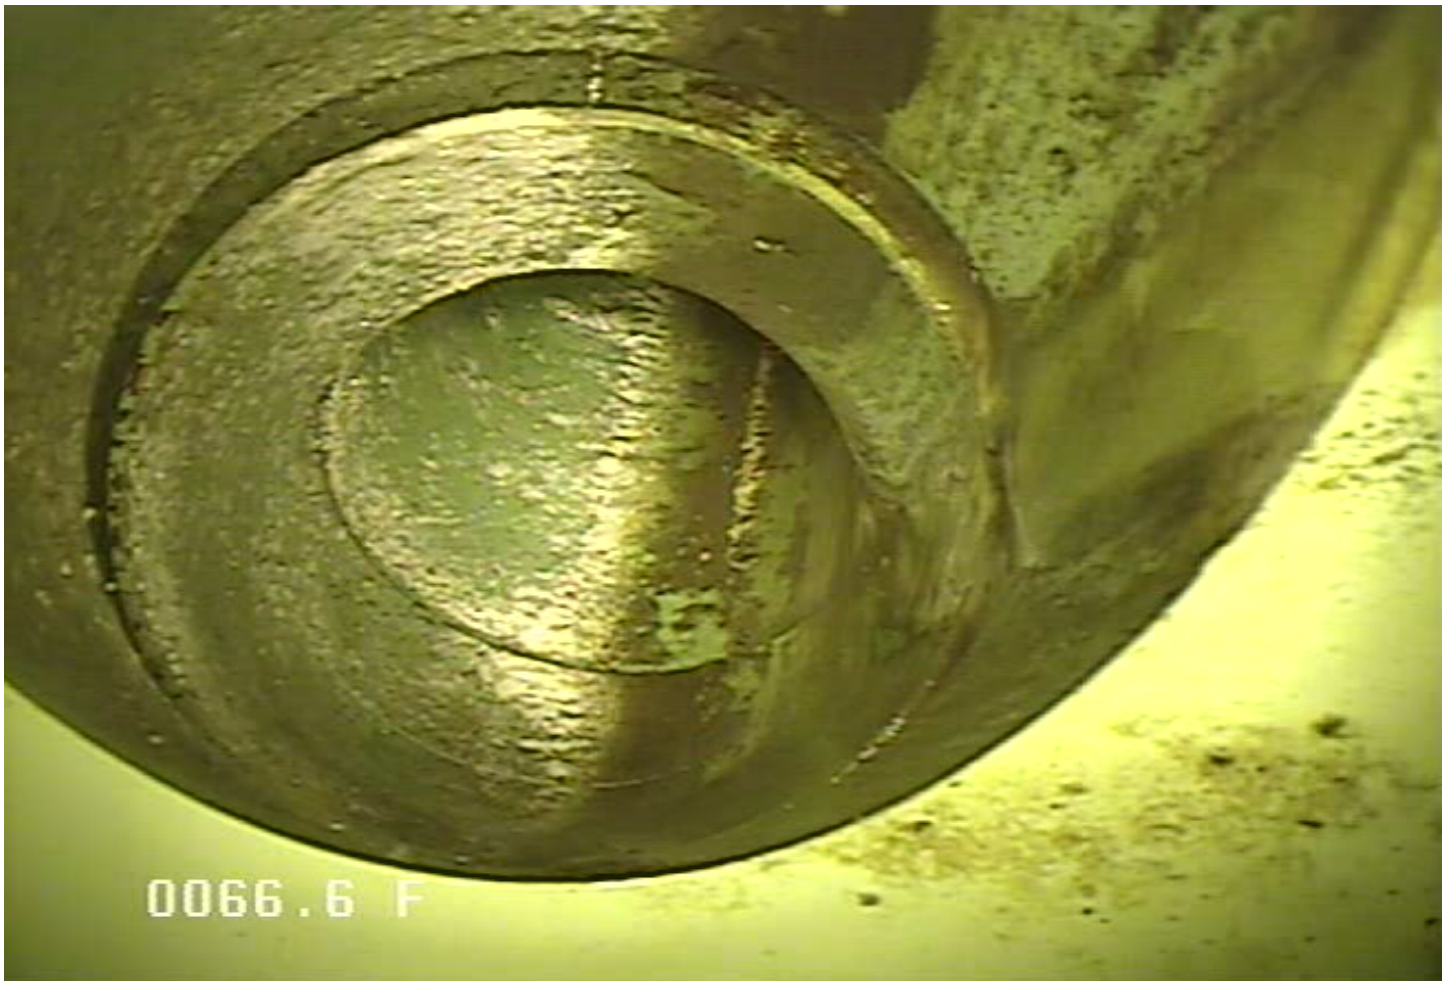

SC - Service Connection @ 66.6 ft.




248 Railroad Drive
Elk River, MN 55330
Phone: 763-635-1170

Owner City of Elk River	Pipe Number P23	Upstream MH 0873	Downstream MH 0874	Date 09-Jun-2021			
Surveyor Andy	Street Albany/Medowvale		City Elk River	Time 9:50 AM			
Size 8	Material PVC	Sewer Use Sanitary	Purpose Maintenance Related	Length 223.414 3	(TV'd) 222.5	Pre-Clean Jetting	Weather Dry

Comments

Medowvale inspection for replacement 6/9/21 #2

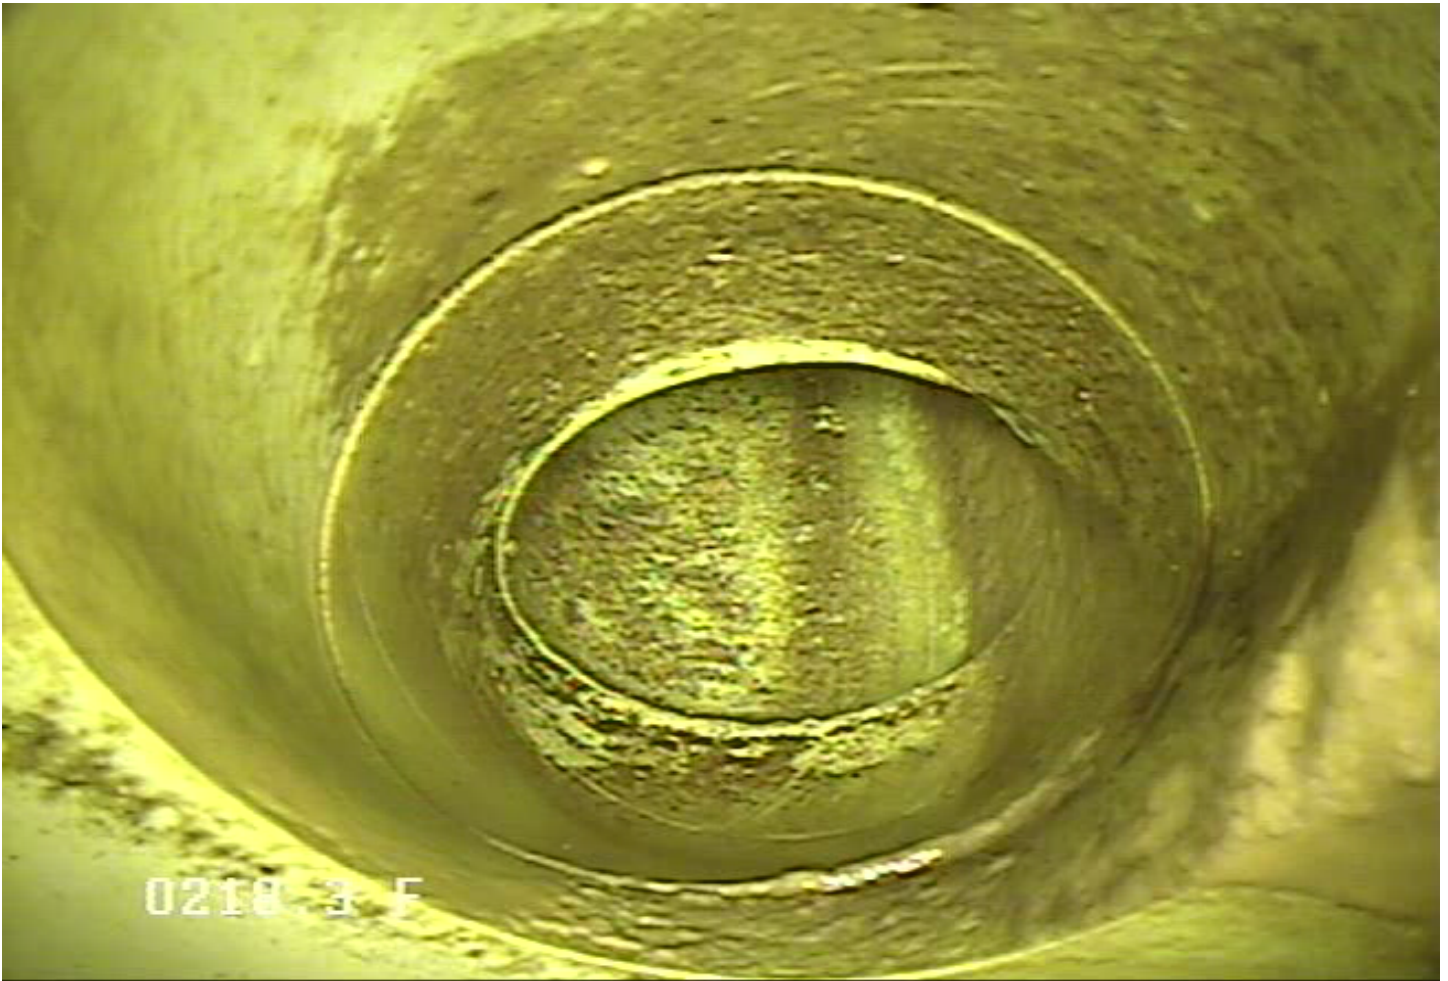

SC - Service Connection @ 218.3 ft.




248 Railroad Drive
Elk River, MN 55330
Phone: 763-635-1170

Owner	Pipe Number	Upstream MH	Downstream MH	Date			
City of Elk River	P23	0873	0874	09-Jun-2021			
Surveyor	Street	City	Time				
Andy	Albany/Medowvale	Elk River	9:50 AM				
Size	Material	Sewer Use	Purpose	Length	(TV'd)	Pre-Clean	Weather
8	PVC	Sanitary	Maintenance Related	223.414 3	222.5	Jetting	Dry

Comments

Medowvale inspection for replacement 6/9/21 #2

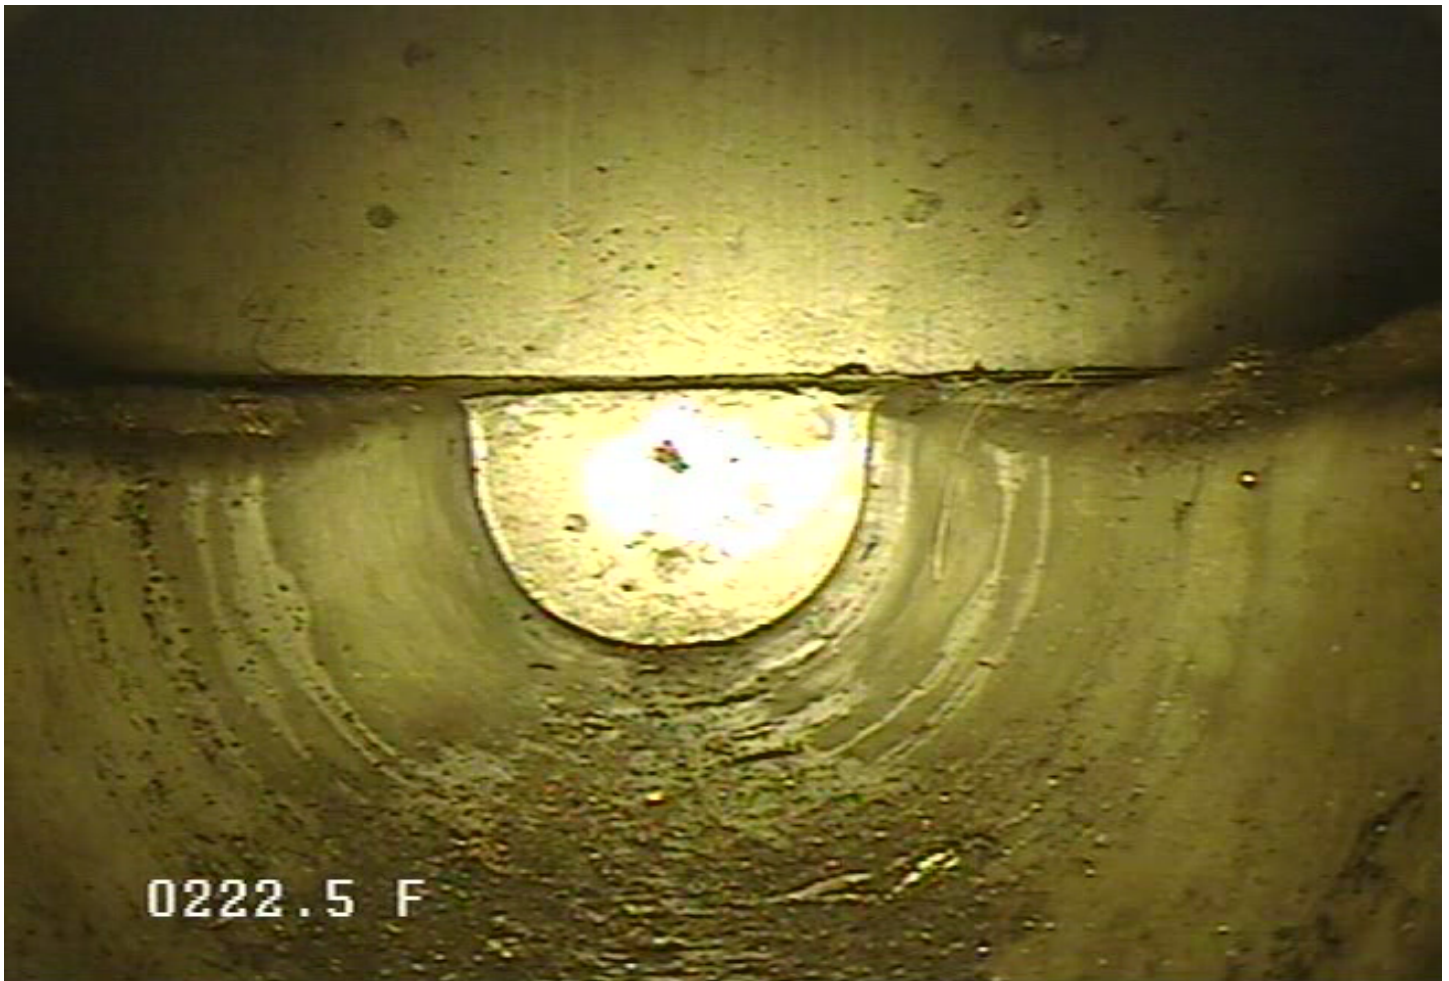

MH - Manhole @ 222.5 ft.



248 Railroad Drive
Elk River, MN 55330
Phone: 763-635-1170

Owner	Pipe Number	Upstream MH	Downstream MH	Date			
City of Elk River	P23	0873	0874	09-Jun-2021			
Surveyor	Street	City	Time				
Andy	Albany/Medowvale	Elk River	9:50 AM				
Size	Material	Sewer Use	Purpose	Length	(TV'd)	Pre-Clean	Weather
8	PVC	Sanitary	Maintenance Related	223.414 3	222.5	Jetting	Dry

Comments

Medowvale inspection for replacement 6/9/21 #2

