




248 Railroad Drive
Elk River, MN 55330
Phone: 763-635-1170

Owner City of Elk River	Pipe Number P24	Upstream MH 50	Downstream MH 57	Date 13-Mar-2023
Surveyor Andy and Chris	Street Boston		City Elk River	Time 2:37 PM
Size 8	Material PVC	Sewer Use Sanitary	Purpose Annual Review	Length 251.007 1
			(TV'd) 244.1	Pre-Clean No Pre-Cleaning
				Weather Dry

Comments

P24

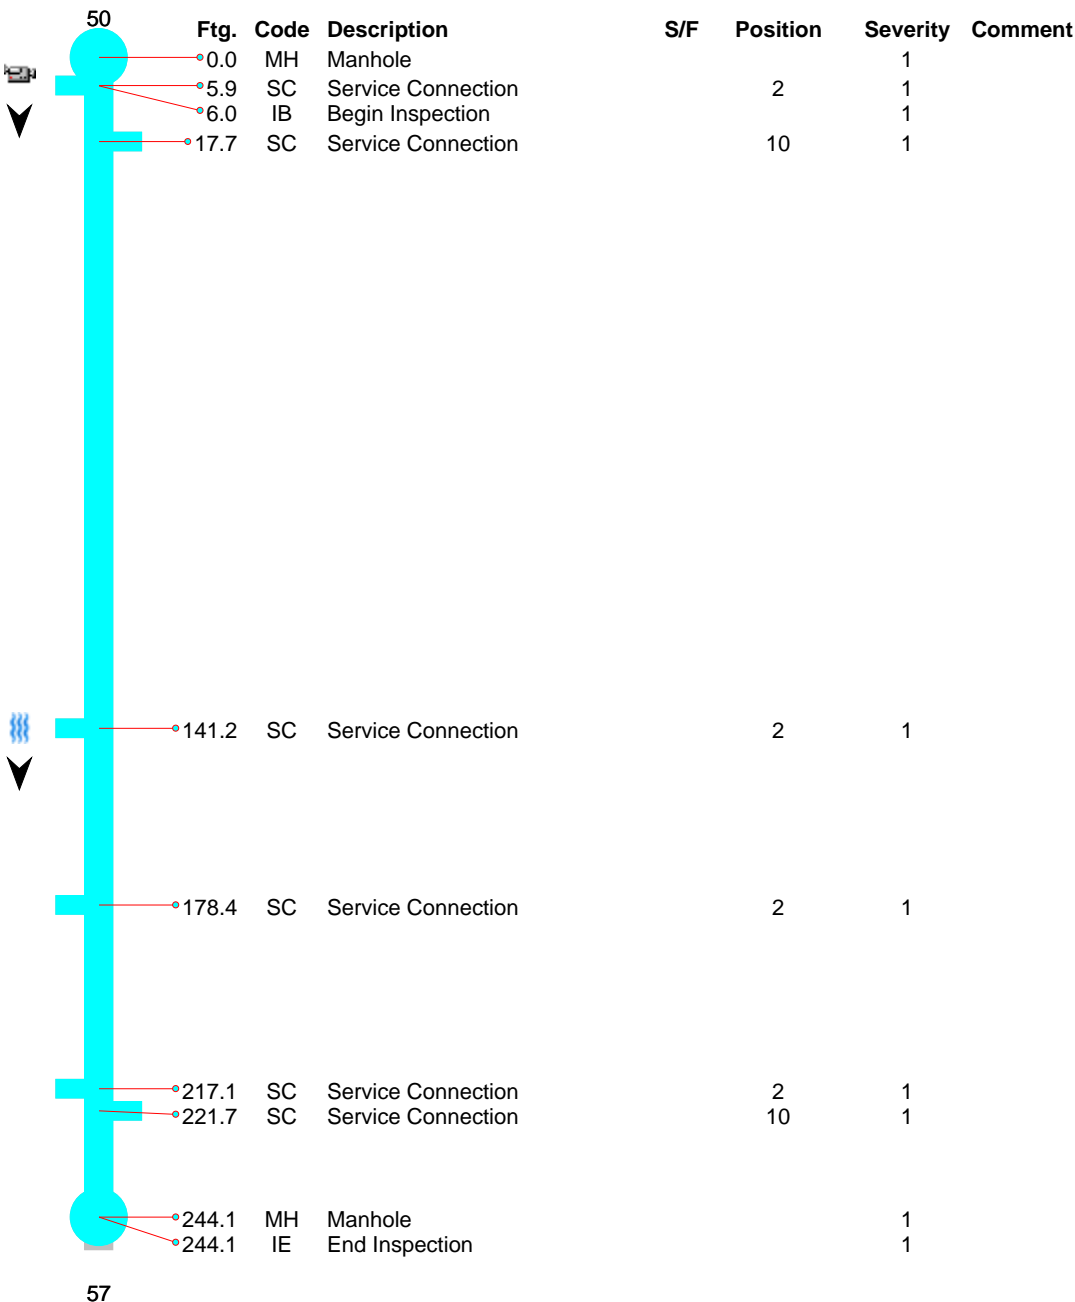



248 Railroad Drive
Elk River, MN 55330
Phone: 763-635-1170

Owner	Pipe Number	Upstream MH	Downstream MH	Date
City of Elk River	P24	50	57	13-Mar-2023
Surveyor	Street			City
Andy and Chris	Boston			Elk River
Time	Size	Material	Sewer Use	Purpose
2:37 PM	8	PVC	Sanitary	Annual Review
	Length	(TV'd)	Pre-Clean	Weather
	251.007 1	244.1	No Pre-Cleaning	Dry

Comments

P24



MH - Manhole @ 0.0 ft.




248 Railroad Drive
Elk River, MN 55330
Phone: 763-635-1170

Owner	Pipe Number	Upstream MH	Downstream MH	Date			
City of Elk River	P24	50	57	13-Mar-2023			
Surveyor	Street	City	Time				
Andy and Chris	Boston	Elk River	2:37 PM				
Size	Material	Sewer Use	Purpose	Length	(TV'd)	Pre-Clean	Weather
8	PVC	Sanitary	Annual Review	251.007 1	244.1	No Pre-Cleaning	Dry

Comments

P24

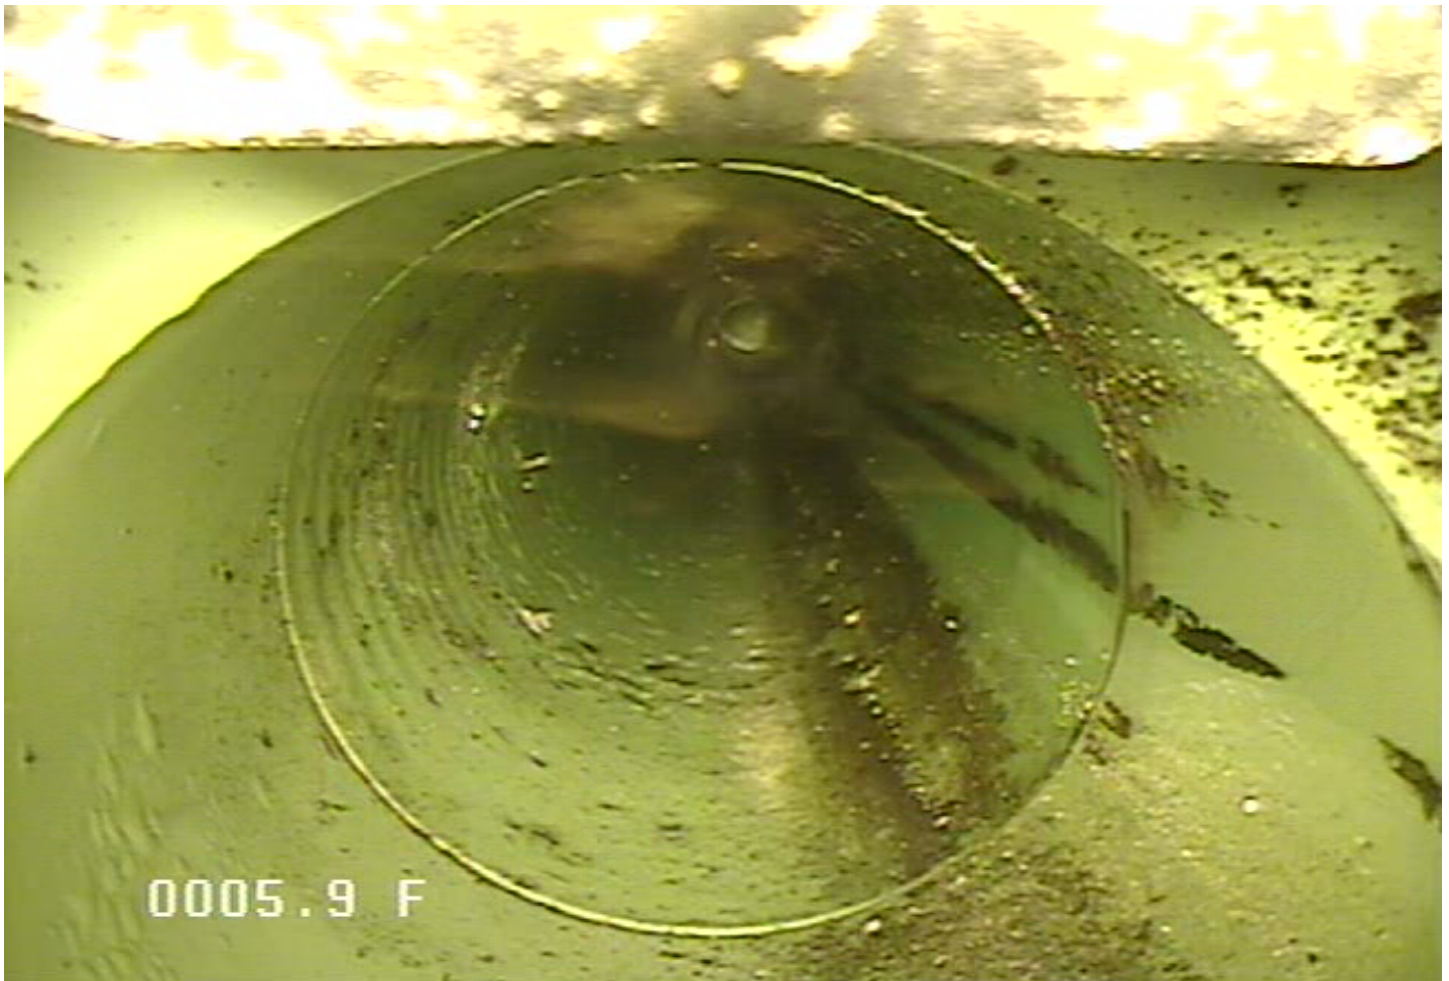

SC - Service Connection @ 5.9 ft.



248 Railroad Drive
Elk River, MN 55330
Phone: 763-635-1170

Owner	Pipe Number	Upstream MH	Downstream MH	Date			
City of Elk River	P24	50	57	13-Mar-2023			
Surveyor	Street	City	Time				
Andy and Chris	Boston	Elk River	2:37 PM				
Size	Material	Sewer Use	Purpose	Length	(TV'd)	Pre-Clean	Weather
8	PVC	Sanitary	Annual Review	251.007 1	244.1	No Pre-Cleaning	Dry

Comments

P24



IB - Begin Inspection @ 6.0 ft.




248 Railroad Drive
Elk River, MN 55330
Phone: 763-635-1170

Owner	Pipe Number	Upstream MH	Downstream MH	Date			
City of Elk River	P24	50	57	13-Mar-2023			
Surveyor	Street		City	Time			
Andy and Chris	Boston		Elk River	2:37 PM			
Size	Material	Sewer Use	Purpose	Length	(TV'd)	Pre-Clean	Weather
8	PVC	Sanitary	Annual Review	251.007 1	244.1	No Pre-Cleaning	Dry

Comments

P24

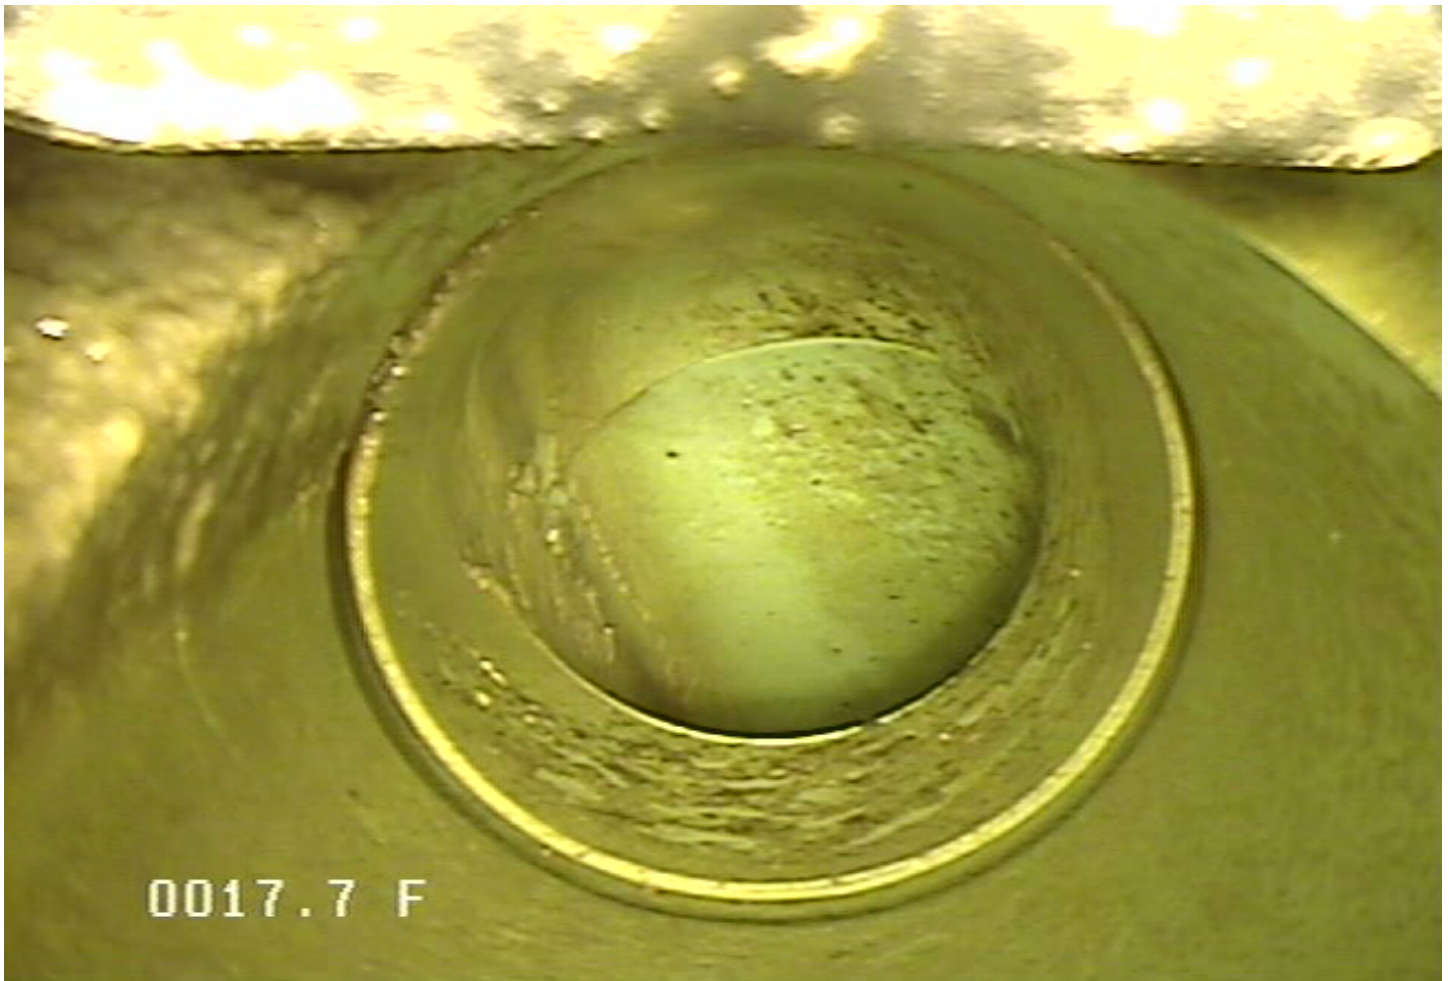

SC - Service Connection @ 17.7 ft.




248 Railroad Drive
Elk River, MN 55330
Phone: 763-635-1170

Owner	Pipe Number	Upstream MH	Downstream MH	Date			
City of Elk River	P24	50	57	13-Mar-2023			
Surveyor	Street		City	Time			
Andy and Chris	Boston		Elk River	2:37 PM			
Size	Material	Sewer Use	Purpose	Length	(TV'd)	Pre-Clean	Weather
8	PVC	Sanitary	Annual Review	251.007 1	244.1	No Pre-Cleaning	Dry

Comments

P24

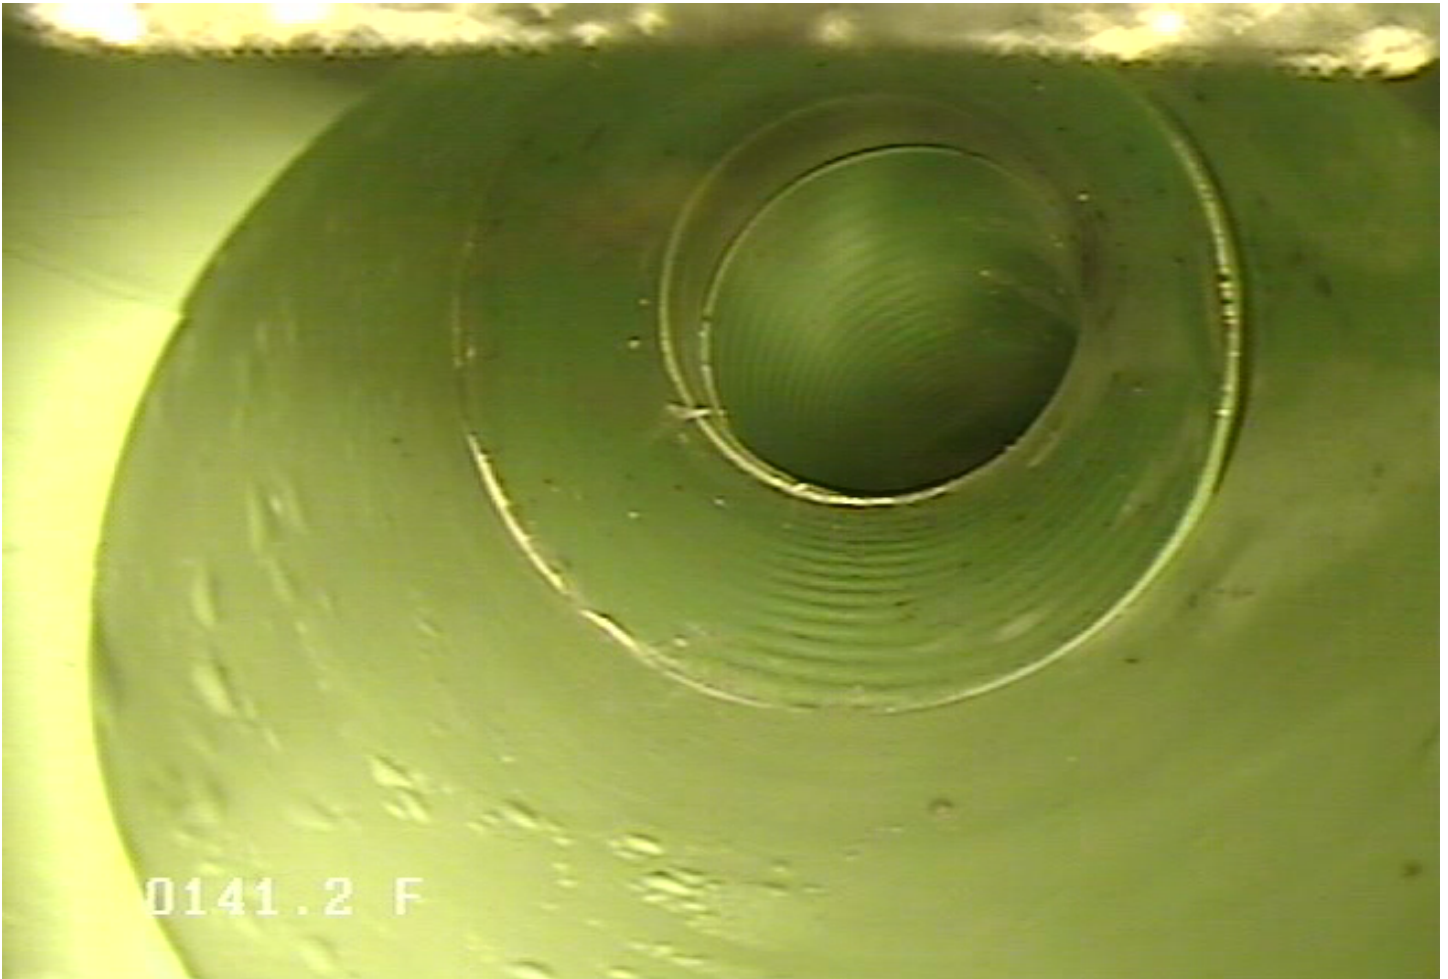

SC - Service Connection @ 141.2 ft.




248 Railroad Drive
Elk River, MN 55330
Phone: 763-635-1170

Owner	Pipe Number	Upstream MH	Downstream MH	Date			
City of Elk River	P24	50	57	13-Mar-2023			
Surveyor	Street	City	Time				
Andy and Chris	Boston	Elk River	2:37 PM				
Size	Material	Sewer Use	Purpose	Length	(TV'd)	Pre-Clean	Weather
8	PVC	Sanitary	Annual Review	251.007 1	244.1	No Pre-Cleaning	Dry

Comments

P24

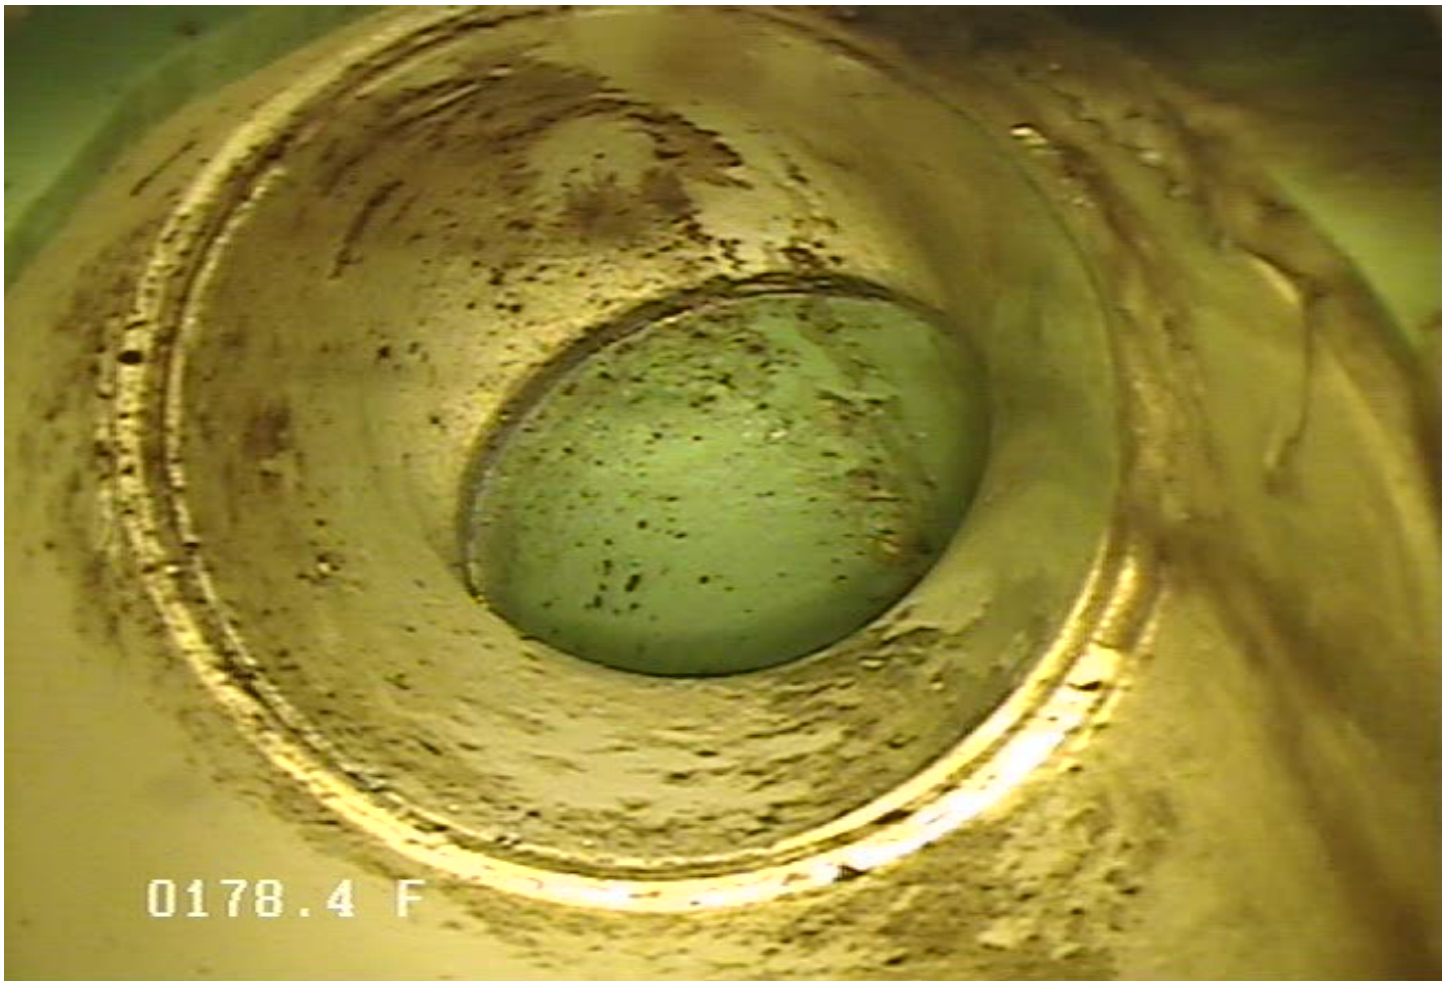

SC - Service Connection @ 178.4 ft.




248 Railroad Drive
Elk River, MN 55330
Phone: 763-635-1170

Owner	Pipe Number	Upstream MH	Downstream MH	Date			
City of Elk River	P24	50	57	13-Mar-2023			
Surveyor	Street	City	Time				
Andy and Chris	Boston	Elk River	2:37 PM				
Size	Material	Sewer Use	Purpose	Length	(TV'd)	Pre-Clean	Weather
8	PVC	Sanitary	Annual Review	251.007 1	244.1	No Pre-Cleaning	Dry

Comments

P24

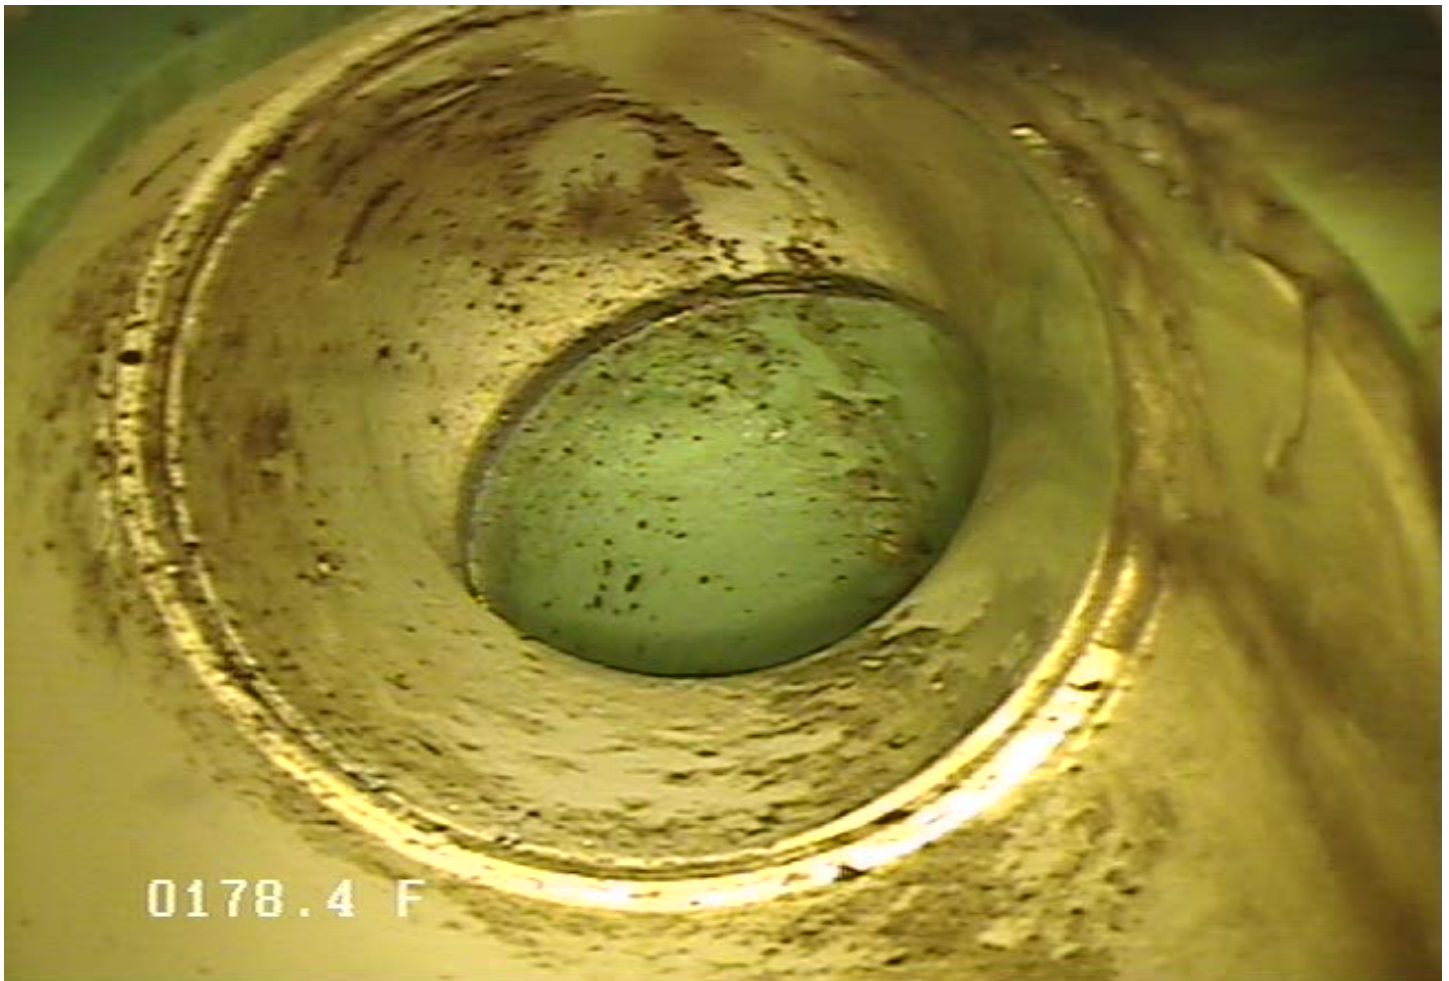

SC - Service Connection @ 217.1 ft.



248 Railroad Drive
Elk River, MN 55330
Phone: 763-635-1170

Owner	Pipe Number	Upstream MH	Downstream MH	Date			
City of Elk River	P24	50	57	13-Mar-2023			
Surveyor	Street	City	Time				
Andy and Chris	Boston	Elk River	2:37 PM				
Size	Material	Sewer Use	Purpose	Length	(TV'd)	Pre-Clean	Weather
8	PVC	Sanitary	Annual Review	251.007 1	244.1	No Pre-Cleaning	Dry

Comments

P24



SC - Service Connection @ 221.7 ft.




248 Railroad Drive
Elk River, MN 55330
Phone: 763-635-1170

Owner	Pipe Number	Upstream MH	Downstream MH	Date			
City of Elk River	P24	50	57	13-Mar-2023			
Surveyor	Street	City	Time				
Andy and Chris	Boston	Elk River	2:37 PM				
Size	Material	Sewer Use	Purpose	Length	(TV'd)	Pre-Clean	Weather
8	PVC	Sanitary	Annual Review	251.007 1	244.1	No Pre-Cleaning	Dry

Comments

P24

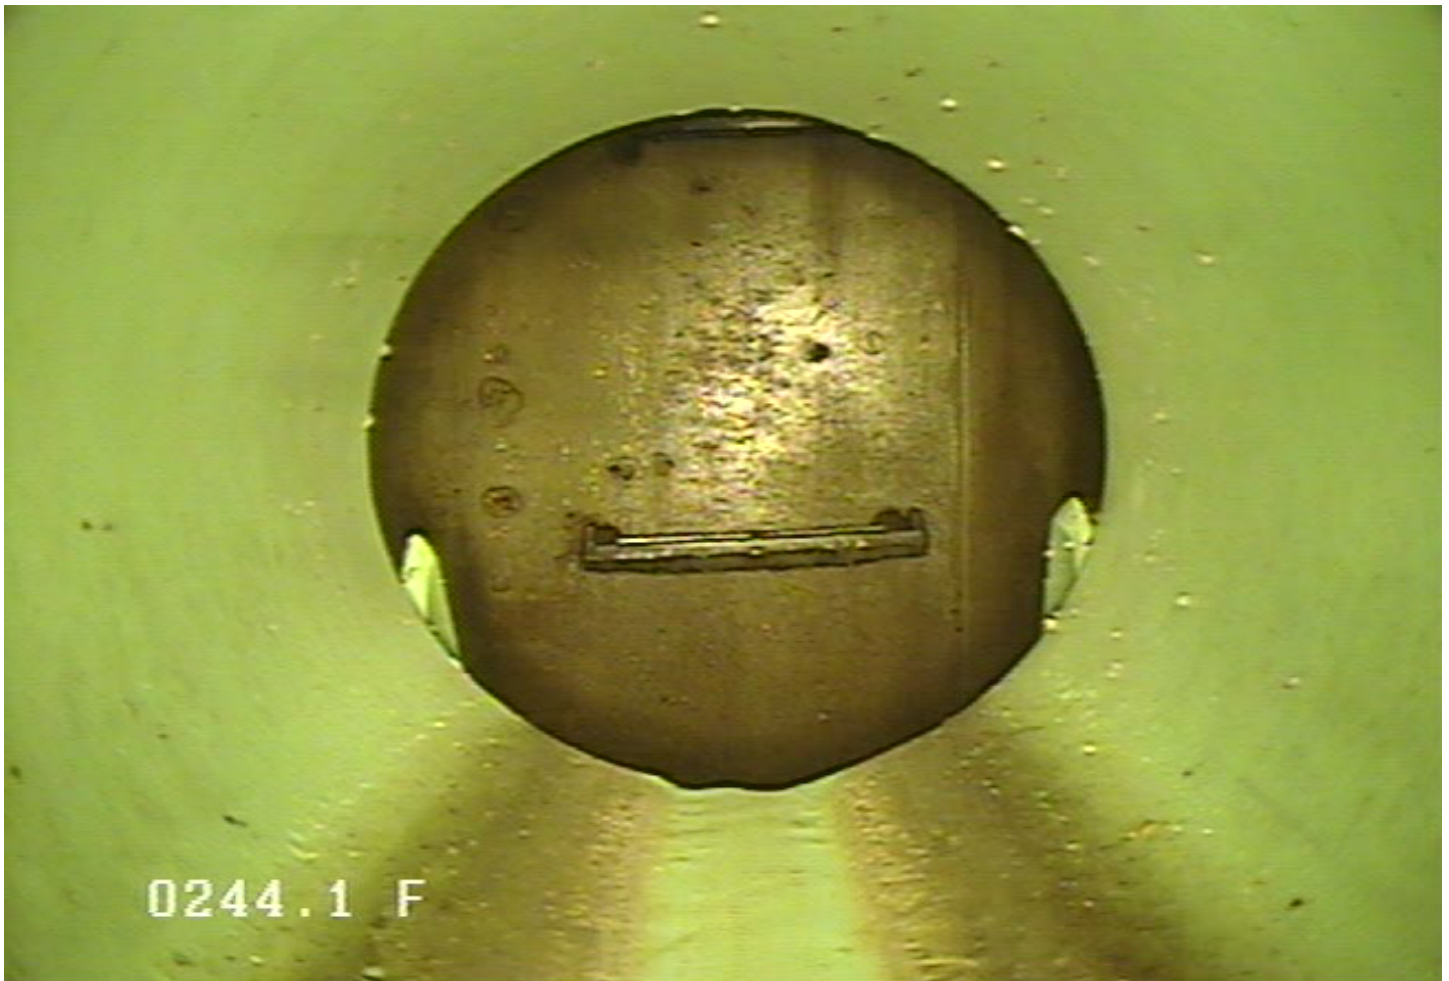

MH - Manhole @ 244.1 ft.




248 Railroad Drive
Elk River, MN 55330
Phone: 763-635-1170

Owner City of Elk River	Pipe Number P24	Upstream MH 50	Downstream MH 57	Date 13-Mar-2023			
Surveyor Andy and Chris	Street Boston		City Elk River	Time 2:37 PM			
Size 8	Material PVC	Sewer Use Sanitary	Purpose Annual Review	Length 251.007 1	(TV'd) 244.1	Pre-Clean No Pre-Cleaning	Weather Dry

Comments

P24

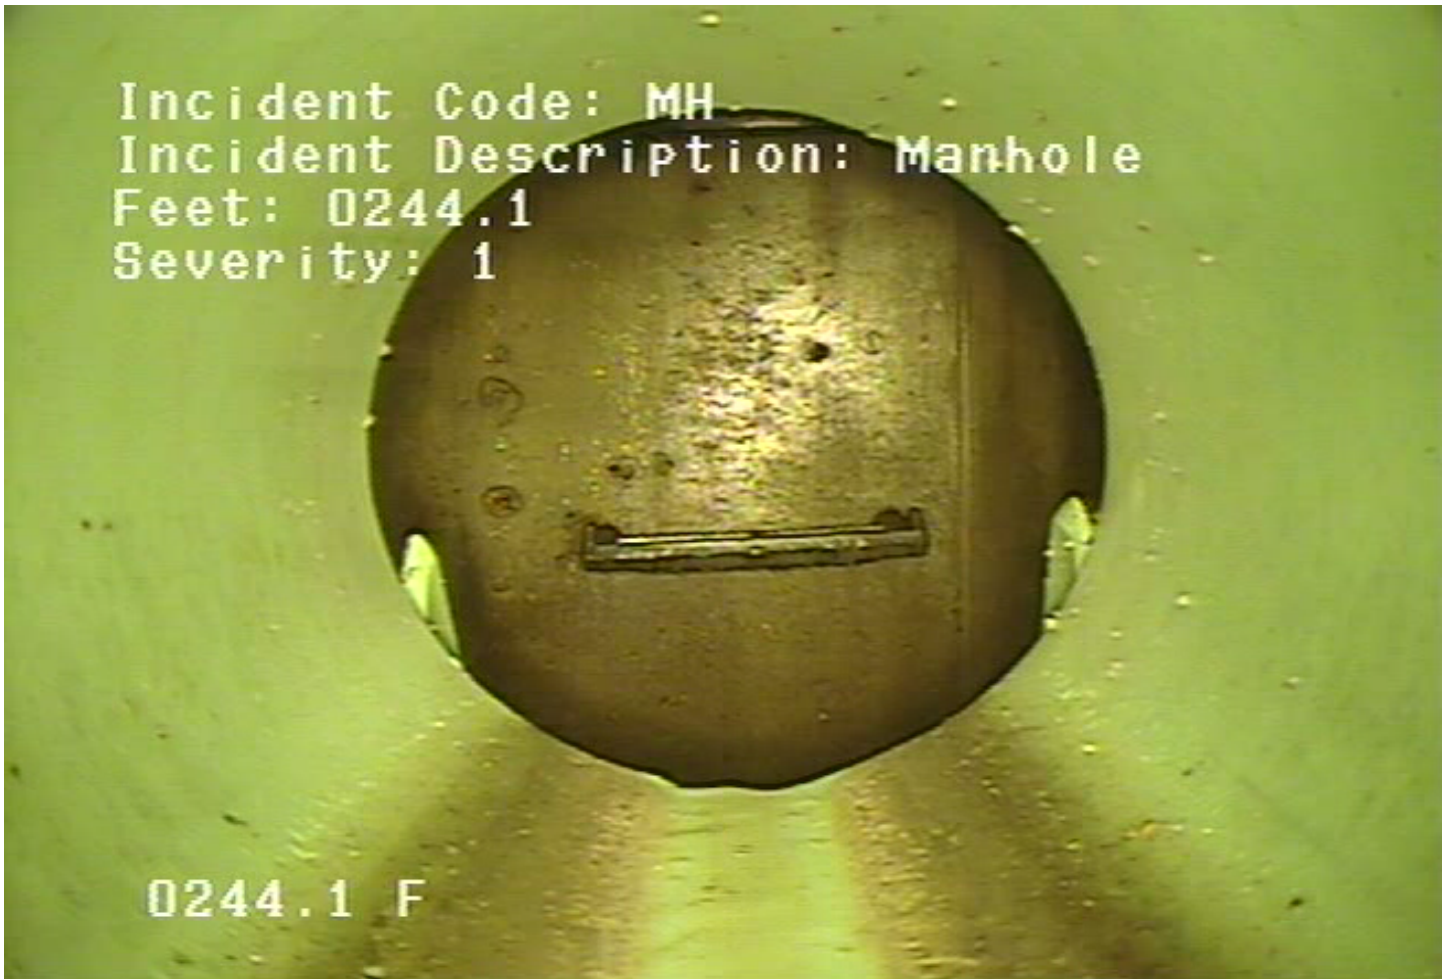

IE - End Inspection @ 244.1 ft.



248 Railroad Drive
Elk River, MN 55330
Phone: 763-635-1170

Owner City of Elk River	Pipe Number P24	Upstream MH 50	Downstream MH 57	Date 13-Mar-2023			
Surveyor Andy and Chris	Street Boston		City Elk River	Time 2:37 PM			
Size 8	Material PVC	Sewer Use Sanitary	Purpose Annual Review	Length 251.007 1	(TV'd) 244.1	Pre-Clean No Pre-Cleaning	Weather Dry

Comments

P24

