




248 Railroad Drive  
Elk River, MN 55330  
Phone: 763-635-1170

<b>Owner</b> City of Elk River	<b>Pipe Number</b> P28	<b>Upstream MH</b> 60	<b>Downstream MH</b> 59	<b>Date</b> 13-Mar-2023
<b>Surveyor</b> Andy and Chris	<b>Street</b> Boston		<b>City</b> Elk River	<b>Time</b> 1:58 PM
<b>Size</b> 8	<b>Material</b> PVC	<b>Sewer Use</b> Sanitary	<b>Purpose</b> Annual Review	<b>Length</b> 296.574 7
			<b>(TV'd)</b> 480.6	<b>Pre-Clean</b> No Pre-Cleaning
				<b>Weather</b> Dry

### Comments

P28
-----

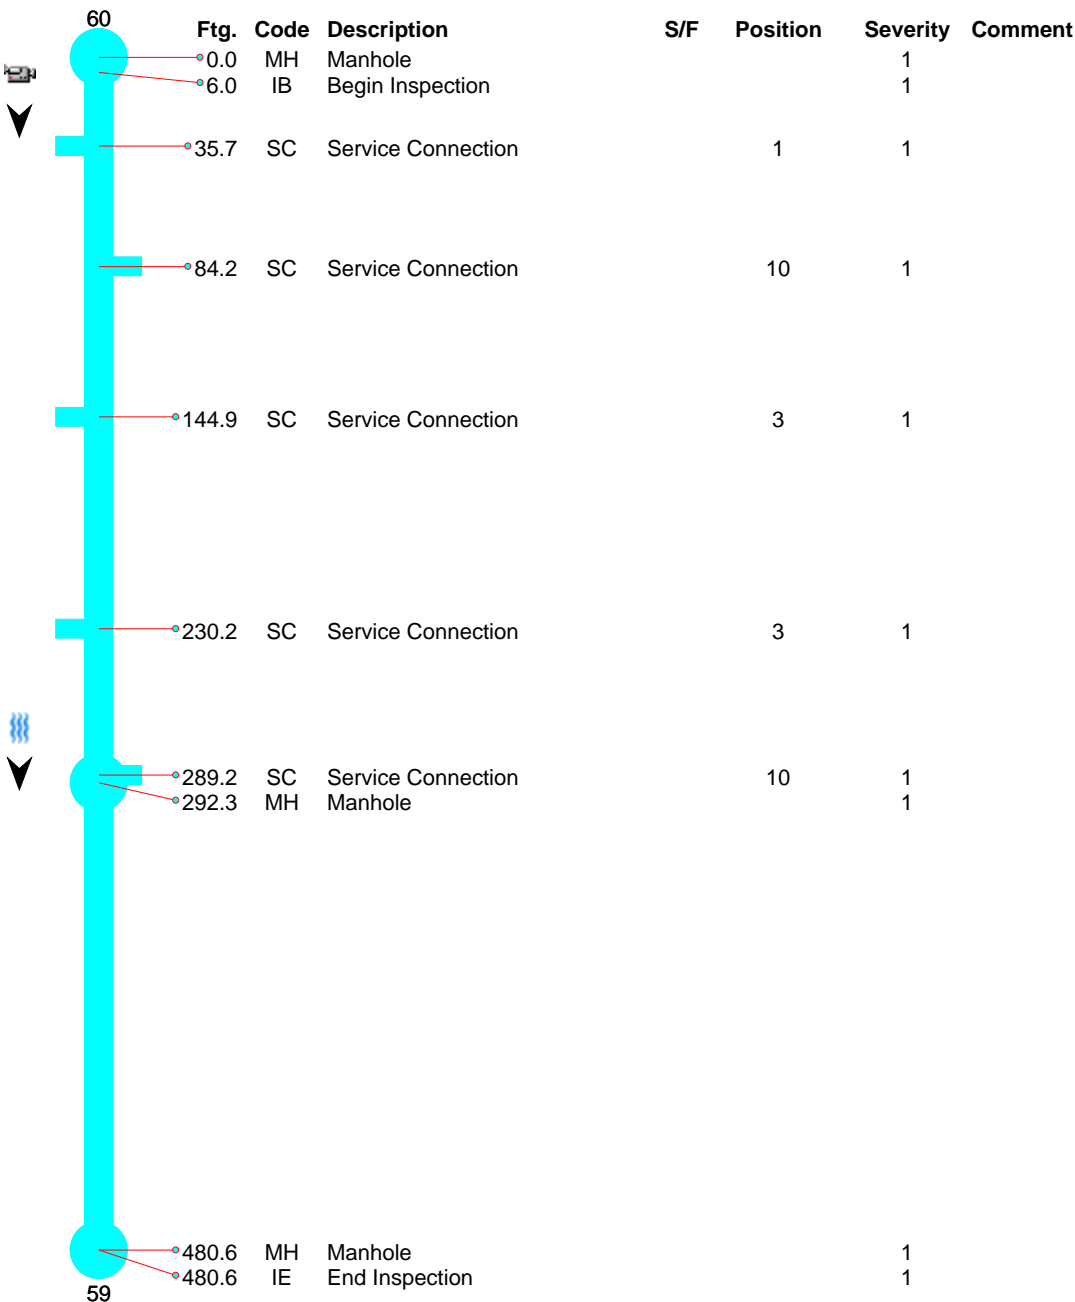



248 Railroad Drive  
Elk River, MN 55330  
Phone: 763-635-1170

<b>Owner</b>	<b>Pipe Number</b>	<b>Upstream MH</b>	<b>Downstream MH</b>	<b>Date</b>			
City of Elk River	P28	60	59	13-Mar-2023			
<b>Surveyor</b>	<b>Street</b>		<b>City</b>	<b>Time</b>			
Andy and Chris	Boston		Elk River	1:58 PM			
<b>Size</b>	<b>Material</b>	<b>Sewer Use</b>	<b>Purpose</b>	<b>Length</b>	<b>(TV'd)</b>	<b>Pre-Clean</b>	<b>Weather</b>
8	PVC	Sanitary	Annual Review	296.574 7	480.6	No Pre-Cleaning	Dry

**Comments**

P28



MH - Manhole @ 0.0 ft.



248 Railroad Drive  
Elk River, MN 55330  
Phone: 763-635-1170

<b>Owner</b>	<b>Pipe Number</b>	<b>Upstream MH</b>	<b>Downstream MH</b>	<b>Date</b>			
City of Elk River	P28	60	59	13-Mar-2023			
<b>Surveyor</b>	<b>Street</b>	<b>City</b>	<b>Time</b>				
Andy and Chris	Boston	Elk River	1:58 PM				
<b>Size</b>	<b>Material</b>	<b>Sewer Use</b>	<b>Purpose</b>	<b>Length</b>	<b>(TV'd)</b>	<b>Pre-Clean</b>	<b>Weather</b>
8	PVC	Sanitary	Annual Review	296.574 7	480.6	No Pre-Cleaning	Dry

**Comments**

P28



IB - Begin Inspection @ 6.0 ft.




248 Railroad Drive  
Elk River, MN 55330  
Phone: 763-635-1170

<b>Owner</b>	<b>Pipe Number</b>	<b>Upstream MH</b>	<b>Downstream MH</b>	<b>Date</b>			
City of Elk River	P28	60	59	13-Mar-2023			
<b>Surveyor</b>	<b>Street</b>	<b>City</b>	<b>Time</b>				
Andy and Chris	Boston	Elk River	1:58 PM				
<b>Size</b>	<b>Material</b>	<b>Sewer Use</b>	<b>Purpose</b>	<b>Length</b>	<b>(TV'd)</b>	<b>Pre-Clean</b>	<b>Weather</b>
8	PVC	Sanitary	Annual Review	296.574 7	480.6	No Pre-Cleaning	Dry

**Comments**

P28
-----

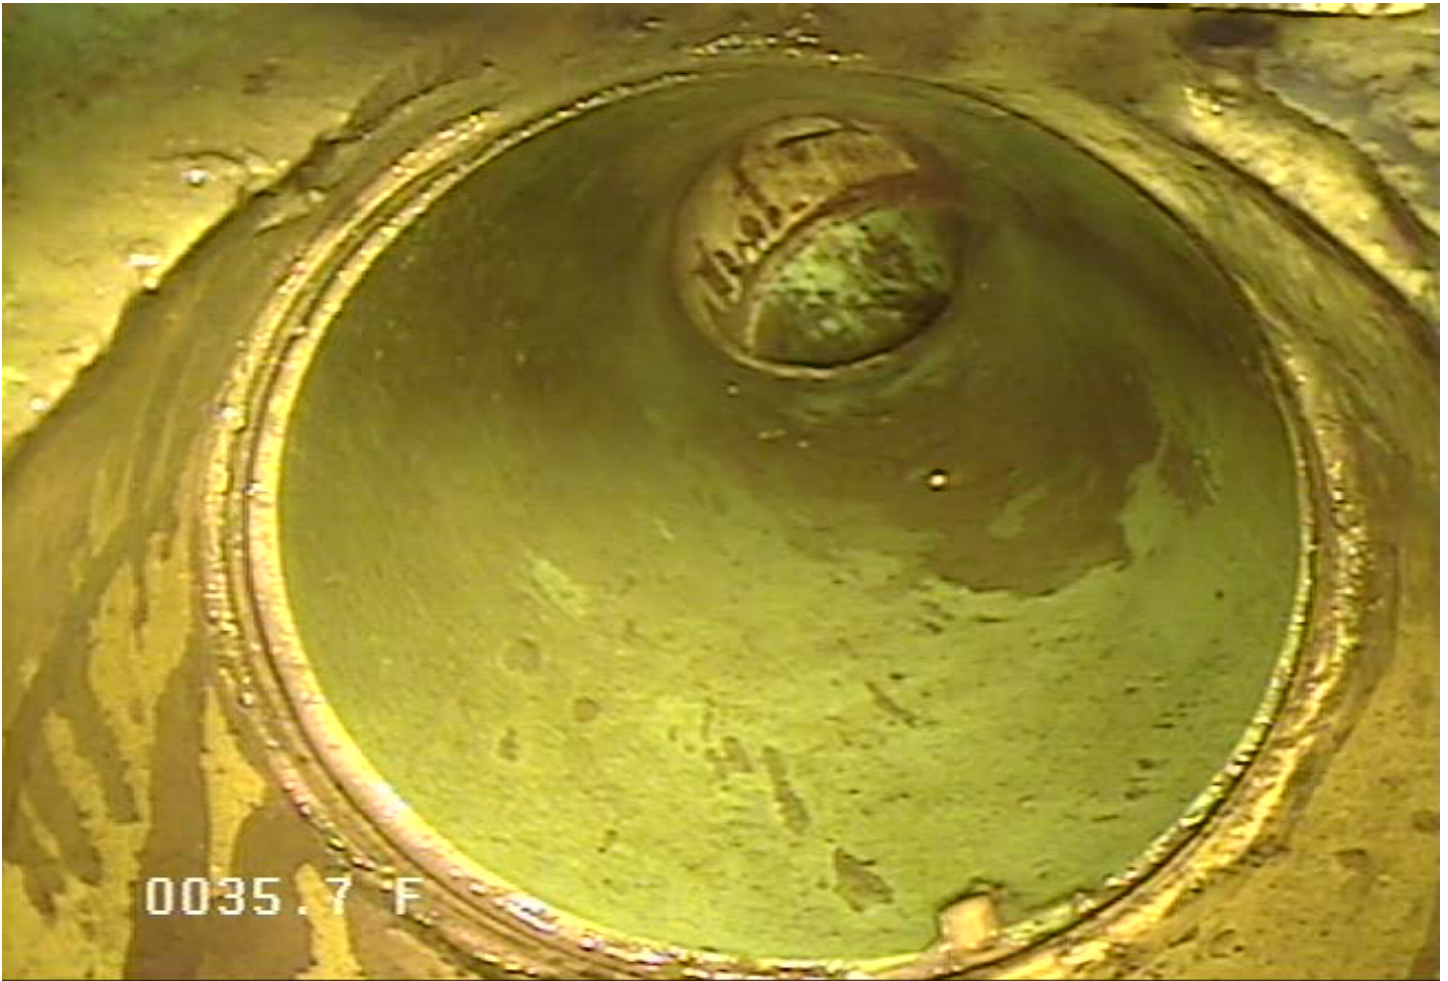

SC - Service Connection @ 35.7 ft.






248 Railroad Drive  
Elk River, MN 55330  
Phone: 763-635-1170

<b>Owner</b>	<b>Pipe Number</b>	<b>Upstream MH</b>	<b>Downstream MH</b>	<b>Date</b>			
City of Elk River	P28	60	59	13-Mar-2023			
<b>Surveyor</b>	<b>Street</b>	<b>City</b>	<b>Time</b>				
Andy and Chris	Boston	Elk River	1:58 PM				
<b>Size</b>	<b>Material</b>	<b>Sewer Use</b>	<b>Purpose</b>	<b>Length</b>	<b>(TV'd)</b>	<b>Pre-Clean</b>	<b>Weather</b>
8	PVC	Sanitary	Annual Review	296.574 7	480.6	No Pre-Cleaning	Dry

**Comments**

P28

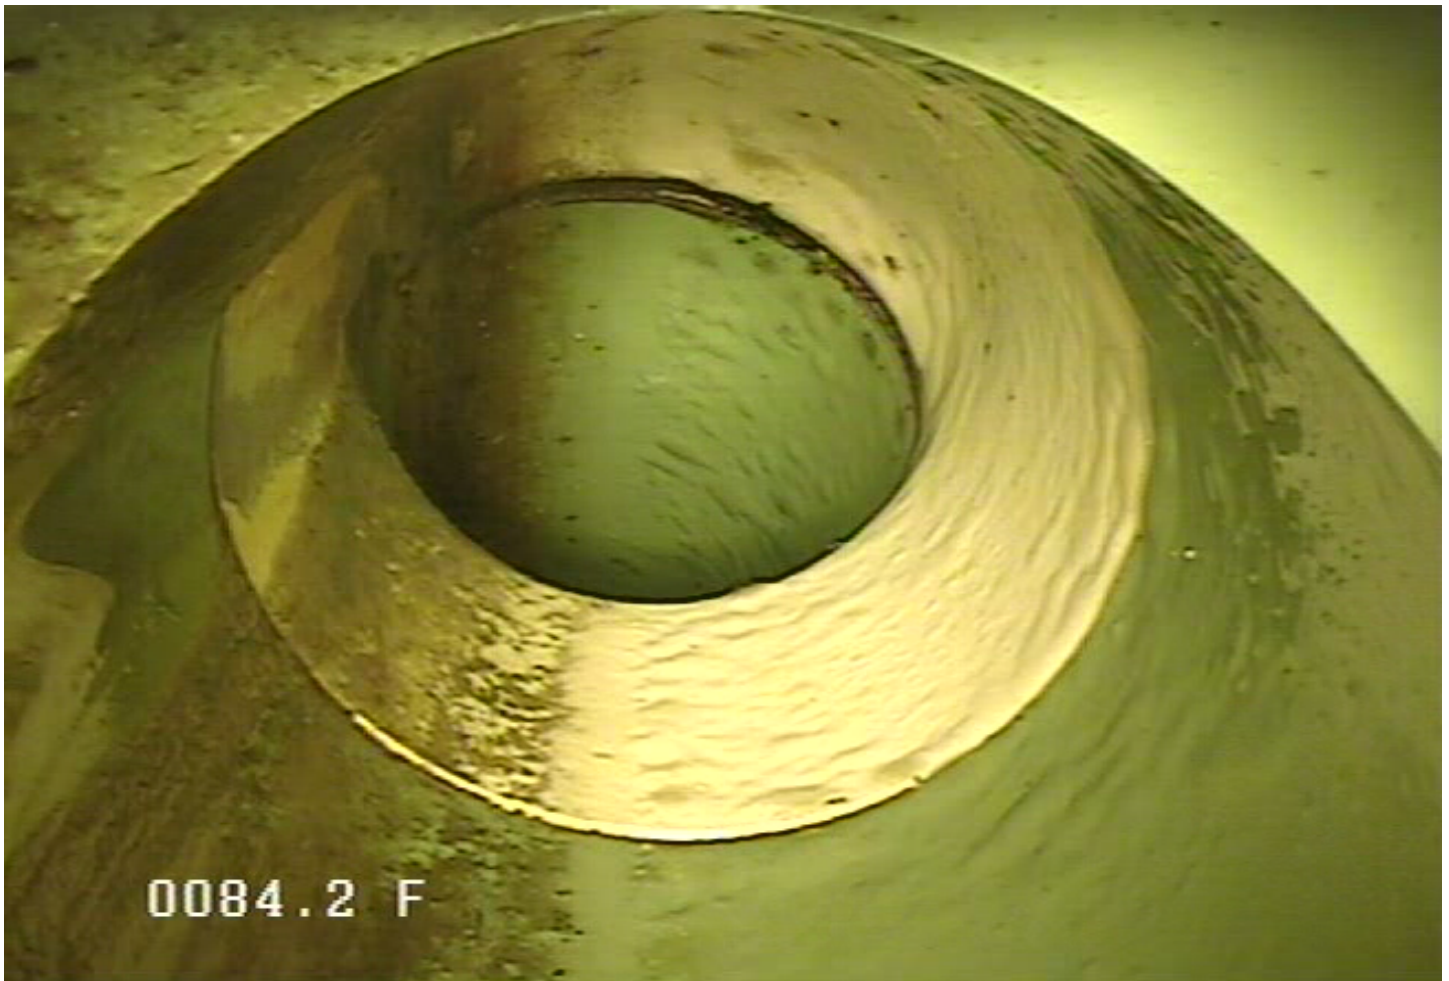

SC - Service Connection @ 84.2 ft.




248 Railroad Drive  
Elk River, MN 55330  
Phone: 763-635-1170

<b>Owner</b>	<b>Pipe Number</b>	<b>Upstream MH</b>	<b>Downstream MH</b>	<b>Date</b>			
City of Elk River	P28	60	59	13-Mar-2023			
<b>Surveyor</b>	<b>Street</b>	<b>City</b>	<b>Time</b>				
Andy and Chris	Boston	Elk River	1:58 PM				
<b>Size</b>	<b>Material</b>	<b>Sewer Use</b>	<b>Purpose</b>	<b>Length</b>	<b>(TV'd)</b>	<b>Pre-Clean</b>	<b>Weather</b>
8	PVC	Sanitary	Annual Review	296.574 7	480.6	No Pre-Cleaning	Dry

**Comments**

P28
-----

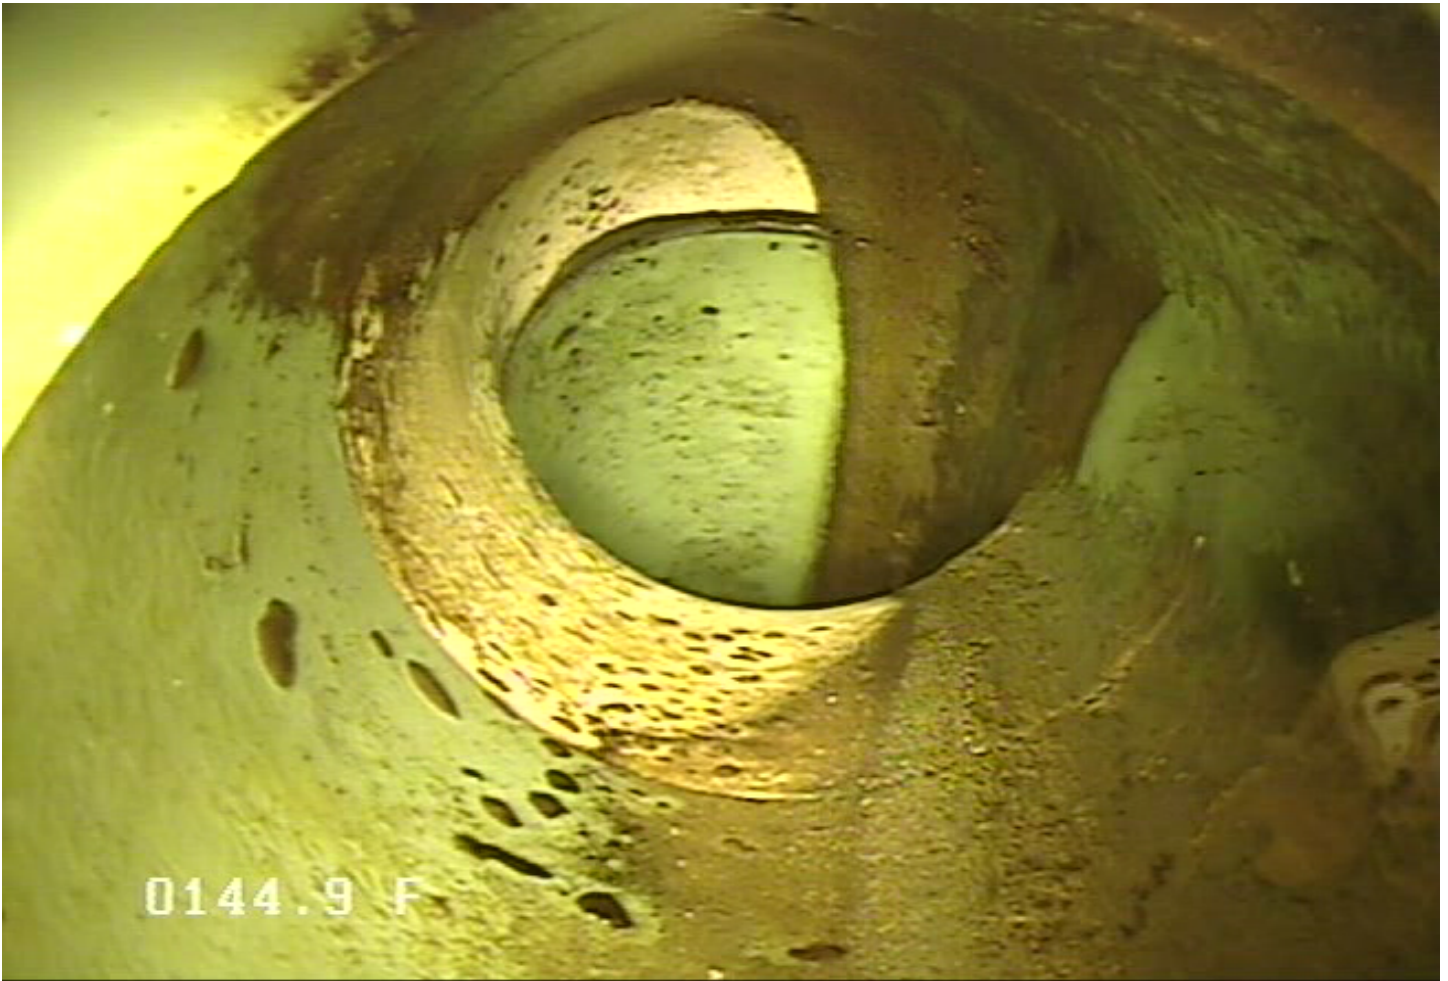

SC - Service Connection @ 144.9 ft.





248 Railroad Drive  
Elk River, MN 55330  
Phone: 763-635-1170

<b>Owner</b>	<b>Pipe Number</b>	<b>Upstream MH</b>	<b>Downstream MH</b>	<b>Date</b>			
City of Elk River	P28	60	59	13-Mar-2023			
<b>Surveyor</b>	<b>Street</b>	<b>City</b>	<b>Time</b>				
Andy and Chris	Boston	Elk River	1:58 PM				
<b>Size</b>	<b>Material</b>	<b>Sewer Use</b>	<b>Purpose</b>	<b>Length</b>	<b>(TV'd)</b>	<b>Pre-Clean</b>	<b>Weather</b>
8	PVC	Sanitary	Annual Review	296.574 7	480.6	No Pre-Cleaning	Dry

**Comments**

P28
-----



SC - Service Connection @ 230.2 ft.




248 Railroad Drive  
Elk River, MN 55330  
Phone: 763-635-1170

<b>Owner</b> City of Elk River	<b>Pipe Number</b> P28	<b>Upstream MH</b> 60	<b>Downstream MH</b> 59	<b>Date</b> 13-Mar-2023			
<b>Surveyor</b> Andy and Chris	<b>Street</b> Boston		<b>City</b> Elk River	<b>Time</b> 1:58 PM			
<b>Size</b> 8	<b>Material</b> PVC	<b>Sewer Use</b> Sanitary	<b>Purpose</b> Annual Review	<b>Length</b> 296.574 7	<b>(TV'd)</b> 480.6	<b>Pre-Clean</b> No Pre-Cleaning	<b>Weather</b> Dry

**Comments**

P28

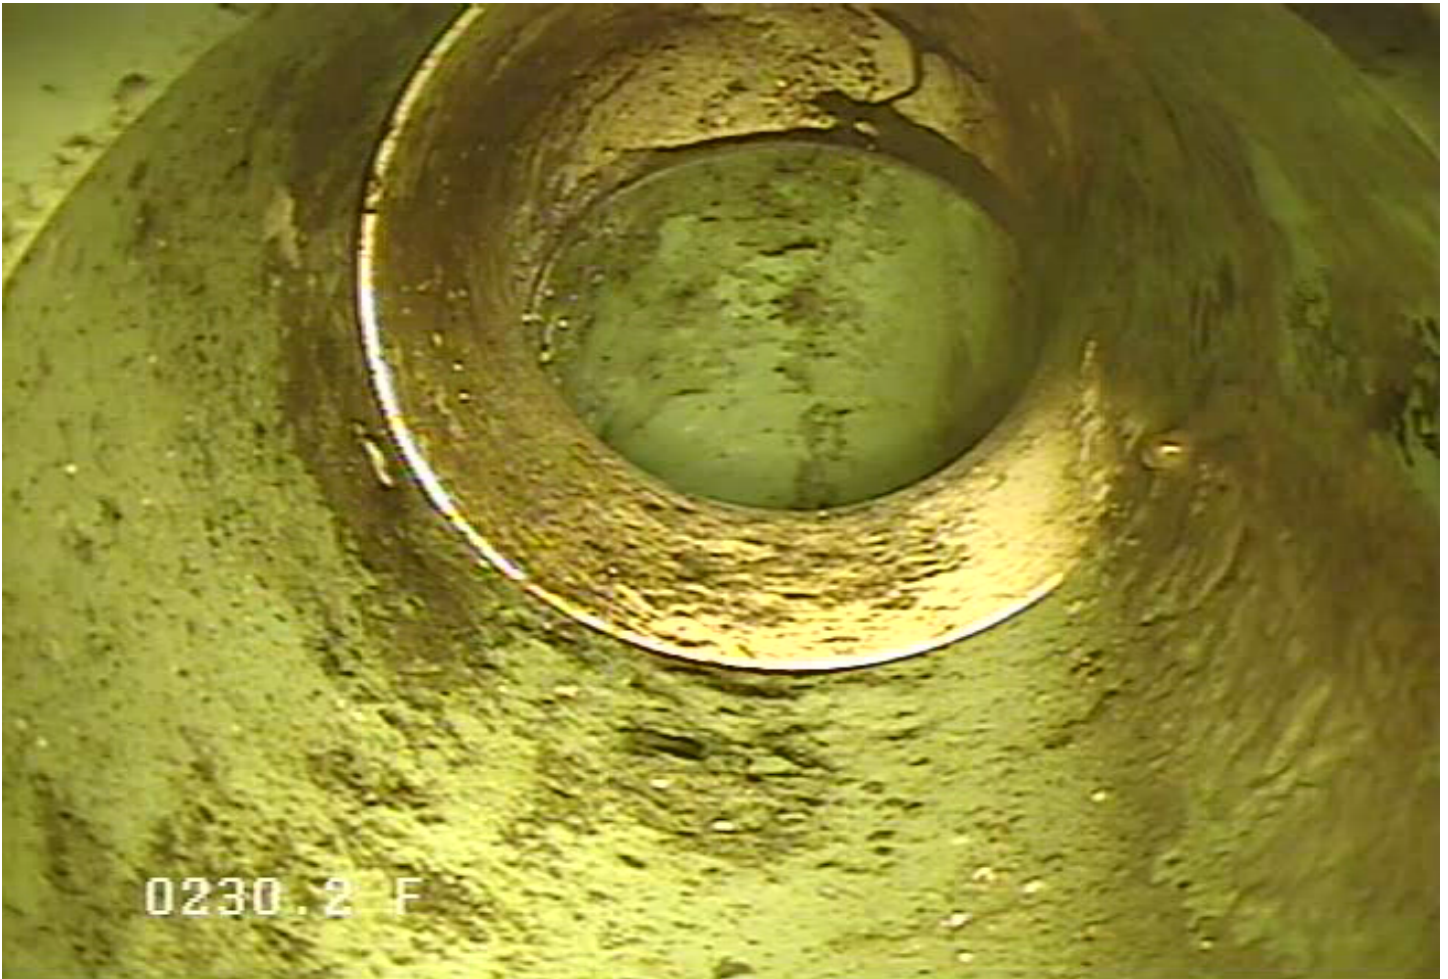

SC - Service Connection @ 289.2 ft.






248 Railroad Drive  
Elk River, MN 55330  
Phone: 763-635-1170

<b>Owner</b>	<b>Pipe Number</b>	<b>Upstream MH</b>	<b>Downstream MH</b>	<b>Date</b>
City of Elk River	P28	60	59	13-Mar-2023
<b>Surveyor</b>	<b>Street</b>			<b>City</b>
Andy and Chris	Boston			Elk River
<b>Time</b>	<b>Size</b>	<b>Material</b>	<b>Sewer Use</b>	<b>Purpose</b>
1:58 PM	8	PVC	Sanitary	Annual Review
				<b>Length</b>
				296.574
				7
				<b>(TV'd)</b>
				480.6
				<b>Pre-Clean</b>
				No Pre-Cleaning
				<b>Weather</b>
				Dry

#### Comments

P28
-----

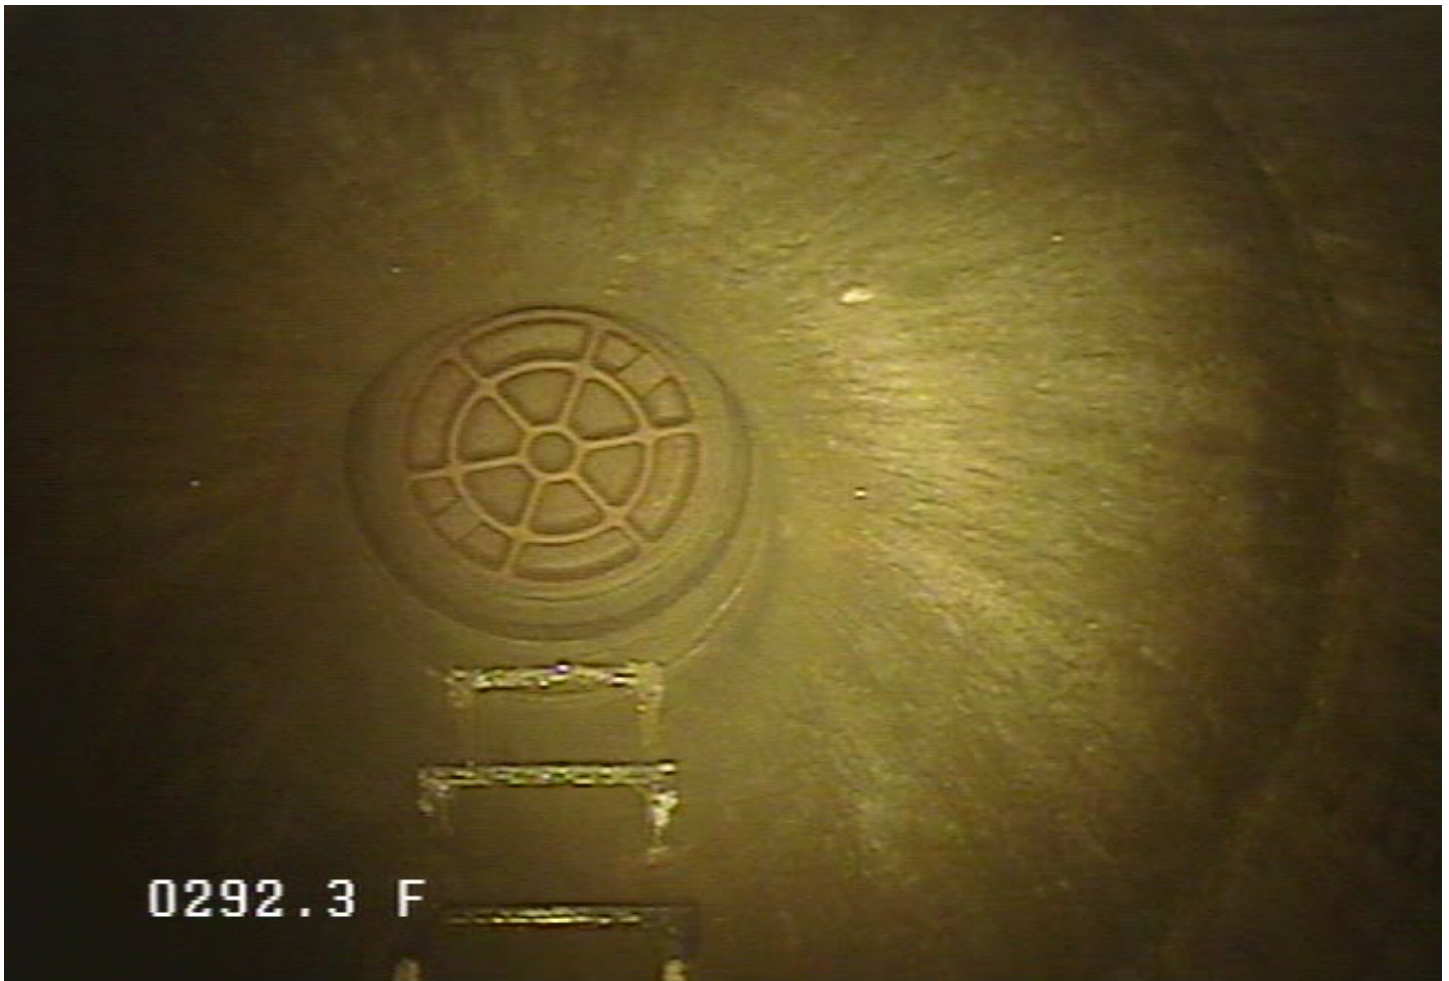

MH - Manhole @ 292.3 ft.



248 Railroad Drive  
Elk River, MN 55330  
Phone: 763-635-1170

<b>Owner</b> City of Elk River	<b>Pipe Number</b> P28	<b>Upstream MH</b> 60	<b>Downstream MH</b> 59	<b>Date</b> 13-Mar-2023			
<b>Surveyor</b> Andy and Chris	<b>Street</b> Boston			<b>City</b> Elk River	<b>Time</b> 1:58 PM		
<b>Size</b> 8	<b>Material</b> PVC	<b>Sewer Use</b> Sanitary	<b>Purpose</b> Annual Review	<b>Length</b> 296.574 7	<b>(TV'd)</b> 480.6	<b>Pre-Clean</b> No Pre-Cleaning	<b>Weather</b> Dry

**Comments**

P28



MH - Manhole @ 480.6 ft.



248 Railroad Drive  
Elk River, MN 55330  
Phone: 763-635-1170

<b>Owner</b> City of Elk River	<b>Pipe Number</b> P28	<b>Upstream MH</b> 60	<b>Downstream MH</b> 59	<b>Date</b> 13-Mar-2023			
<b>Surveyor</b> Andy and Chris	<b>Street</b> Boston		<b>City</b> Elk River	<b>Time</b> 1:58 PM			
<b>Size</b> 8	<b>Material</b> PVC	<b>Sewer Use</b> Sanitary	<b>Purpose</b> Annual Review	<b>Length</b> 296.574 7	<b>(TV'd)</b> 480.6	<b>Pre-Clean</b> No Pre-Cleaning	<b>Weather</b> Dry

**Comments**

P28



IE - End Inspection @ 480.6 ft.





248 Railroad Drive  
Elk River, MN 55330  
Phone: 763-635-1170

<b>Owner</b> City of Elk River	<b>Pipe Number</b> P28	<b>Upstream MH</b> 60	<b>Downstream MH</b> 59	<b>Date</b> 13-Mar-2023			
<b>Surveyor</b> Andy and Chris	<b>Street</b> Boston		<b>City</b> Elk River	<b>Time</b> 1:58 PM			
<b>Size</b> 8	<b>Material</b> PVC	<b>Sewer Use</b> Sanitary	<b>Purpose</b> Annual Review	<b>Length</b> 296.574 7	<b>(TV'd)</b> 480.6	<b>Pre-Clean</b> No Pre-Cleaning	<b>Weather</b> Dry

#### Comments

P28

